

100

Rec'd in Office

137

Nov 4th 1861

137A

Field notes of the exterior boundary lines of Township No 3 N R 31

and of Township No 5 N R 30 East of the Willamette Meridian surveyed by Dolphus S. Payne, ^{deputy surveyor} under his Contract No 100 dated August 1st 1861

Town 3 N R 31

Commenced August 20th 1861

Completed August 23rd 1861

Town 5 N R 30

Commenced September 17th 1861

Completed September 17, 1861


80
5-90
74-10

138

138A

Index

Exterior boundaries, T3NR30E and T5NR30E

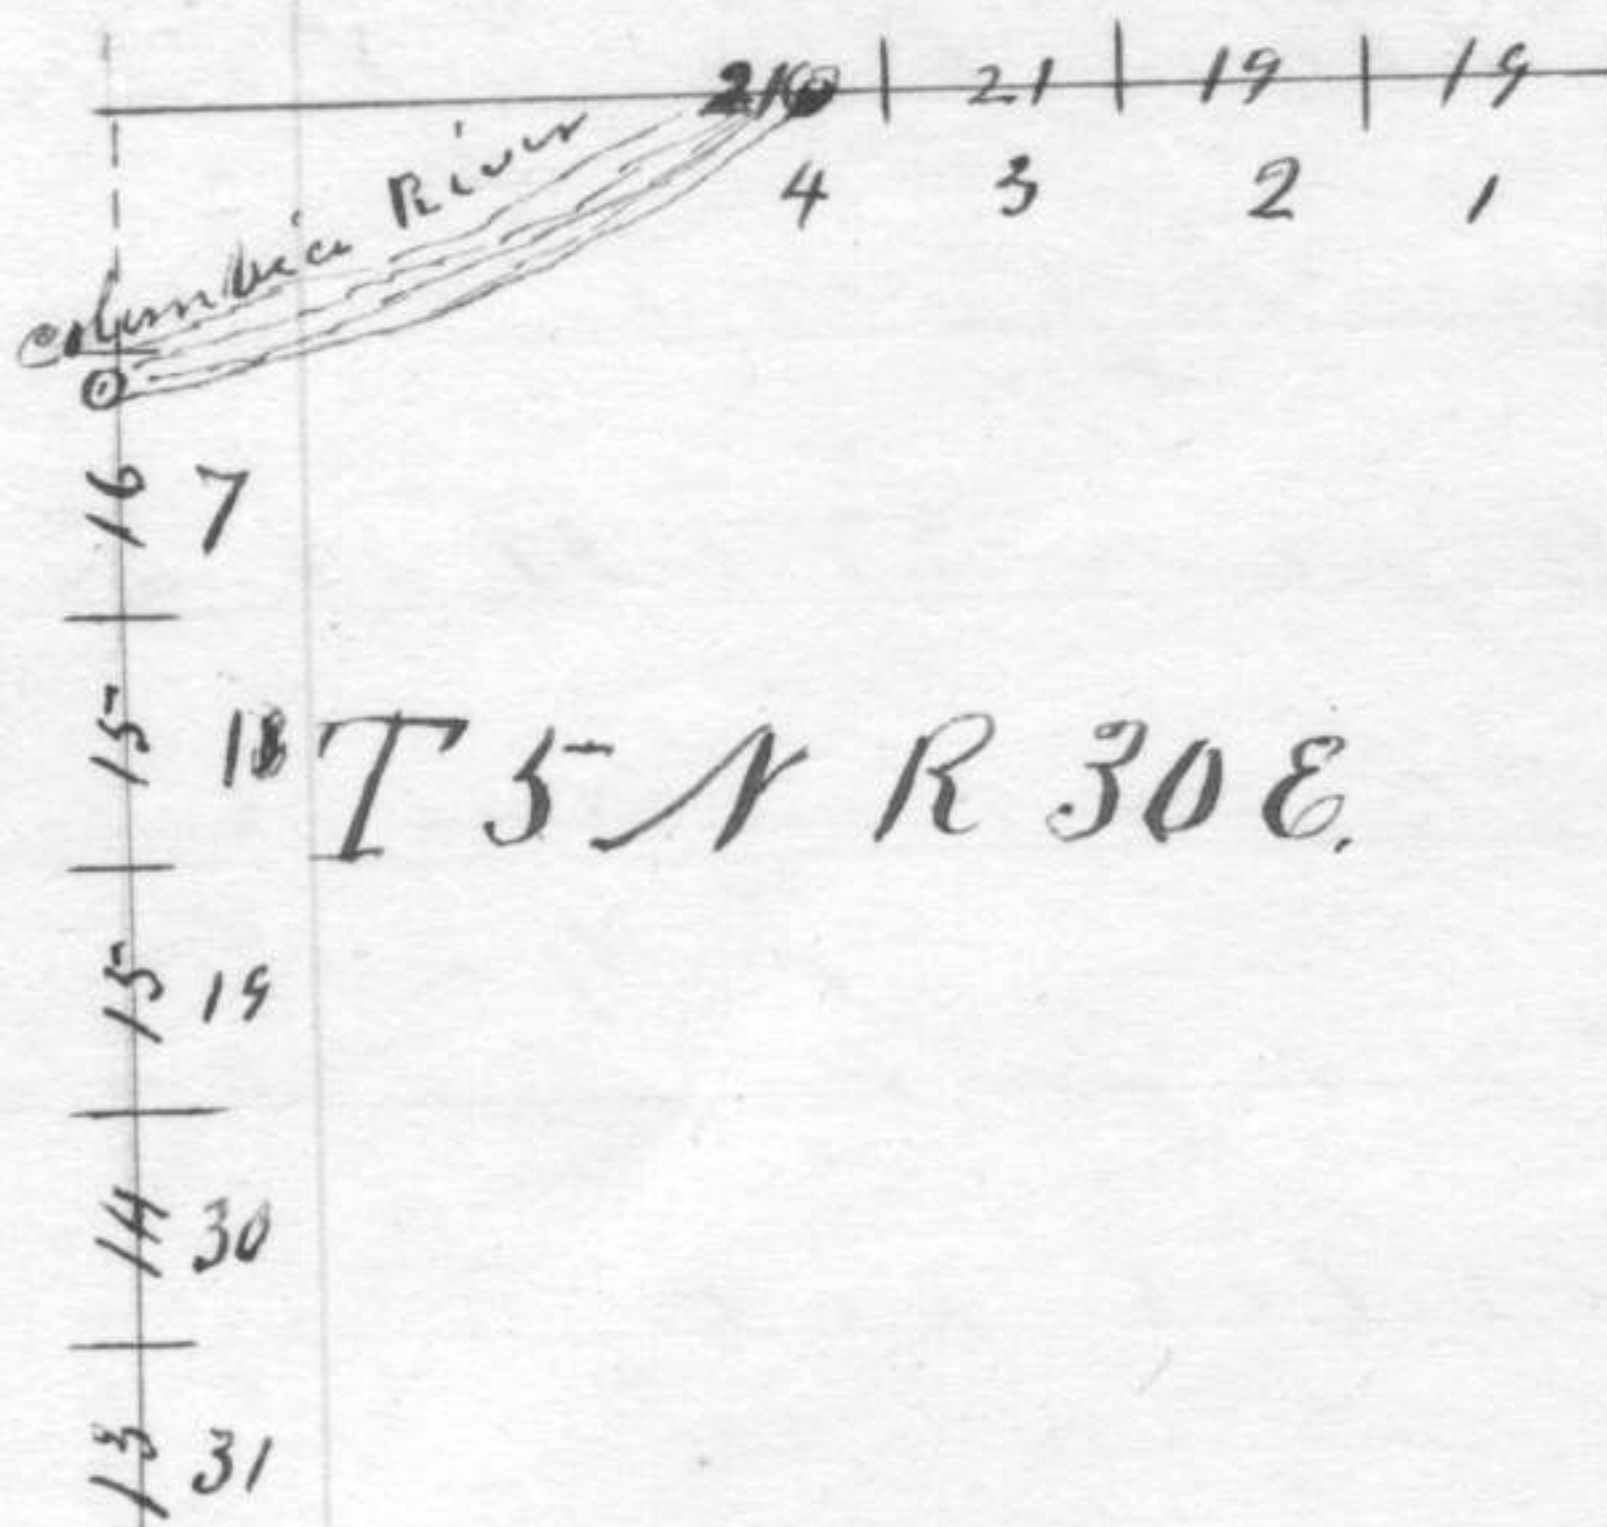


T4NR30E.

4N31E

3NR30E

T3NR31E

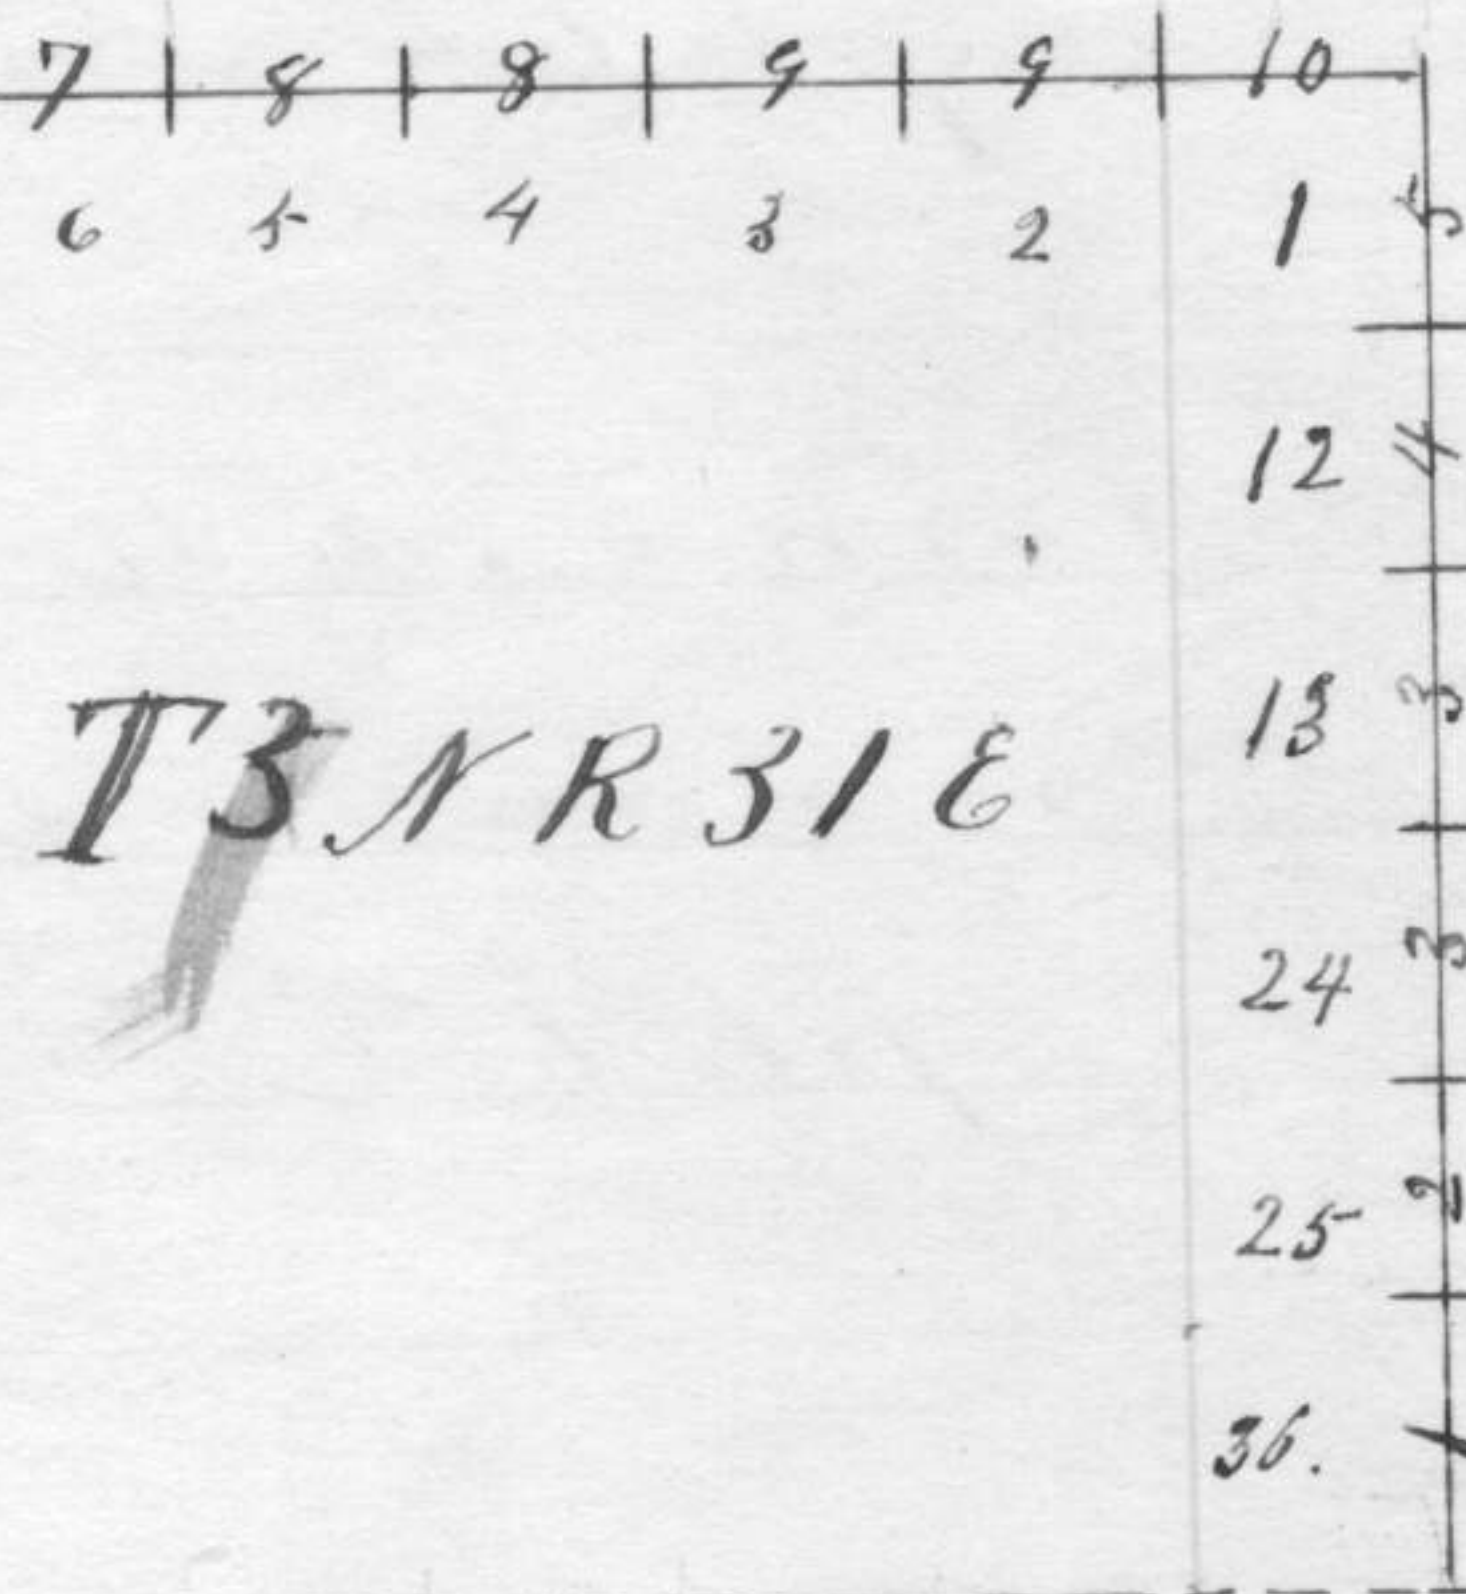

4N29

State of Oregon }
 County of Wasco } ss: We, John Brattain

William B. Pengra, having been
 appointed Chairman in the service
 of A. S. Payne, deputy surveyor of the
 lands of the United States in Oregon
 do solemnly swear that we will
 faithfully execute the duties of
 Chain Carriers; - that we will
 level the chain upon uneven
 ground and plumb the tally
 pins whether by sticking or drop-
 ping the same; that we will
 report the true distance to all
 notable objects and the true
 length of all lines that we
 assist in measuring to the
 best of our skill and ability.

Subscribed & sworn }
 before me this 12th }
 day of August 1861 }
 W. C. Murray }
 County Clerk }

John Brattain
 Wm B Pengra

140

140A

State of Oregon }
County of Wasco } ss:

The John L.
Luc Key, & Benjamin F. Crow having
been appointed axemen in the
service of A. S. Payne, deputy surveyor
of the lands of the United States in
Oregon do solemnly swear that
we will perform the duties of
axeman or flagmen according
to instructions given us and to
the best of our skill and ability.

Subscribed & sworn to }
before me this 12th }
day of August 1861 }

Jno L. Lenokey
B. F. Crow,

W. C. Murray
County Clerk

Township 5 N R 30 E 159

Chains

North boundary, T 5 N R 30 E. Beginning at the corner of Townships 5 & 6 North, Ranges 30 & 31 East, Var 20° E.

West on true line North boundary Sec 1 T 5 N R 30 E.

40.00 Set-charged stake with mound trench and pits as per instrs. for q^r sec corner.

80.00 Set-charged stake with mound trench and pits as per instrs. for corner to Secs. 1 & 2 T 5 N and 33 & 36 T 6 N R 30 E. - Var 20° E

West on true line North boundary Sec 2 T 5 N R 30 E.

40.00 Set-charged stake with mound trench and pits as per instrs. for q^r sec corner.
80.00 Set-charged stake with mound trench & pits as per instrs. for corner to Secs 2 & 3

160

160

27

North Boundary

ChainsT5 N and Secs 34 & 35 T6 N.
Var $20^{\circ} 15' E$

West on true line North boundary

Sec 3 T5 N R 30 E.

3.75 Iron nail N $40^{\circ} E$.40.00 Set Charred Stake with mound
trench and pits as per notes,
for gr sec corner.42.08 Ascend rocky bluff, bank
about 20 feet high, N & S.61.50 Descend rocky bluff about
40 feet high, (S $70^{\circ} W$).73.00 Descend rocky bluff about
70 feet high (S $70^{\circ} W$) from
this point to the river
very steep and broken.77.00 descend rocky bluff
about 30 feet high.86.00 Set Charred Stake with
mound of rocks trench

Township 3 N R 30 E

Cherms

and pits as per ins'ts,
for corner to Sec 344 T 3
N and 33 & 34 T 6 N
Cor 21 E

Met on true line North boundary

Sec 4 T 5 N R 30 E -

3.15 Cliff 50 feet high

4.15 Trail N 38 1/2° E -

4.30 River bank. Set meander

post with rock mound -
digging trench or pits being
impracticable on account
of rock.

Cor 19° 30' E -

General Description.

This Township contains
some of the best land.

170

170

Soil generally good, Timber
scarcely - found only along
the Columbia River. But
for grazing purposes
it is unsurpassed &
should therefore be
subdivided

List of Names.

A list of the names of the
individuals employed in
renewing measuring or
marking the lines and
corners described in
the foregoing field notes
of the ~~of~~ Lewis' Bounda-
ry lines of Township
N 3 North Range 31
East, and of township
N 5 North R. 30 East

of the Willamette Meridian
Showing the respective Ca-
pacities in which they
were

John Bratten Chairman
William B. Payne, Chairman
John L. Luckey, Assessor,

We hereby certify that we
assisted Joseph S. Payne
deputy Surveyor in Sur-
veying the exterior bound-
ary lines of Township
No 3 North Range 31 East
and of Township No 5
North Range 30 East of
the Willamette Meridian
and that said lines
have been in all respects

172

172

to the best of our knowledge
and belief well and
faithfully surveyed and
the boundary monuments
planted according to the
instructions furnished
by the Surveyor General.

John Brattain, Chairman
W. B. Penner, Chairman
John L. Luekey Assessor

Subscribed and sworn by the
above named persons before me
a Justice of the Peace in & for
the County of Lane State of
Oregon, this 1st day of November
A.D. 1861

R. O. Parsons
Justice Peace

I Dolphus S. Payne, deputy
surveyor do solemnly swear
that, in pursuance of a contract
with B. J. Pendra Surveyor of the
public lands of the United States
in the State of Oregon bearing
date the First day of August
1861, and in strict conformity
to the laws of the United States
and the instructions furnished
by the said Surveyor General, I
have faithfully surveyed the
exterior boundaries of Townships
Numbers three and five north
of the base line of Range Number
thirty & thirty one East of the
Millomata Meridian in the State
aforesaid, and do further solemnly
swear that the foregoing are the true
and original field notes of such
survey.

Dolphus S. Payne

174
174

The foregoing affidavit was
subscribed and sworn before me
this 4th day of November A.D. 1861

B. P. Pringle
Surreal General
of Oregon

175
175

Surveyors Office at
C Eugene City Dec 5th 1861

The foregoing field notes of the
Survey of the exterior boundaries
of Townships 3 & 5 North of the
base line of Ranges Nos 30 & 31
East of the Willamette Meri-
dian in the State of Oregon
executed by Dolphus Payne
under his Contract No 105 da-
ted August 1st 1861 having
been critically examined the
necessary corrections & explanations
made the said field notes
and the surveys they de-
scribe are hereby approved

J. P. Sargent
Surveyor General