

Form 9600-9  
(December 1979)  
(formerly 9180-6)

UNITED STATES  
DEPARTMENT OF THE INTERIOR  
BUREAU OF LAND MANAGEMENT

R622

FIELD NOTES

818 217

OF THE

DEPENDENT RESURVEY OF

A PORTION OF THE WEST AND NORTH BOUNDARIES

AND

SUBDIVISIONAL LINES,

AND

SUBDIVISION OF SECTIONS 2, 3, 4, 6, 7, AND 8,

TOWNSHIP 5 NORTH, RANGE 31 EAST,

Of the WILLAMETTE Meridian,

In the State of OREGON

EXECUTED BY

William D. Kimmel, Cadastral Surveyor

Under special instructions dated May 14, 1980, approved May 15, 1980

Number 1015, which provided for the surveys included under U.S. Survey/Group  
and assignment instructions dated May 20, 1980.

Survey commenced June 9, 1980

Survey completed April 23, 1981

R055  
218

# FIELD NOTES

## INDEX DIAGRAM

Township 5 North, Range 31 East  
12                      11                      10                      9                      7

6	6	27	5	22	4	18	3	15	2	13	1
	26		26		21		16		14		
5	7	24	8	19	9		10		11		12
			23								
2	18		17		16		15		14		13
	19		20		21		22		23		24
	30		29		28		27		26		25
	31		32		33		34		35		36

Subdivision of section 2 . . . . .	pgs. 28 - 31
Subdivision of section 3 . . . . .	pgs. 31 - 33
Subdivision of section 4 . . . . .	pgs. 33 - 36
Subdivision of section 6 . . . . .	pgs. 36 - 37
Subdivision of section 7 . . . . .	pgs. 37 - 40
Subdivision of section 8 . . . . .	pgs. 40 - 43

## T. 5 N., R. 31 E., Willamette Meridian, Oregon

## CHAINS

The following field notes are those of the dependent resurvey of a portion of the west and north boundaries and subdivisional lines and subdivision of sections 2, 3, 4, 6, 7, and 8, Township 5 North, Range 31 East, Willamette Meridian, Oregon.

The history of surveys pertaining to this resurvey, is as follows:

The west boundaries of T. 4 N., R. 31 E., and T. 5 N., R. 31 E., were surveyed by David P. Thompson in 1859.

The south boundary (First Standard Parallel North) of T. 5 N., R. 30 E., was surveyed by H. J. G. Maxon and Jared S. Hurd in 1860.

The subdivisional lines of T. 4 N., R. 30 E., and the north boundary and subdivisional lines of T. 5 N., R. 30 E., were surveyed by Dolphus S. Payne in 1861. During the course of these surveys, Payne retraced the line between sections 19 and 24 on the east boundary of T. 5 N., R. 30 E., and the lines between sections 19 and 24, and sections 7 and 12, on the east boundary of T. 4 N., R. 30 E. Payne established new section corners along the north 3 miles of the east boundary of T. 4 N., R. 30 E., and tied in the old Thompson corners.

The south (First Standard Parallel North), east, and north boundaries of T. 5 N., R. 31 E., were surveyed by William H. Odell and William S. Lewis in 1865.

The south (First Standard Parallel North), east, and north boundaries were retraced and the subdivisional lines of T. 5 N., R. 31 E., were surveyed by Nicholas O. Walden in 1874.

The north boundary of T. 5 N., R. 30 E., was resurveyed by Charles M. Collier in 1911.

The survey was executed in accordance with the specifications as set forth in the Manual of Surveying Instructions, 1973, and the Special Instructions dated May 14, 1980, under Group No. 1015, Oregon.

The directions of the lines were determined by deflections from azimuths obtained by direct solar observations.

Preliminary to the resurvey, the lines of the original survey were retraced and search was made for all corners and other calls of the record. Identified corners were remonumented in their original positions. Lost corners were reestablished and remonumented at proportionate positions based on the official record. The retracement data were thoroughly verified and only the true line field notes are given herein. All lines not forming a closure were measured twice.

Detectable Electronically Energized Particles (DEEP-1 TM) were used to reference certain corner monuments buried under the surface of cultivated land. The Deep-1 is composed of strontium encased in a color coded plastic container. The units are 1 inch in diameter, 2½ inches long, weigh 2½ ounces, and are magnetically detectable to an average buried depth of 8 feet.

The geographic position of the corner of sections 8, 9, 16, and 17, as computed from a direct tie made to the United States Coast and Geodetic Survey triangulation station "JINGLE 1956", is as follows:

## T. 5 N., R. 31 E., Willamette Meridian, Oregon

## CHAINS

Latitude  $45^{\circ} 55' 16.8''$  N. Longitude  $118^{\circ} 57' 10.7''$  W.

The mean magnetic declination is  $20^{\circ}$  E.

Dependent Resurvey of a Portion of the West Boundary,  
T. 5 N., R. 31 E., Willamette Meridian, Oregon

(Restoring the survey by David P. Thompson, U.S. Deputy Surveyor, in 1859, the survey by H. J. G. Maxon and Jared S. Hurd, U.S. Deputy Surveyors, in 1860, the survey and retracement by Dolphus S. Payne, U.S. Deputy Surveyor, in 1861, the survey by William H. Odell and William S. Lewis, U.S. Deputy Surveyors, in 1865, the retracement by Nicholas O. Walden, U.S. Deputy Surveyor, in 1874, and the resurvey by Charles M. Collier, U.S. Surveyor, in 1911)

Beginning at the point for the cor. of secs. 13, 18, 19, and 24, determined by the irregular boundary method; there is no remaining evidence of the original corner.

Set an iron post, 28 ins. long,  $2\frac{1}{2}$  ins. diam., 43 ins. in the ground, the top 15 ins. below the surface of cultivated field, with brass cap mkd.

T 5 N	
R 30 E	R 31 E
S 13	S 18
S 24	S 19

1980

from which

An iron post, 28 ins. long,  $2\frac{1}{2}$  ins. diam., set 22 ins. in the ground, for a reference monument, bears N.  $35^{\circ}$  W., 689 lks. dist., with brass cap mkd. T5N R30E S13 RM 455 FT 1980 with an arrow pointing to the corner.

An iron post, 28 ins. long,  $2\frac{1}{2}$  ins. diam., set 22 ins. in the ground, for a reference monument, bears N.  $68^{\circ}$  W., 682 lks. dist., with brass cap mkd. T5N R30E S13 RM 450 FT 1980 with an arrow pointing to the corner.

The corner of fences, extending N.  $40^{\circ}$  E. and W., bears N.  $68^{\circ}$  W., 974 lks. dist.

A yellow "Deep 1" magnetic marker, buried 2 ft. in the ground, bears N.  $45^{\circ}$  E., 25 lks. dist.

A red "Deep 1" magnetic marker, buried 2 ft. in the ground, bears S.  $45^{\circ}$  E., 25 lks. dist.

A blue "Deep 1" magnetic marker, buried 2 ft. in the ground, bears S.  $45^{\circ}$  W., 25 lks. dist.

An orange "Deep 1" magnetic marker, buried 2 ft. in the ground, bears N.  $45^{\circ}$  W., 25 lks. dist.

From this point, the point for the standard cor. of Tps. 4 and 5 N., Rs. 30 and 31 E., bears S.  $0^{\circ} 08' E.$ , 240.77 chs. dist., at proportionate distance; there is no remaining evidence of the original corner.

Dependent Resurvey, Portion of the N. Bdy.,  
T. 5 N., R. 31 E., Willamette Mer., Oregon

CHAINS	
	<p style="text-align: center;">T 6 N R 31 E S 31 <math>\frac{1}{4}</math> S 6 T 5 N 1980</p> <p>from which</p> <p>A juniper, 6 ins. diam., bears S. 62° W., 323 lks. dist., mkd. T5N R31E S6 BT.</p> <p>A juniper, 5 ins. diam., bears N. 9° W., 370 lks. dist., mkd. X BT.</p> <p>Descend 10 ft. over SW. slope.</p> <p>40.40 Juniper Creek, dry, 15 lks. wide, drains W. turning NW.; asc. 350 ft. over NE. slope.</p> <p>50.60 High voltage power transmission line, bears N. 40° E. and S. 40° W.</p> <p>57.00 Top of steep ascent; asc. 160 ft. over rolling land.</p> <p>80.43 The cor. of Tps. 5 and 6 N., Rs. 30 and 31 E., hereinbefore described.</p> <p>Land, mountainous. Soil, sandy. Vegetation, sagebrush and widely scattered juniper.</p> <hr/> <p style="text-align: center;">Dependent Resurvey of a Portion of the Subdivisional Lines, T. 5 N., R. 31 E., Willamette Meridian, Oregon</p> <p style="text-align: center;">(Restoring the survey by Nicholas O. Walden, U.S. Deputy Surveyor, in 1874)</p> <p>From the cor. of secs. 1, 2, 11, and 12, determined at the intersection of barbed wire fences, extending N. and E. This position is harmoniously related with identified existing corners in the area, has long been recognized by owners of the adjacent lands as the corner, and is accepted as the best available evidence of the position of the original corner.</p> <p>At the corner point</p> <p>Set an iron post, 28 ins. long, 2½ ins. diam., 24 ins. in the ground, in a mound of stone, 2 ft. base, to top, with brass cap mkd.</p> <p style="text-align: center;">T 5 N R 31 E S 2   S 1 ----- S 11   S 12</p> <hr/> <p style="text-align: center;">1980</p> <p>from which</p> <p>A power pole, with a metal tag mkd. PPL 0531 PPL 028270, bears N. 31 3/4° E., 543 lks. dist.</p>

232

Dependent Resurvey, Portion of Subdivisional Lines,  
T. 5 N., R. 31 E., Willamette Mer., Oregon

CHAINS

The NE. corner of a wood frame house, 26 x 48 ft., bears S. 39° 23' W., 313 lks. dist., the long side bears E. and W.

Set a 5½ ft. steel fence post alongside the iron post.

N. 0° 31' W., bet. secs. 1 and 2, marking the true line.

Descend 10 ft. over N. slope, across cultivated land, along fence line.

1.15 Gravelled road, 30 lks. wide, bears N. 45° E. and S. 50° W., also bottom of descent, slopes NE.; asc. 85 ft. over broken SE. slope.

11.00 Top of ascent, slopes E.; desc. 30 ft. over broken NE. slope.

38.70 Spur, slopes NE.; desc. slightly over N. slope.

39.90 Point for the ¼ sec. cor. of secs. 1 and 2, at proportionate distance; there is no remaining evidence of the original corner.

Set an iron post, 28 ins. long, 2½ ins. diam., 43 ins. in the ground, the top 15 ins. below the surface of cultivated field, with brass cap mkd.

T 5 N    R 31 E  
          ¼  
          S 2 | S 1

1980

from which

An iron post, 28 ins. long, 2½ ins. diam., set 22 ins. in the ground, for a reference monument, bears S. 45° W., 179 lks. dist., with brass cap mkd. T5N R31E ¼ S2 RM 118 FT 1980 and an arrow pointing to the corner.

An iron post, 28 ins. long, 2½ ins. diam., set 22 ins. in the ground, for a reference monument, bears N. 45° W., 197 lks. dist., with brass cap mkd. T5N R31E ¼ S2 RM 130 FT 1980 and an arrow pointing to the corner.

Descend 105 ft. over NW. slope.

50.75 Draw, drains NE.; asc. 85 ft. over broken SE. slope.

69.50 Top of ascent, slopes E.; desc. 80 ft. over N. slope.

78.51 The cor. of secs. 1, 2, 35, and 36, on the N. bdy. of the Tp.

Land, rolling hills.  
Soil, sandy.  
Vegetation, wheat.

From the cor. of secs. 1, 2, 11, and 12.

N. 88° 14' W., bet. secs. 2 and 11.

Ascend 185 ft. over SE. slope, across cultivated land.

Dependent Resurvey, Portion of Subdivisional Lines,  
T. 5 N., R. 31 E., Willamette Mer., Oregon

CHAINS	
1.30	Gravelled road, 30 lks. wide, bears N. 50° E. and S. 50° W.
20.00	Top of ascent, slopes S.; desc. 90 ft. over W. slope.
39.85	<p>The 1/4 sec. cor. of secs. 2 and 11, determined at intersection of barbed wire fences, extending S. and W. This position is harmoniously related with identified existing corners in the area, has long been recognized by owners of the adjacent lands as the corner, and is accepted as the best available evidence of the position of the original corner.</p> <p>At the corner point</p> <p>Set an iron post, 28 ins. long, 2 1/2 ins. diam., 20 ins. in the ground, with brass cap mkd.</p> <p style="text-align: center;">T 5 N R 31 E S 2 1/4 ————— S 11 1980</p> <p>Corner is located at bottom of descent, slopes SW.</p> <p>N. 88° 29' W., beginning new measurement.</p> <p>Ascend 90 ft. over SE. slope, along barbed wire fence.</p>
16.90	Top of ascent, slopes S.; desc. 160 ft. over W. slope.
19.85	Barbed wire fence, bears N. and S.
39.80	<p>The cor. of secs. 2, 3, 10, and 11, determined at intersection of barbed wire fences, extending E. and W. and remains of fence extending S. This position is harmoniously related with identified existing corners in the area, has long been recognized by owners of the adjacent lands as the corner, and is accepted as the best available evidence of the position of the original corner.</p> <p>At the corner point</p> <p>Set an iron post, 28 ins. long, 2 1/2 ins. diam., 22 ins. in the ground, with brass cap mkd.</p> <p style="text-align: center;">T 5 N R 31 E S 3   S 2 ----- S 10   S 11 1980</p> <p>Land, rolling hills. Soil, sandy. Vegetation, wheat.</p>
9.00	Ridge, bears NE. and SW.; desc. 115 ft. over N. slope.
	<p>N. 2° 27' W., bet. secs. 2 and 3.</p> <p>Ascend 55 ft. over SE. slope, across cultivated land.</p>

234

Dependent Resurvey, Portion of Subdivisional Lines,  
T. 5 N., R. 31 E., Willamette Mer., Oregon

<p>CHAINS 30.65</p>	<p>Bottom of descent, slopes SW., also dirt road, 10 lks. wide, bears N. 70° E. and S. 50° W.; asc. 70 ft. over S. slope.</p>		
<p>39.60</p>	<p>Point for the 1/4 sec. cor. of secs. 2 and 3, at proportionate distance; there is no remaining evidence of the original corner.</p> <p>Set an iron post, 28 ins. long, 2 1/2 ins. diam., 43 ins. in the ground, the top 15 ins. below the surface of cultivated field, with brass cap mkd.</p> <div style="text-align: center;"> <p>T 5 N R 31 E</p> <p>1/4</p> <table style="margin: auto;"> <tr> <td style="border-right: 1px solid black; padding: 0 5px;">S 3</td> <td style="border-right: 1px solid black; padding: 0 5px;">S 2</td> </tr> </table> <p>1980</p> </div> <p>from which</p> <p style="margin-left: 40px;">A red "Deep 1" magnetic marker, buried 2 ft. in the ground, bears S. 45° E., 25 lks. dist.</p> <p style="margin-left: 40px;">An orange "Deep 1" magnetic marker, buried 2 ft. in the ground, bears N. 45° W., 25 lks. dist.</p> <p>Corner is located in draw, drains S.</p> <p>Ascend 50 ft. over S. slope.</p>	S 3	S 2
S 3	S 2		
<p>44.20</p>	<p>Ridge, bears E. and W.; desc. 135 ft. over broken NW. slope.</p>		
<p>59.40</p>	<p>Point for the N 1/16 sec. cor. of secs. 2 and 3.</p> <p>Set an iron post, 28 ins. long, 2 1/2 ins. diam., 20 ins. in the ground, with brass cap mkd.</p> <div style="text-align: center;"> <p>N 1/16</p> <table style="margin: auto;"> <tr> <td style="border-right: 1px solid black; padding: 0 5px;">S 3</td> <td style="border-right: 1px solid black; padding: 0 5px;">S 2</td> </tr> </table> <p>1980</p> </div> <p>Set a 5 1/2 ft. steel fence post alongside the iron post.</p> <p>Descend 40 ft. over broken NW. slope.</p>	S 3	S 2
S 3	S 2		
<p>67.50</p>	<p>Bottom of descent, slopes NE., also dirt road, 20 lks. wide, bears N. 25° E. and S. 25° W.; asc. 40 ft. over broken S. slope.</p>		
<p>75.62</p>	<p>The cor. of secs. 2, 3, 34, and 35, on the N. bdy. of the Tp.</p> <p>Land, rolling hills. Soil, sandy. Vegetation, wheat.</p> <hr/> <p>From the cor. of secs. 2, 3, 10, and 11.</p> <p>S. 89° 50' W., bet. secs. 3 and 10.</p> <p>Ascend 75 ft. over E. slope, across cultivated land along barbed wire fence.</p>		
<p>8.60</p>	<p>Ridge, bears NE. and SW.; desc. 150 ft. over W. slope.</p>		



Dependent Resurvey, Portion of Subdivisional Lines,  
T. 5 N., R. 31 E., Willamette Mer., Oregon

CHAINS	
39.84	<p>Point for the ¼ sec. cor. of secs. 3 and 10, at proportionate distance; there is no remaining evidence of the original corner.</p> <p>Set an aluminum post, 28 ins. long, 2½ ins. diam., 46 ins. in the ground, the top 18 ins. below the surface of cultivated field, with aluminum cap mkd.</p> <p style="text-align: center;">T 5 N    R 31 E           S 3           ¼ —————                   S 10                   1980</p> <p>from which</p> <p>An iron post, 28 ins. long, 2½ ins. diam., set 22 ins. in the ground, in a mound of stone, 2 ft. base, to top, for a reference monument, bears N. 45° 00' E., 56 lks. dist., with brass cap mkd. T5N R31E ¼ S3 RM 37 FT 1980 and an arrow pointing to the corner.</p> <p>An iron post, 28 ins. long, 2½ ins. diam., set 22 ins. in the ground, in a mound of stone, 2 ft. base, to top, for a reference monument, bears N. 45° 00' W., 54½ lks. dist., with brass cap mkd. T5N R31E ¼ S3 RM 36 FT 1980 and an arrow pointing to the corner.</p> <p>A yellow "Deep 1" magnetic marker, buried 2 ft. in the ground, bears N. 45° E., 25 lks. dist.</p> <p>A blue "Deep 1" magnetic marker, buried 2 ft. in the ground, bears S. 45° W., 25 lks. dist.</p> <p>The corner of fences, extending E. and meandering S., bears N. 82° 34' W., 269 lks. dist.</p> <p>Descend 30 ft. over W. slope.</p>
42.65	Dirt road, 10 lks. wide, bears N. and S.
45.35	Draw, drains S. 25° W.; asc. 140 ft. over SE. slope.
58.60	Spur, slopes SW.; desc. 150 ft. over W. slope.
79.68	<p>Point for the cor. of secs. 3, 4, 9, and 10, at proportionate distance; there is no remaining evidence of the original corner.</p> <p>Set an iron post, 28 ins. long, 2½ ins. diam., 22 ins. in the ground, with brass cap mkd.</p> <p style="text-align: center;">T 5 N    R 31 E           S 4    S 3           S 9    S 10</p> <p>Set a 5½ ft. steel fence post alongside the iron post.</p> <p>From this point, the ¼ sec. cor. of secs. 9 and 10, bears S. 0° 13' E., 39.92 chs. dist., determined at the intersection of fences, extending S. and W. This point is harmoniously related with identified existing corners in the area, has long been recognized by owners of the</p>


236

Dependent Resurvey, Portion of Subdivisional Lines,  
T. 5 N., R. 31 E., Willamette Mer., Oregon

CHAINS

adjacent lands as the corner, and is accepted as the best available evidence of the position of the original corner.

At the corner point  
Set an iron post, 28 ins. long, 2½ ins. diam., 22 ins. in the ground, with brass cap mkd.

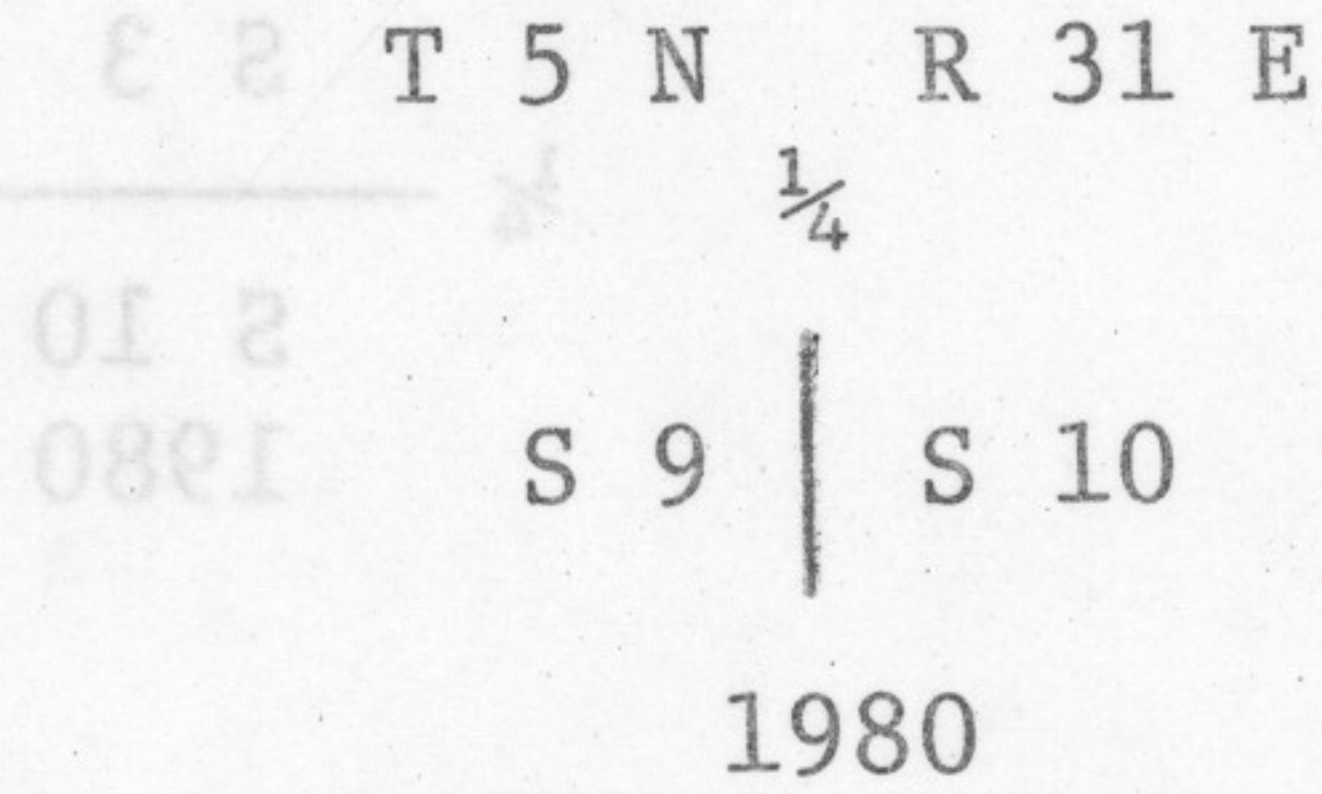

Land, rolling hills.  
Soil, sandy.  
Vegetation, wheat.

N. 3° 12' W., bet. secs. 3 and 4.

Ascend 50 ft. over SE. slope, across cultivated land.

13.00 Top of ascent, slopes SW.; desc. 130 ft. over NW. slope.


29.90 Draw, drains S. 55° W.; asc. 20 ft. over S. slope.

31.70 Ridge, bears N. 50° E. and S. 50° W.; desc. 30 ft. over N. slope.

36.20 Draw, drains W.; asc. 20 ft. over S. slope.

39.98 Point for the ¼ sec. cor. of secs. 3 and 4, at proportionate distance; there is no remaining evidence of the original corner.

Set an aluminum post, 28 ins. long, 2½ ins. diam., 22 ins. in the ground, with aluminum cap mkd.

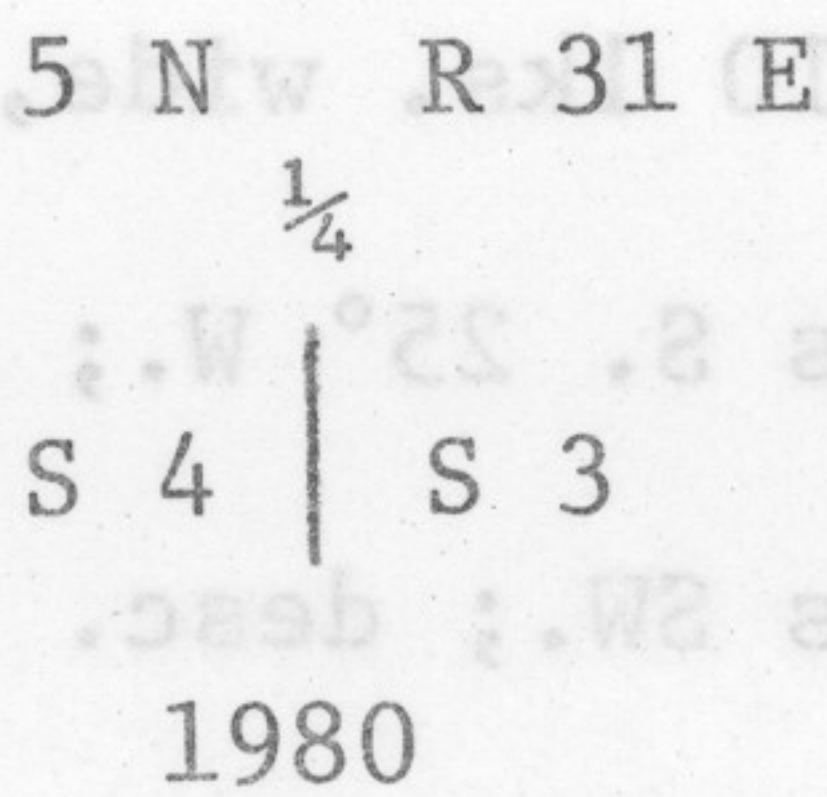

Set a 5½ ft. steel fence post alongside the aluminum post.

Corner is located on ridge, bears E. and W.; desc. 15 ft. over N. slope.

41.10 Draw, drains S. 70° W.; asc. 90 ft. over broken S. slope.

54.00 Top of ascent, slopes W.; desc. 50 ft. over NW. slope.

59.97 Point for the N 1/16 sec. cor. of secs. 3 and 4.

Set an aluminum post, 28 ins. long, 2½ ins. diam., 20 ins. in the ground, with aluminum cap mkd.

N 1/16



1980

Dependent Resurvey, Portion of Subdivisional Lines,  
T. 5 N., R. 31 E., Willamette Mer., Oregon


CHAINS																
	Set a 5½ ft. steel fence post alongside the aluminum post.															
	Descend 110 ft. over N. slope.															
70.00	Draw, drains S. 80° W.; asc. 45 ft. over S. slope.															
75.72	The cor. of secs. 3, 4, 33, and 34, on the N. bdy. of the Tp. Land, rolling hills. Soil, sandy. Vegetation, wheat and sagebrush.															
	From the point for the cor. of secs. 8, 9, 16, and 17, at proportionate distance; there is no remaining evidence of the original corner.															
	Set an aluminum post, 28 ins. long, 2½ ins. diam., 43 ins. in the ground, the top 15 ins. below the surface of a cultivated field, with aluminum cap mkd.															
	<table border="0" style="margin-left: auto; margin-right: auto;"> <tr><td></td><td>T 5 N</td><td>R 31 E</td></tr> <tr><td></td><td>S 8</td><td>S 9</td></tr> <tr><td colspan="3" style="text-align: center;">-----</td></tr> <tr><td></td><td>S 17</td><td>S 16</td></tr> <tr><td></td><td>1980</td><td>1980</td></tr> </table>		T 5 N	R 31 E		S 8	S 9	-----				S 17	S 16		1980	1980
	T 5 N	R 31 E														
	S 8	S 9														
-----																
	S 17	S 16														
	1980	1980														
	from which															
	An iron post, 28 ins. long, 2½ ins. diam., set 20 ins. in the ground, for a reference monument, bears S. 60° E., 403 lks. dist., with brass cap mkd. T5N R31E S16 RM 266 FT 1980 with an arrow pointing to the corner.															
	An iron post, 28 ins. long, 2½ ins. diam., set 22 ins. in the ground, for a reference monument, bears S. 20° W., 341 lks. dist., with brass cap mkd. T5N R31E S17 RM 225 FT 1980 with an arrow pointing to the corner.															
	A yellow "Deep 1" magnetic marker, buried 2 ft. in the ground, bears N. 45° E., 25 lks. dist.															
	A red "Deep 1" magnetic marker, buried 2 ft. in the ground, bears S. 45° E., 25 lks. dist.															
	A blue "Deep 1" magnetic marker, buried 2 ft. in the ground, bears S. 45° W., 25 lks. dist.															
	An orange "Deep 1" magnetic marker, buried 2 ft. in the ground, bears N. 45° W., 25 lks. dist.															
	From this point, the cor. of secs. 11, 12, 13, and 14 bears S. 89° 39' E., 239.94 chs. dist., determined at the intersection of fences extending N., E., and W. This position is harmoniously related with identified existing corners in the area, has long been recognized by owners of the adjacent lands as the corner and is accepted as the best available evidence of the position of the original corner.															
	At the corner point															
	Set an iron post, 28 ins. long, 2½ ins. diam., 22 ins. in the ground, with brass cap mkd.															

238

Dependent Resurvey, Portion of Subdivisional Lines,  
T. 5 N., R. 31 E., Willamette Mer., Oregon

CHAINS

T 5 N R 31 E

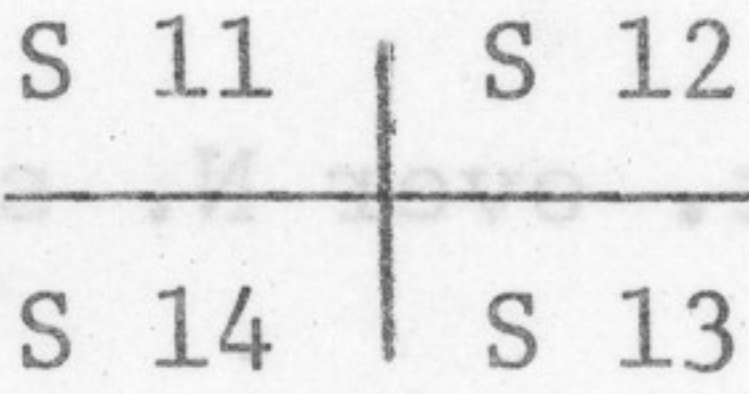


1980

From this same point, the cor. of secs. 16, 17, 20, and 21, bears S. 0° 16' W., 80.04 chs. dist., determined at intersection of fences, extending N., E., and S. This position is harmoniously related with identified existing corners in the area, has long been recognized by owners of the adjacent lands as the corner, and is accepted as the best available evidence of the position of the original corner.

At the corner point

Set an iron post, 28 ins. long, 2½ ins. diam., 22 ins. in the ground, with brass cap mkd.

T 5 N R 31 E

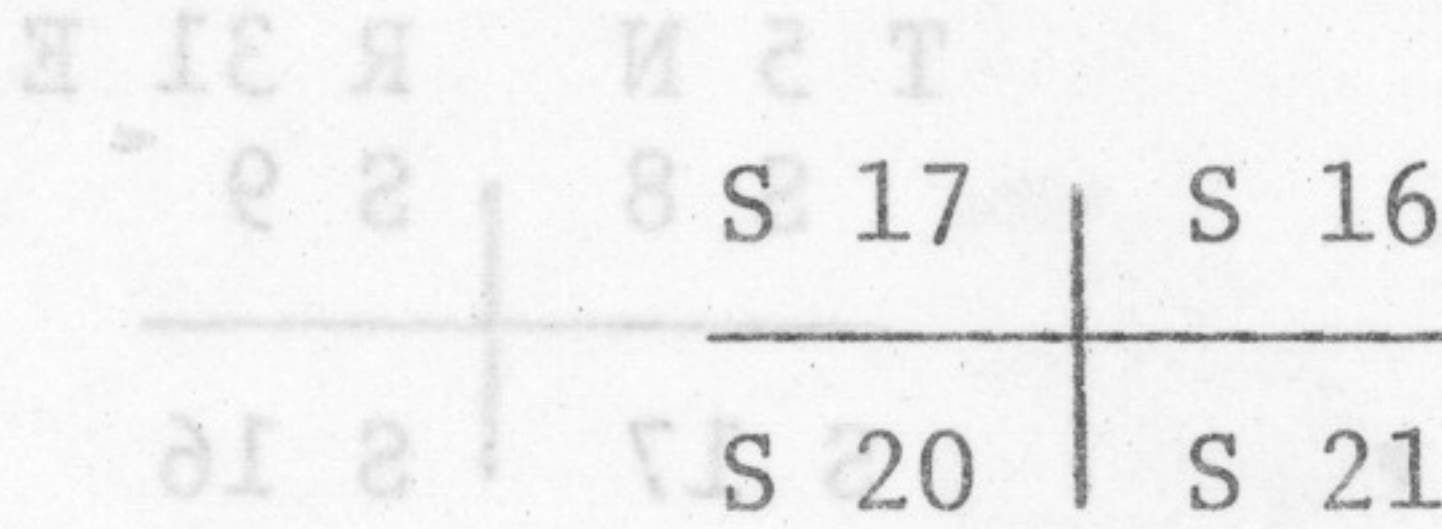

1980

These control lines were fully retraced and careful search was made for intervening corners, none of which were recovered.


N. 0° 05' W., bet. secs. 8 and 9.

Descend 25 ft. over gentle N. slope, across cultivated land.

19.10 Leave cultivated land, enter moderate sagebrush, edge bears NE. and SW.

20.01 Point for the S 1/16 sec. cor. of secs. 8 and 9.

Set an iron post, 28 ins. long, 2½ ins. diam., 20 ins. in the ground, with brass cap mkd.

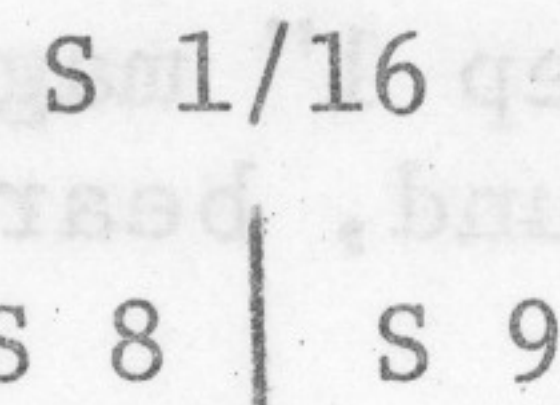

1980


Set a 5½ ft. steel fence post alongside the iron post.

Descend 45 ft. over rolling land.

40.02 Point for the ¼ sec. cor. of secs. 8 and 9, at proportionate distance; there is no remaining evidence of the original corner.

Set an iron post, 28 ins. long, 2½ ins. diam., 20 ins. in the ground, with brass cap mkd.

T 5 N R 31 E

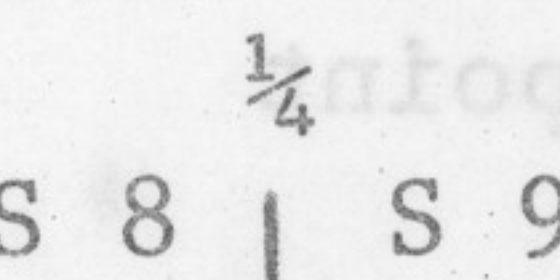

1980

Dependent Resurvey, Portion of Subdivisional Lines,  
T. 5 N., R. 31 E., Willamette Mer., Oregon

CHAINS		CHAINS									
	<p>Set a 5½ ft. steel fence post alongside the iron post.</p> <p>Ascend 15 ft. over rolling land.</p>										
41.00	Ridge, bears E. and W.; asc. slightly over rolling land.										
80.04	Point for the cor. of secs. 4, 5, 8, and 9, at proportionate distance; there is no remaining evidence of the original corner.										
	<p>Set an iron post, 28 ins. long, 2½ ins. diam., 20 ins. in the ground, in a mound of stone, 2 ft. base, to top, with brass cap mkd.</p> <p style="text-align: center;">T 5 N R 31 E</p> <table style="margin-left: auto; margin-right: auto;"> <tr> <td>S 5</td> <td> </td> <td>S 4</td> </tr> <tr> <td colspan="3" style="text-align: center;">—</td> </tr> <tr> <td>S 8</td> <td> </td> <td>S 9</td> </tr> </table> <p style="text-align: center;">1980</p>	S 5		S 4	—			S 8		S 9	
S 5		S 4									
—											
S 8		S 9									
	<p>Set a 5½ ft. steel fence post alongside the iron post.</p> <p>Ascend 105 ft. over rolling land, through moderate sagebrush.</p> <p>Land, rolling hills.</p> <p>Soil, sandy.</p> <p>Vegetation, wheat, bunchgrass, and sagebrush.</p>										
	<p>From the cor. of secs. 3, 4, 9, and 10.</p> <p>Point for the ¼ sec. cor. of secs. 4 and 9, at proportionate distance; there is no remaining evidence of the original corner.</p> <p>Ascend 30 ft. over SE. slope, through moderate sagebrush.</p>										
8.25	Top of ascent, slopes SW.; desc. 170 ft. over W. slope.										
20.00	Barbed wire fence, bears N. and S.										
34.30	Bottom of descent, slopes S. 30° W.; asc. 65 ft. over E. slope.										
39.95	Point for the ¼ sec. cor. of secs. 4 and 9, at proportionate distance; there is no remaining evidence of the original corner.										
	<p>Set an iron post, 28 ins. long, 2½ ins. diam., 22 ins. in the ground, with brass cap mkd.</p> <p style="text-align: center;">T 5 N R 31 E</p> <table style="margin-left: auto; margin-right: auto;"> <tr> <td>S 4</td> <td> </td> <td>S 9</td> </tr> <tr> <td colspan="3" style="text-align: center;">—</td> </tr> <tr> <td colspan="3" style="text-align: center;">¼</td> </tr> </table> <p style="text-align: center;">1980</p>	S 4		S 9	—			¼			
S 4		S 9									
—											
¼											
	<p>Set a 5½ ft. steel fence post alongside the iron post.</p> <p>Corner is located on ridge, bears N. 10° E. and S. 10° W.; desc. 105 ft. over W. slope.</p>										
50.35	Draw, drains S. 35° W.; asc. 30 ft. over SE. slope.										
54.75	Spur, slopes S.; desc. 40 ft. over W. slope.										
59.925	Point for the W 1/16 sec. cor. of secs. 4 and 9.										
	<p>Set an iron post, 28 ins. long, 2½ ins. diam., 20 ins. in the ground, with brass cap mkd.</p>										

240

Dependent Resurvey, Portion of Subdivisional Lines,  
T. 5 N., R. 31 E., Willamette Mer., Oregon

CHAINS

	<p>Set a 5 1/2 ft. steel fence post alongside the iron post.</p> <p>W 1/16</p> <p>S 9</p> <p>1980</p> <p>Set a 5 1/2 ft. steel fence post alongside the iron post.</p> <p>The corner of fences, extending N. and N. 75° W., bears N. 6° 55' W., 317 lks. dist.</p> <p>Descend 80 ft. over W. slope.</p> <p>65.45 Draw, drains S. 35° W.; asc. 50 ft. over SE. slope.</p> <p>79.90 The cor. of secs. 4, 5, 8, and 9.</p> <p>Land, rolling hills. Soil, sandy. Vegetation, sagebrush.</p>
	<p>N. 3° 48' W., bet. secs. 4 and 5.</p> <p>Ascend 105 ft. over rolling land, through moderate sagebrush.</p> <p>4.30 Barbed wire fence, bears S. 80° E. and N. 80° W.</p>
	<p>Draw, drains S. 40° W.; asc. slightly over rolling land.</p> <p>40.11 Point for the 1/4 sec. cor. of secs. 4 and 5, at proportionate distance; there is no remaining evidence of the original corner.</p> <p>Set an iron post, 28 ins. long, 2 1/2 ins. diam., 20 ins. in the ground, directly over a 5 1/2 ft. steel fence post, driven 5 ft. in the ground, with brass cap mkd.</p> <p>T 5 N R 31 E</p> <p>1/4</p> <p>S 5   S 4</p> <p>1980</p> <p>Ascend slightly over rolling land.</p> <p>60.165 Point for the N 1/16 sec. cor. of secs. 4 and 5.</p> <p>Set an iron post, 28 ins. long, 2 1/2 ins. diam., 20 ins. in the ground directly over a 5 1/2 ft. steel fence post, driven 5 ft. in the ground, with brass cap mkd.</p> <p>N 1/16</p> <p>S 5   S 4</p> <p>1980</p> <p>Corner is located on ridge, bears N. 10° E. and S. 10° W.; desc. 105 ft. over W. slope.</p> <p>Ascend 20 ft. over rolling land.</p> <p>65.25 Top of ascent, slopes E.; desc. 75 ft. over N. slope.</p> <p>75.50 The cor. of secs. 4, 5, 32, and 33, on the N. bdy. of the Tp.</p> <p>Land, rolling hills. Soil, sandy. Vegetation, sagebrush.</p>

Dependent Resurvey, Portion of Subdivisional Lines,  
T. 5 N., R. 31 E., Willamette Mer., Oregon

CHAINS		CHAINS
	From the cor. of secs. 8, 9, 16, and 17. N. 88° 19' W., bet. secs. 8 and 17. Descend 70 ft. over SW. slope, through moderate sagebrush.	
8.60	Bottom of descent, slopes NW., also dirt road, 20 lks. wide, bears N. 60° W. and S. 60° E.; asc. 50 ft. over NE. slope.	
19.935	Point for the E 1/16 sec. cor. of secs. 8 and 17. Set an iron post, 28 ins. long, 2½ ins. diam., 20 ins. in the ground, with brass cap mkd.	
	S 8 E 1/16 ————— S 17 1980	
	Corner is located at top of ascent, slopes N.; desc. slightly over NW. slope.	
29.00	Draw, drains S. 20° W.; asc. slightly over rolling land.	
34.45	Dirt road, 20 lks. wide, bears N. 40° E. and S. 50° W.	
39.87	Point for the ¼ sec. cor. of secs. 8 and 17, at proportionate distance; there is no remaining evidence of the original corner. Set an iron post, 28 ins. long, 2½ ins. diam., 20 ins. in the ground, with brass cap mkd.	
	T 5 N    R 31 E S 8 ¼ ————— S 17 1980	
	Set a 5½ ft. steel fence post alongside the iron post. Descend 130 ft. over rolling land.	
40.10	Abandoned dirt road, 10 lks. wide, bears N. 20° E. and S. 40° W.	
79.74	Point for the cor. of secs. 7, 8, 17, and 18, at proportionate distance; there is no remaining evidence of the original corner. Set an iron post, 28 ins. long, 2½ ins. diam., 22 ins. in the ground, with brass cap mkd.	
	T 5 N    R 31 E S 7    S 8 S 18   S 17 1980	
	Set a 5½ ft. steel fence post alongside the iron post. From this point, the ¼ sec. cor. of secs. 17 and 18 bears S. 0° 12' E., 39.92 chs. dist., determined at the intersection of fences, extending S., E., and W. This position is harmoniously related with identified existing	

Dependent Resurvey, Portion of Subdivisional Lines,  
T. 5 N., R. 31 E., Willamette Mer., Oregon

CHAINS

corners in the area, has long been recognized by owners of the adjacent lands as the corner, and is accepted as the best available evidence of the position of the original corner.

At the corner point

Set an iron post, 28 ins. long, 2½ ins. diam., 22 ins. in the ground, with brass cap mkd.

T 5 N R 31 E

S 18 | S 17

1980

From this point, United States Coast and Geodetic Survey triangulation station JINGLE 1956, bears N. 63° 53' E., 0.19 chs. dist., monumented with a standard brass tablet, 3½ ins. diam., firmly set in a concrete post, 6 ins. diam., projecting 6 ins. above ground, with top mkd. JINGLE 1956, and a triangle.

Land, rolling hills.

Soil, sandy.

Vegetation, wheat and sagebrush.

N. 89° 20' W., bet. secs. 7 and 18.

Descend 20 ft. over rolling land, through moderate sagebrush.

39.86

Point for the ¼ sec. cor. of secs. 7 and 18, at proportionate distance; there is no remaining evidence of the original corner.

Set an iron post, 28 ins. long, 2½ ins. diam., 20 ins. in the ground, with brass cap mkd.

T 5 N R 31 E

S 7

¼

S 18

1980

Set a 5½ ft. steel fence post alongside the iron post.

From this point, a United States Geological Survey mapping control station, bears N. 22° 53' W., 0.68 chs. dist., monumented with a standard brass tablet, 3½ ins. diam., firmly set in a concrete post, 6 ins. diam., projecting 6 ins. above ground, with top mkd. TT No. 18Y 1930, and a triangle.

Descend 85 ft. over rolling land.

79.60

The cor. of secs. 7, 12, 13, and 18, on the W. bdy. of the Tp.

Land, rolling hills.

Soil, sandy.

Vegetation, sagebrush.

From the cor. of secs. 7, 8, 17, and 18.

N. 0° 04' W., bet. secs. 7 and 8.



Dependent Resurvey, Portion of Subdivisional Lines,  
T. 5 N., R. 31 E., Willamette Mer., Oregon

CHAINS		CHAINS
	Ascend 110 ft. over broken SW. slope, through moderate sagebrush.	
22.00	Top of ascent, slopes W.; desc. 55 ft. over N. slope.	
22.90	Barbed wire fence, bears S. 75° E. and N. 75° W.	
39.92	Point for the 1/4 sec. cor. of secs. 7 and 8, at proportionate distance; there is no remaining evidence of the original corner.	
	Set an iron post, 22 ins. long, 2 1/2 ins. diam., 20 ins. in the ground, with brass cap mkd.	
	T 5 N   R 31 E 1/4 S 2     ----- S 7       S 8 S 8 1980	
	Set a 5 1/2 ft. steel fence post alongside the iron post.	
	Corner is located at bottom of descent, slopes E.; asc. 25 ft. over rolling land.	
59.88	Point for the N 1/16 sec. cor. of secs. 7 and 8.	
	Set an aluminum post, 28 ins. long, 2 1/2 ft. diam., 20 ins. in the ground, with aluminum cap mkd.	
	N 1/16 Descend 10 ft. over rolling land. S 7       S 8 1980	
	Set a 5 1/2 ft. steel fence post alongside the aluminum post.	
	Corner is located at top of ascent, slopes W.; desc. 190 ft. over broken N. slope.	
77.40	Draw, drains S. 70° W.; asc. 30 ft. over S. slope.	
79.84	Point for the cor. of secs. 5, 6, 7, and 8, at proportionate distance; there is no remaining evidence of the original corner.	
	Set an iron post, 28 ins. long, 2 1/2 ins. diam., 20 ins. in the ground, directly over a 5 1/2 ft. steel fence post, driven 5 ft. in the ground, with brass cap mkd.	
	T 5 N   R 31 E S 6       S 5 ----- S 7       S 8 1980	
	An iron rod, 1/2 in. diam., firmly set, projecting 6 ins. above ground, at the intersection of downed fences, extending S. and E., bears S. 32° 22' W., 290 lks. dist.	
	Land, rolling hills. Soil, sandy. Vegetation, sagebrush.	

244

Dependent Resurvey, Portion of Subdivisional Lines,  
T. 5 N., R. 31 E., Willamette Mer., Oregon

CHAINS

From the cor. of secs. 4, 5, 8, and 9.  
N. 88° 27' W., bet. secs. 5 and 8.  
Descend 55 ft. over rolling land, through moderate sagebrush.

39.85 Point for the 1/4 sec. cor. of secs. 5 and 8, at proportionate distance; there is no remaining evidence of the original corner.

Set an iron post, 28 ins. long, 2 1/2 ins. diam., 20 ins. in the ground, directly over a 5 1/2 ft. steel fence post, driven 5 ft. in the ground, with brass cap mkd.

T 5 N R 31 E  
S 5  
1/4  
S 8  
1980 1980

from which

An iron post, 28 ins. long, 2 1/2 ins. diam., set 22 ins. in the ground, for a reference monument, bears S. 5° 00' E., 162 lks. dist., with brass cap mkd. T5N R31E 1/4 S8 RM 107 FT 1980 and an arrow pointing to the corner.

A spike in top of railroad tie fence post, in barbed wire fence, extending N. and S., bears N. 78 3/4° W., 141 lks. dist.

Descend 10 ft. over rolling land.

59.775 Point for the W 1/16 sec. cor. of secs. 5 and 8.

Set an iron post, 28 ins. long, 2 1/2 ins. diam., 20 ins. in the ground, with brass cap mkd.

S 5  
W 1/16  
S 8

Set a 5 1/2 ft. steel fence post alongside the iron post.  
Descend 75 ft. over NW. slope.

70.50 Draw, drains S. 75° W.; asc. 10 ft. over S. slope.

79.70 The cor. of secs. 5, 6, 7, and 8.

Land, rolling hills.  
Soil, sandy.  
Vegetation, sagebrush.

N. 88° 59' W., bet. secs. 6 and 7.

Descend slightly over rolling land, through moderate sagebrush.

19.92 Point for the E 1/16 sec. cor. of secs. 6 and 7.

Set an iron post, 28 ins. long, 2 1/2 ins. diam., 15 ins. in the ground, to solid rock, in a mound of stone, 3 ft. base, to top, with brass cap mkd.

Dependent Resurvey, Portion of Subdivisional Lines,  
T. 5 N., R. 31 E., Willamette Mer., Oregon

CHAINS	
	<p style="text-align: right;">S 6 E 1/16</p>
	<p style="text-align: right;">S 7 1980</p>
39.84	<p>Descend 80 ft. over rolling land.</p> <p>Point for the 1/4 sec. cor. of secs. 6 and 7, at proportionate distance; there is no remaining evidence of the original corner.</p> <p>Set an iron post, 28 ins. long, 2 1/2 ins. diam., 22 ins. in the ground, with brass cap mkd.</p>
	<p style="text-align: center;">T 5 N R 31 E S 6 1/4 S 7 1981</p>
	<p>from which</p> <p>An iron post, 28 ins. long, 2 1/2 ins. diam., set 22 ins. in the ground, for a reference monument, bears S. 10° 00' E., 230 1/2 lks. dist., with brass cap mkd. T5N R31E 1/4 S7 RM 152 FT 1981 and an arrow pointing to the corner.</p>
	<p>An iron post, 28 ins. long, 2 1/2 ins. diam., set 22 ins. in the ground, for a reference monument, bears N. 10° 00' W., 219 1/2 lks. dist., with brass cap mkd. T5N R31E 1/4 S6 RM 145 FT 1981 and an arrow pointing to the corner.</p> <p>Corner is located on top of underground gas pipeline, bears N. 55° E. and S. 55° W.</p>
	<p>Ascend 65 ft. over rolling land.</p>
59.76	<p>Point for the W 1/16 sec. cor. of secs. 6 and 7.</p>
	<p>Set an iron post, 28 ins. long, 2 1/2 ins. diam., 20 ins. in the ground, with brass cap mkd.</p>
	<p style="text-align: right;">S 6 W 1/16 S 7 1980</p>
	<p>Set a 5 1/2 ft. steel fence post alongside the iron post.</p> <p>Ascend 110 ft. over rolling land.</p>
79.04	<p>The cor. of secs. 1, 6, 7, and 12, on the W. bdy. of the Tp.</p> <p>Land, rolling hills. Soil, sandy. Vegetation, sagebrush.</p>
	<p>From the cor. of secs. 5, 6, 7, and 8.</p> <p>N. 1° 19' E., bet. secs. 5 and 6.</p> <p>Ascend 120 ft. over broken S. slope, through moderate sagebrush.</p>

246

Dependent Resurvey, Portion of Subdivisional Lines,  
T. 5 N., R. 31 E., Willamette Mer., Oregon

<p>CHAINS 22.00</p>	<p>Top of ascent, slopes W.; desc. 60 ft. over NW. slope.</p>
<p>29.50</p>	<p>Underground gas pipeline, bears N. 55° E. and S. 55° W.</p>
<p>39.93</p>	<p>Point for the ¼ sec. cor. of secs. 5 and 6, at proportionate distance; there is no remaining evidence of the original corner.</p>
	<p>Set an iron post, 28 ins. long, 2½ ins. diam., 20 ins. in the ground, with brass cap mkd.</p>
	<p style="text-align: center;">T 5 N R 31 E ¼ S 6   S 5 1980</p>
	<p>Set a 5½ ft. steel fence post alongside the iron post.</p>
	<p>Descend 165 ft. over broken NW. slope.</p>
<p>64.50</p>	<p>Rim of Juniper Canyon, bears N. 60° E. and S. 60° W.; desc. 400 ft. over steep NW. slope.</p>
<p>79.05</p>	<p>Juniper Creek, 15 lks. wide, drains S. 35° W.; asc. slightly over nearly level bottom land.</p>
<p>81.85</p>	<p>The cor. of secs. 5, 6, 31, and 32, on the N. bdy. of the Tp. Land, rolling hills. Soil, sandy. Vegetation, sagebrush.</p>
<p>Subdivision of Section 2, T. 5 N., R. 31 E., Willamette Meridian, Oregon</p>	
	<p>From the ¼ sec. cor. of secs. 2 and 11. N. 2° 19' W., on the N. and S. center line of sec. 2. Ascend 80 ft. over SE. slope, across cultivated land.</p>
<p>16.00</p>	<p>Ridge, bears NE. and SW.; desc. 105 ft. over NW. slope.</p>
<p>39.69</p>	<p>Point for the center ¼ sec. cor. of sec. 2, at intersection with the E. and W. center line. Set an iron post, 28 ins. long, 2½ ins. diam., 43 ins. in the ground, the top 15 ins. below the surface of cultivated land, with brass cap mkd.</p>
	<p style="text-align: center;">T 5 N R 31 E ¼ S 2 1980</p>
	<p>from which</p> <p>An iron post, 28 ins. long, 2½ ins. diam., set 20 ins. in the ground, in a mound of stone, 2 ft. base, to top, for a reference monument, bears N. 70° E., 409 lks. dist., with brass cap mkd. T5N R31E C¼ S2 RM 270 FT 1980 and an arrow pointing to the corner. Set a 5½ ft. steel fence post alongside this iron post.</p>

Subdivision of Section 2,  
T. 5 N., R. 31 E., Willamette Mer., Oregon

CHAINS	
	<p>A yellow "Deep 1" magnetic marker, buried 2 ft. in the ground, bears N. 45° E., 25 lks. dist.</p> <p>A blue "Deep 1" magnetic marker, buried 2 ft. in the ground, bears S. 45° W., 25 lks. dist.</p> <p>Descend 90 ft. over N. slope.</p>
59.695	<p>Point for the center N 1/16 sec. cor. of sec. 2.</p> <p>Set an iron post, 28 ins. long, 2½ ins. diam., 46 ins. in the ground, the top 18 ins. below the surface of cultivated field, with brass cap mkd.</p> <p style="text-align: center;">C N 1/16   S 2 C 1980</p> <p>from which</p>
	<p>A yellow "Deep 1" magnetic marker, buried 2 ft. in the ground, bears N. 45° E., 25 lks. dist.</p> <p>A red "Deep 1" magnetic marker, buried 2 ft. in the ground, bears S. 45° E., 25 lks. dist.</p> <p>A blue "Deep 1" magnetic marker, buried 2 ft. in the ground, bears S. 45° W., 25 lks. dist.</p> <p>An orange "Deep 1" magnetic marker, buried 2 ft. in the ground, bears N. 45° W., 25 lks. dist.</p> <p>Descend 50 ft. over NE. slope.</p>
77.24	<p>The ¼ sec. cor. of secs. 2 and 35, on the N. bdy. of the Tp.</p>
	<p>From the ¼ sec. cor. of secs. 1 and 2.</p> <p>N. 88° 38' W., on the E. and W. center line of sec. 2.</p> <p>Descend 60 ft. over NW. slope, across cultivated land.</p>
1.35	Barbed wire fence, bears N. and S.
7.40	Draw, drains N. 50° E.; asc. 100 ft. over E. slope.
15.00	Spur, slopes NE.; desc. 100 ft. over W. slope.
30.95	Draw, drains N. 15° E.; asc. 100 ft. over E. slope.
34.00	Top of ascent, slopes N.; thence over rolling land.
38.20	Dirt road, 15 lks. wide, bears N. 25° E. and S.
41.07	The center ¼ sec. cor. of sec. 2.
	Descend 40 ft. over rolling land.
59.35	Barbed wire fence, bears N. and S. 30° W.
61.015	Point for the center W 1/16 sec. cor. of sec. 2.
	Set an iron post, 28 ins. long, 2½ ins. diam., 43 ins. in the ground, the top 15 ins. below the surface of cultivated field, with brass cap mkd.

248

Subdivision of Section 2,  
T. 5 N., R. 31 E., Willamette Mer., Oregon

CHAINS

	<p>W 1/16</p> <p>C ————— C</p> <p>S 2</p> <p>1980</p> <p>from which</p> <p>An iron post, 28 ins. long, 2½ ins. diam., set 22 ins. in the ground, in a mound of stone, 2 ft. base, to top, for a reference monument, bears N. 45° E., 238 lks. dist., with brass cap mkd. CW 1/16 S2 RM 157 FT 1980 and an arrow pointing to the corner.</p> <p>An iron post, 28 ins. long, 2½ ins. diam., set 22 ins. in the ground, in a mound of stone, 2 ft. base, to top, for a reference monument, bears S. 45° E., 162 lks. dist., with brass cap mkd. CW 1/16 S2 RM 107 FT 1980 and an arrow pointing to the corner. Set a 5½ ft. steel fence post alongside this iron post.</p> <p>Corner is located at bottom of descent, slopes S.; asc. 30 ft. over rolling land.</p>
77.65	Spur, slopes S. 10° W.; desc. 15 ft. over W. slope.
80.96	The ¼ sec. cor. of secs. 2 and 3.
	<p>From the center W 1/16 sec. cor. of sec. 2.</p> <p>N. 2° 23' W., on the N. and S. center line of the NW¼ of sec. 2.</p> <p>Ascend slightly rolling land, across cultivated field.</p>
11.00	Top of ascent, slopes W.; desc. 95 ft. over N. slope.
18.15	Draw, drains N. 30° E.; asc. 20 ft. over SE. slope.
19.91	Point for the NW 1/16 sec. cor. of sec. 2, at intersection with the E. and W. center line of the NW¼.
	<p>Set an iron post, 28 ins. long, 2½ ins. diam., 22 ins. in the ground, with brass cap mkd.</p> <p>NW 1/16 S 2</p> <p>1980</p> <p>Set a 5½ ft. steel fence post alongside the iron post.</p> <p>Ascend slightly over rolling land.</p>
36.79	The W 1/16 sec. cor. of secs. 2 and 35, on the N. bdy. of the Tp.
	<p>From the center N 1/16 sec. cor. of sec. 2.</p> <p>N. 88° 56' W., on the E. and W. center line of the NW¼ of sec. 2.</p> <p>Ascend 20 ft. over NE. slope, across cultivated field.</p>
6.80	Top of ascent, slopes N.; desc. 70 ft. over W. slope.
17.45	Barbed wire fence, bears N. and S.

Subdivision of Section 2,  
T. 5 N., R. 31 E., Willamette Mer., Oregon

CHAINS	
18.55	Draw, drains N. 15° E.; asc. 35 ft. over SE. slope.
19.96	The NW 1/16 sec. cor. of sec. 2. Ascend slightly over rolling land.
39.92	The N 1/16 sec. cor. of secs. 2 and 3.
Subdivision of Section 3, T. 5 N., R. 31 E., Willamette Meridian, Oregon	
From the 1/4 sec. cor. of secs. 3 and 10. N. 2° 50' W., on the N. and S. center line of sec. 3.	
5.30	Descend 30 ft. over N. slope, across cultivated land. Bottom of descent, slopes SW.; also dirt road, 15 lks. wide, bears N. 70° E. and S. 60° W.; asc. 45 ft. over S. slope.
9.10	Spur, slopes S. 25° W.; desc. 30 ft. over NW. slope.
14.30	Bottom of descent, slopes SW., also dirt road, 15 lks. wide, bears N. 25° E. and S. 25° W.; asc. 145 ft. over SE. slope.
30.00	Ridge, bears N. 30° E. and S. 30° W.; desc. 40 ft. over NW. slope.
36.55	Barbed wire fence, bears NE. and SW.
39.79	Point for the center 1/4 sec. cor. of sec. 3, at intersection with the E. and W. center line.  Set an iron post, 28 ins. long, 2 1/2 ins. diam., 22 ins. in the ground, in a mound of stone, 2 ft. base, to top, with brass cap mkd.
T 5 N R 31 E C 1/4 S 3	
1980	
Set a 5 1/2 ft. steel fence post alongside the iron post. Descend 180 ft. over NW. slope changing to N. slope.	
55.30	Bottom of descent, slopes E.; asc. 45 ft. over SE. slope.
59.685	Point for the center N 1/16 sec. cor. of sec. 3.
Set an iron post, 28 ins. long, 2 1/2 ins. diam., 22 ins. in the ground, in a mound of stone, 2 ft. base, to top, with brass cap mkd.	
N 1/16   S 3 C 1980	
Set a 5 1/2 ft. steel fence post alongside the iron post. Ascend 40 ft. over SE. slope.	

250

Subdivision of Section 3,  
T. 5 N., R. 31 E., Willamette Mer., Oregon

CHAINS 62.75	Top of ascent, slopes SE.; desc. 70 ft. over rolling land.
75.67	The 1/4 sec. cor. of secs. 3 and 34, on the N. bdy. of the Tp.
	From the 1/4 sec. cor. of secs. 2 and 3.
	N. 89° 56' W., on the E. and W. center line of sec. 3. Ascend 65 ft. over SE. slope, across cultivated land.
8.00	Ridge, bears NE. and SW.; desc. 115 ft. over W. slope.
24.15	Bottom of descent, slopes SW., also dirt road, 15 lks. wide, bears N. 30° E. and S. 30° W.; asc. 90 ft. over SE. slope.
34.50	Ridge, bears NE. and SW.; desc. 30 ft. over NW. slope.
36.55	Barbed wire fence, bears NE. and SW.
40.11	The center 1/4 sec. cor. of sec. 3. Descend 30 ft. over NW. slope.
47.00	Bottom of descent, slopes SW.; asc. 70 ft. over E. slope.
60.155	Point for the center W 1/16 sec. cor. of sec. 3. Set an aluminum post, 28 ins. long, 2 1/2 ins. diam., 20 ins. in the ground, with aluminum cap mkd.  <div style="text-align: center;">                     W 1/16                      C ————— C                      S 3                      1980                 </div> Set a 5 1/2 ft. steel fence post alongside the aluminum post.  Corner is located on ridge, bears NE. and SW.; desc. 110 ft. over W. slope.
80.20	The 1/4 sec. cor. of secs. 3 and 4.  From the center W 1/16 sec. cor. of sec. 3. N. 3° 02' W., on the N. and S. center line of the NW 1/4 of sec. 3.  Descend 70 ft. over N. slope, through moderate sagebrush.
19.95	Point for the NW 1/16 sec. cor. of sec. 3, at intersection with the E. and W. center line of the NW 1/4.  Set an iron post, 28 ins. long, 2 1/2 ins. diam., 22 ins. in the ground, in a mound of stone, 2 ft. base, to top, with brass cap mkd.  <div style="text-align: center;">                     NW 1/16    S 3                      1980                 </div> Set a 5 1/2 ft. steel fence post alongside the iron post.  Descend 85 ft. over rolling land.



Subdivision of Section 3,  
T. 5 N., R. 31 E., Willamette Mer., Oregon

CHAINS	
35.81	The W 1/16 sec. cor. of secs. 3 and 34, on the N. bdy. of the Tp.
	From the center N 1/16 sec. cor. of sec. 3.
	N. 89° 48' W., on the E. and W. center line of the NW $\frac{1}{4}$ of sec. 3.
	Ascend 105 ft. over E. slope, through moderate sagebrush.
20.105	The NW 1/16 sec. cor. of sec. 3.
	Ascend slightly over rolling land.
21.00	Top of ascent slopes N.; desc. 30 ft. over rolling land.
40.21	The N 1/16 sec. cor. of secs. 3 and 4.
	Subdivision of Section 4, T. 5 N., R. 31 E., Willamette Meridian, Oregon
	From the $\frac{1}{4}$ sec. cor. of secs. 4 and 9.
	N. 3° 36' W., on the N. and S. center line of sec. 4.
	Descend 120 ft. over NW. slope, through sagebrush.
40.05	Point for the center $\frac{1}{4}$ sec. cor. of sec. 4, at intersection with the E. and W. center line.
	Set an iron post, 28 ins. long, 2 $\frac{1}{2}$ ins. diam., 20 ins. in the ground, directly over a 5 $\frac{1}{2}$ ft. steel fence post, driven 5 ft. in the ground, with brass cap mkd.
	T 5 N R 31 E C $\frac{1}{4}$ S 4
	1980
	The corner is located in draw, drains SE.; asc. 135 ft. over SE. slope.
57.40	Barbed wire fence, bears N. 80° E. and S. 80° W.
59.905	Point for the center N 1/16 sec. cor. of sec. 4.
	Set an aluminum post, 28 ins. long, 2 $\frac{1}{2}$ ins. diam., 20 ins. in the ground, with aluminum cap mkd.
	C
	N 1/16   S 4
	C
	1980
	Set a 5 $\frac{1}{2}$ ft. steel fence post alongside the iron post.
	Continue over rolling land.
75.32	The $\frac{1}{4}$ sec. cor. of secs. 4 and 33, on the N. bdy. of the Tp.
	From the $\frac{1}{4}$ sec. cor. of secs. 3 and 4.

252

Subdivision of Section 4,  
T. 5 N., R. 31 E., Willamette Mer., Oregon

CHAINS	
	<p>N. 89° 59' W., on the E. and W. center line of sec. 4. Ascend 60 ft. over SE. slope, through sagebrush.</p>
13.05	<p>Barbed wire fence, bears N. 10° E. and S. 10° W.</p>
15.00	<p>Ridge, bears NE. and SW.; desc. 70 ft. over NW. slope.</p>
20.12	<p>Point for the center E 1/16 sec. cor. of sec. 4. Set an iron post, 28 ins. long, 2½ ins. diam., 20 ins. in the ground, with brass cap mkd.</p>
	<p style="text-align: center;">E 1/16 C ————— C S 4 1980</p> <p>Set a 5½ ft. steel fence post alongside the iron post.</p>
	<p>Descend 110 ft. over NW. slope.</p>
40.24	<p>The center ¼ sec. cor. of sec. 4.</p>
	<p>Ascend 115 ft. over SE. slope.</p>
50.00	<p>Ridge, bears NE. and SW.; desc. 70 ft. over NW. slope.</p>
58.50	<p>Barbed wire fence, bears N. and S.</p>
60.28	<p>Point for the center W 1/16 sec. cor. of sec. 4. Set an iron post, 28 ins. long, 2½ ins. diam., 22 ins. in the ground, with brass cap mkd.</p>
	<p style="text-align: center;">W 1/16 C ————— C S 4 1980</p> <p>from which</p>
	<p style="text-align: center;">1980</p> <p>The intersection of wire fences, extending N. 55° E. and S., bears N. 21° 23' E., 463 lks. dist.</p>
	<p>Set a 5½ ft. steel fence post alongside the iron post. Descend 70 ft. over W. slope.</p>
68.75	<p>Draw, drains SW.; asc. 105 ft. over SE. slope.</p>
80.32	<p>The ¼ sec. cor. of secs. 4 and 5.</p>
	<p>From the center E 1/16 sec. cor. of sec. 4. N. 3° 23' W., on the N. and S. center line of the NE¼ of sec. 4.</p>
	<p style="text-align: center;">1980</p> <p>Descend 105 ft. over NW. slope, through sagebrush.</p>
18.45	<p>Barbed wire fence, bears N. 85° E. and S. 85° W.</p>
19.93	<p>Point for the NE 1/16 sec. cor. of sec. 4 at intersection with the E. and W. center line of the NE¼.</p>
	<p>Set an iron post, 28 ins. long, 2½ ins. diam., 22 ins. in the ground, in a mound of stone, 2½ ft. base, to top, with brass cap mkd.</p>

Subdivision of Section 4,  
T. 5 N., R. 31 E., Willamette Mer., Oregon

CHAINS		CHAINS
	NE 1/16 S 4	
	1980	
	Set a 5½ ft. steel fence post alongside the iron post.	
	Corner is located in draw, drains S. 60° W.	
	Ascend 105 ft. over S. slope.	
35.51	The E 1/16 sec. cor. of secs. 4 and 33, on the N. bdy. of the Tp.	
	From the N 1/16 sec. cor. of secs. 3 and 4.	
	S. 89° 48' W., on the E. and W. center line of the NE¼ of sec. 4.	
	Descend 125 ft. over NW. slope, through sagebrush.	
5.75	The intersection of wire fences, extending S. 15° W. and S. 80° W.	
20.18	The NE 1/16 sec. cor. of sec. 4.	
	Ascend 115 ft. over SE. slope.	
40.36	The center N 1/16 sec. cor. of sec. 4.	
	From the W 1/16 sec. cor. of secs. 4 and 9.	
	N. 3° 42' W., on the N. and S. center line of the SW¼ of sec. 4.	
	Descend 55 ft. over NW. slope, through scattering sagebrush.	
8.20	Draw, drains S. 30° W.; asc. 150 ft. over SE. slope.	
28.50	Ridge, bears NE. and SW.; desc. 45 ft. over NW. slope.	
40.09	The center W 1/16 sec. cor. of sec. 4.	
	From the center W 1/16 sec. cor. of sec. 4.	
	N. 3° 42' W., on the N. and S. center line of the NW¼ of sec. 4.	
	Descend 45 ft. over NW. slope, across open land.	
8.60	Draw, drains S. 50° W.; asc. 120 ft. over SE. slope.	
19.96	Point for the NW 1/16 sec. cor. of sec. 4 at intersection with the E. and W. center line of the NW¼.	
	Set an iron post, 28 ins. long, 2½ ins. diam., 20 ins. in the ground, with brass cap mkd.	
	NW 1/16 S 4	
	1980	
	Set a 5½ ft. steel fence post alongside the iron post.	
	Ascend 25 ft. over SE. slope.	

254

Subdivision of Section 4,  
T. 5 N., R. 31 E., Willamette Mer., Oregon

CHAINS 25.00	Spur, slopes SW.; desc. 70 ft. over NW. slope.
35.34	The W 1/16 sec. cor. of secs. 4 and 33, on the N. bdy. of the Tp.
	From the center N 1/16 sec. cor. of sec. 4. N. 89° 45' W., on the E. and W. center line of the NW 1/4 of sec. 4. Descend 85 ft. over W. slope, through sagebrush.
9.00	Draw, drains SW.; asc. 85 ft. over SE. slope.
20.075	The NW 1/16 sec. cor. of sec. 4. Continue over broken land.
24.00	Spur, slopes SW.; desc. 65 ft. over W. slope.
40.15	The N 1/16 sec. cor. of secs. 4 and 5.

Subdivision of Section 6,  
T. 5 N., R. 31 E., Willamette Meridian, Oregon

	From the 1/4 sec. cor. of secs. 6 and 7. N. 1° 23' E., on the N. and S. center line of sec. 6. Ascend 135 ft. over SE. slope, through sagebrush.
23.70	Spur, slopes S. 15° W.; desc. 35 ft. over NW. slope.
40.03	Point for the center 1/4 sec. cor. of sec. 6 at intersection with the E. and W. center line. Set an iron post, 28 ins. long, 2 1/2 ins. diam., 22 ins. in the ground, with brass cap mkd. T 5 N R 31 E C 1/4 S 6
	1980 Set a 5 1/2 ft. steel fence post alongside the iron post. Descend 250 ft. over NW. slope.
64.40	The S. rim of Juniper Canyon, bears SE. and NW.; desc. 310 ft. over NE. slope.
66.20	Abandoned dirt road, 15 lks. wide, bears N. 70° W. and S. 70° E.
80.65	Juniper Creek, dry, 15 lks. wide, drains N. 55° W.; asc. 10 ft. over S. slope.
81.07	The 1/4 sec. cor. of secs. 6 and 31, on the N. bdy. of the Tp.
	From the 1/4 sec. cor. of secs. 5 and 6. N. 88° 53' W., on the E. and W. center line of sec. 6.

Subdivision of Section 6,  
T. 5 N., R. 31 E., Willamette Mer., Oregon

CHAINS	
	Descend 100 ft. over NW. slope, through sagebrush.
23.00	Draw, drains S. 20° W.; asc. 75 ft. over E. slope.
28.85	Ridge, bears NE. and SW.; desc. 40 ft. over W. slope.
39.78	The center ¼ sec. cor. of sec. 6.
	Descend 145 ft. over W. slope.
56.40	Draw, drains N. 40° E.; asc. 130 ft. over broken E. slope.
79.73	The ¼ sec. cor. of secs. 1 and 6, on the W. bdy. of the Tp.
<p>Subdivision of Section 7, T. 5 N., R. 31 E., Willamette Meridian, Oregon</p>	
	From the ¼ sec. cor. of secs. 7 and 18.
	N. 0° 04' W., on the N. and S. center line of sec. 7.
	Descend 50 ft. over rolling land, through moderate sagebrush.
15.80	Draw, drains NW.; asc. 65 ft. over SW. slope.
22.30	Barbed wire fence, bears N. 80° E. and S. 80° W.
23.15	Top of ascent, slopes W.; desc. 55 ft. over rolling land.
37.95	Draw, drains SW.; asc. 10 ft. over SE. slope.
40.03	Point for the center ¼ sec. cor. of sec. 7, at intersection with the E. and W. center line.
	Set an iron post, 28 ins. long, 2½ ins. diam., 22 ins. in the ground, with brass cap mkd.
	<p>T 5 N R 31 E C ¼ S 7 1980</p>
	Set a 5½ ft. steel fence post alongside the iron post.
	Ascend 75 ft. over SE. slope.
53.70	Ridge, bears NE. and SW.; desc. 30 ft. over N. slope.
60.045	Point for the center N 1/16 sec. cor. of sec. 7.
	Set an aluminum post, 28 ins. long, 2½ ins. diam., 20 ins. in the ground, with aluminum cap mkd.
	<p>C N 1/16   S 7 C 1980</p>
	Set a 5½ ft. steel fence post alongside the aluminum post.

256

Subdivision of Section 7,  
T. 5 N., R. 31 E., Willamette Mer., Oregon

CHAINS	
	Descend 175 ft. over N. slope.
75.00	Bottom of descent, slopes NE.; asc. 15 ft. over SE. slope.
76.70	Ridge, bears N. 60° E. and S. 60° W.; desc. 40 ft. over NW. slope.
80.06	The ¼ sec. cor. of secs. 6 and 7.
	From the ¼ sec. cor. of secs. 7 and 8.
	N. 89° 10' W., on the E. and W. center line of sec. 7.
	Descend slightly over rolling land, through moderate sagebrush.
19.925	Point for the center E 1/16 sec. cor. of sec. 7.
	Set an aluminum post, 28 ins. long, 2½ ins. diam., 20 ins. in the ground, with aluminum cap mkd.
	<div style="text-align: center;">                     E 1/16                      C ————— C                      S 7                      1980                 </div>
	Set a 5½ ft. steel fence post alongside the aluminum post.
	Descend 85 ft. over W. slope.
38.45	Draw, drains SW.; asc. 5 ft. over SE. slope.
39.85	The center ¼ sec. cor. of sec. 7.
	Ascend 35 ft. over SE. slope.
45.40	Top of ascent, slopes S.; desc. 30 ft. over rolling land.
50.30	Draw, drains S. 55° W.; asc. 30 ft. over SE. slope.
59.77	Point for the center W 1/16 sec. cor. of sec. 7.
	Set an aluminum post, 28 ins. long, 2½ ins. diam., 20 ins. in the ground, with aluminum cap mkd.
	<div style="text-align: center;">                     W 1/16                      C ————— C                      S 7                      1980                 </div>
	Set a 5½ ft. steel fence post alongside the aluminum post.
	Ascend 50 ft. over SE. slope.
79.31	The ¼ sec. cor. of secs. 7 and 12, on the W. bdy. of the Tp.
	From the center E 1/16 sec. cor. of sec. 7.
	N. 0° 03' W., on the N. and S. center line of the NE¼ of sec. 7.
	Descend 80 ft. over NW. slope, through scattering sagebrush.

Subdivision of Section 7,  
T. 5 N., R. 31 E., Willamette Mer., Oregon

CHAINS	
17.70	Top of ascent, slopes W.; desc. 30 ft. over N. slope.
19.985	Point for the NE 1/16 sec. cor. of sec. 7, at intersection with the E. and W. center line of the NE $\frac{1}{4}$ .  Set an aluminum post, 28 ins. long, 2 $\frac{1}{2}$ ins. diam., 20 ins. in the ground, with aluminum cap mkd.  NE 1/16 S 7  1980  Set a 5 $\frac{1}{2}$ ft. steel fence post alongside the aluminum post.  Descend 30 ft. over N. slope.
27.40	Draw, drains NE.; asc. 25 ft. over SE. slope.
33.35	Spur, slopes NE.; desc. 45 ft. over N. slope.
37.55	Draw, drains SE.; asc. 20 ft. over SW. slope.
39.97	The E 1/16 sec. cor. of secs. 6 and 7.  From the N 1/16 sec. cor. of secs. 7 and 8.  N. 89° 05' W., on the E. and W. center line of the NE $\frac{1}{4}$ of sec. 7.  Descend 130 ft. over NW. slope, through moderate sagebrush.
19.925	The NE 1/16 sec. cor. of sec. 7.  Descend 5 ft. over W. slope.
22.55	Draw, drains NE.; asc. 80 ft. over E. slope.
39.85	The center N 1/16 sec. cor. of sec. 7.  From the center W 1/16 sec. cor. of sec. 7.  N. 0° 04' W., on the N. and S. center line of the NW $\frac{1}{4}$ of sec. 7.  Ascend 20 ft. over SE. slope, through moderate sagebrush.
4.00	Top of ascent, slopes W.; desc. 70 ft. over rolling land.
20.04	Point for the NW 1/16 sec. cor. of sec. 7, at intersection with the E. and W. center line of the NW $\frac{1}{4}$ .  Set an iron post, 28 ins. long, 2 $\frac{1}{2}$ ins. diam., 20 ins. in the ground, in a mound of stone, 2 ft. base, to top, with brass cap mkd.  NW 1/16 S 7  1980  Set a 5 $\frac{1}{2}$ ft. steel fence post alongside the iron post.  Descend 80 ft. over NE. slope.
26.30	Underground gas pipeline, bears N. 55° E. and S. 55° W.

258

Subdivision of Section 7,  
T. 5 N., R. 31 E., Willamette Mer., Oregon

CHAINS 40.08	<p>The W 1/16 sec. cor. of secs. 6 and 7.</p> <hr/> <p>From the center N 1/16 sec. cor. of sec. 7.</p> <p>N. 89° 05' W., on the E. and W. center line of the NW¼ of sec. 7.</p> <p>Descend 100 ft. over NW. slope, through moderate sagebrush.</p>
15.70	Draw, drains NE.; asc. 40 ft. over E. slope.
19.92	<p>The NW 1/16 sec. cor. of sec. 7.</p> <p>Ascend 80 ft. over NE. slope.</p>
28.55	Underground gas pipeline, bears N. 55° E. and S. 55° W.
39.33	The N 1/16 sec. cor. of secs. 7 and 12, on the W. bdy. of the Tp.
<p>Subdivision of Section 8, T. 5 N., R. 31 E., Willamette Meridian, Oregon</p>	
	<p>From the ¼ sec. cor. of secs. 8 and 17.</p> <p>N. 0° 05' W., on the N. and S. center line of sec. 8.</p> <p>Descend 25 ft. over rolling land, through scattering sagebrush.</p>
15.35	The intersection of barbed wire fences, extending generally N., E., and W.
19.985	<p>Point for the center S 1/16 sec. cor. of sec. 8.</p> <p>Set an iron post, 28 ins. long, 2½ ins. diam., 20 ins. in the ground, in a mound of stone, 2 ft. base, to top, with brass cap mkd.</p>
	<p>C</p> <p>S 1/16   S 8</p> <p>C</p> <p>1980</p>
	<p>Set a 5½ ft. steel fence post alongside the iron post.</p> <p>Descend 10 ft. over N. slope.</p>
21.00	Draw, drains E.; asc. 15 ft. over S. slope.
27.25	Top of ascent, slopes E.; desc. 30 ft. over rolling land.
39.97	<p>Point for the center ¼ sec. cor. of sec. 8, at intersection with the E. and W. center line.</p> <p>Set an iron post, 28 ins. long, 2½ ins. diam., 20 ins. in the ground, in a mound of stone, 2 ft. base, to top, with brass cap mkd.</p>



Subdivision of Section 8,  
T. 5 N., R. 31 E., Willamette Mer., Oregon

CHAINS		CHAINS
	<p>T 5 N R 31 E C <math>\frac{1}{4}</math> S 8 1980</p>	
	<p>Set a 5½ ft. steel fence post alongside the iron post. Descend 55 ft. over rolling land.</p>	
59.955	<p>Point for the center N 1/16 sec. cor. of sec. 8. Set an iron post, 28 ins. long, 2½ ins. diam., 20 ins. in the ground, in a mound of stone, 2 ft. base, to top, with brass cap mkd.</p>	
	<p>C N 1/16   S 8 C 1980</p>	
	<p>Set a 5½ ft. steel fence post alongside the iron post. Descend 55 ft. over rolling land.</p>	
79.94	<p>The ¼ sec. cor. of secs. 5 and 8.</p>	
	<p>From the ¼ sec. cor. of secs. 8 and 9. N. 88° 23' W., on the E. and W. center line of sec. 8. Descend 15 ft. over rolling open land.</p>	
19.93	<p>Point for the center E 1/16 sec. cor. of sec. 8. Set an iron post, 28 ins. long, 2½ ins. diam., 20 ins. in the ground, in a mound of stone, 2 ft. base, to top, with brass cap mkd.</p>	
	<p>E 1/16 C ————— C S 8 1980</p>	
	<p>Set a 5½ ft. steel fence post alongside the iron post. Descend 30 ft. over rolling land.</p>	
23.05	<p>Draw, drains N. 10° E.; asc. 55 ft. over E. slope.</p>	
34.50	<p>Top of ascent, slopes N.; desc. slightly over rolling land.</p>	
39.86	<p>The center ¼ sec. cor. of sec. 8. Descend 70 ft. over W. slope.</p>	
40.40	<p>Barbed wire fence, bears N. and S.</p>	
52.15	<p>Draw, drains N.; asc. 55 ft. over E. slope.</p>	
59.79	<p>Point for the center W 1/16 sec. cor. of sec. 8. Set an aluminum post, 28 ins. long, 2½ ins. diam., 20 ins. in the ground, with aluminum cap mkd.</p>	

260

Subdivision of Section 8,  
T. 5 N., R. 31 E., Willamette Mer., Oregon

CHAINS	
	W 1/16 C ————— C S 8 1980
	Set a 5½ ft. steel fence post alongside the aluminum post.
	Ascend 10 ft. over E. slope.
64.00	Top of ascent, slopes N.; desc. 65 ft. over broken W. slope.
71.35	Draw, drains N. 10° W.; asc. 30 ft. over broken E. slope.
79.72	The ¼ sec. cor. of secs. 7 and 8.
From the E 1/16 sec. cor. of secs. 8 and 17.	
	N. 0° 05' W., on the N. and S. center line of the SE¼ of sec. 8.
	Descend 65 ft. over N. slope, through scattering sagebrush.
6.45	Ravine, drains NW., also dirt road, 15 lks. wide, bears S. 50° E. and N. 50° W.; asc. 60 ft. over S. slope, across cultivated land.
12.00	Top of ascent, slopes W.; desc. 60 ft. over NW. slope.
14.40	Barbed wire fence, bears N. 60° E. and S. 60° W.
20.00	Point for the SE 1/16 sec. cor. of sec. 8 at intersection with the E. and W. center line of the SE¼.
	Set an iron post, 28 ins. long, 2½ ins. diam., 20 ins. in the ground, with brass cap mkd.
	SE 1/16 S 8 1980
	Set a 5½ ft. steel fence post alongside the iron post.
	Descend 5 ft. over N. slope.
20.20	Draw, drains S. 65° W.; asc. slightly over rolling land.
39.05	Dirt road, 10 lks. wide, bears N. 65° E. and S. 70° W.
40.00	The center E 1/16 sec. cor. of sec. 8.
From the S 1/16 sec. cor. of secs. 8 and 9.	
	N. 88° 21' W., on the E. and W. center line of the SE¼ of sec. 8.
	Descend 65 ft. over rolling land, through scattering sagebrush.
10.20	Barbed wire fence, bears N. 60° E. and S. 60° W.
19.935	The SE 1/16 sec. cor. of sec. 8. Descend slightly over NW. slope.

Subdivision of Section 8,  
T. 5 N., R. 31 E., Willamette Mer., Oregon

## CHAINS

20.10	Draw, drains S. 65° W.; asc. 40 ft. over rolling land.
39.87	The center S 1/16 sec. cor. of sec. 8.
	From the center W 1/16 sec. cor. of sec. 8. N. 0° 03' W., on the N. and S. center line of the NW $\frac{1}{4}$ of sec. 8. Descend 95 ft. over general N. slope, through scattering sagebrush.
0.60	Downed woven wire fence, bears E. and W.
19.97	Point for the NW 1/16 sec. cor. of sec. 8 at intersection with the E. and W. center line of the NW $\frac{1}{4}$ . Set an aluminum post, 28 ins. long, 2 $\frac{1}{2}$ ins. diam., 20 ins. in the ground, with aluminum cap mkd.
	NW 1/16 S 8 1980
	Set a 5 $\frac{1}{2}$ ft. steel fence post alongside the aluminum post. Descend 10 ft. over N. slope.
22.30	Draw, drains NE.; asc. 60 ft. over SE. slope.
29.25	Top of ascent, slopes E.; desc. 80 ft. over N. slope.
38.30	Downed barbed wire fence, bears N. 80° E. and S. 80° W.
39.94	The W 1/16 sec. cor. of secs. 5 and 8.
	From the center N 1/16 sec. cor. of sec. 8. N. 88° 25' W., on the E. and W. center line of the NW $\frac{1}{4}$ of sec. 8. Ascend 10 ft. over NE. slope, through scattering sagebrush.
1.00	Barbed wire fence, bears N. and S.
3.40	Top of ascent, slopes N.; desc. 40 ft. over NW. slope.
10.95	Draw, drains N. 55° E.; asc. 10 ft. over NE. slope.
13.45	Top of ascent, slopes N.; desc. 35 ft. over NW. slope.
19.925	The NW 1/16 sec. cor. of sec. 8. Corner is located at bottom of descent, slopes N.; asc. 85 ft. over rolling land.
39.85	The N 1/16 sec. cor. of secs. 7 and 8.

## GENERAL DESCRIPTION

The portion of Township 5 North, Range 31 East, which was resurveyed, is located approximately 4 $\frac{1}{2}$  miles north of the town of Holdman, Oregon. The area is

262

T. 5 N., R. 31 E., Willamette Meridian, Oregon

CHAINS

rolling terrain with elevations ranging from about 540 feet above sea level in Juniper Canyon on the north boundary of section 6 to about 1,580 feet above sea level on the line between sections 2 and 11.

The area is drained to the north by draws draining into Juniper Canyon and to the south by draws draining into Cold Springs Canyon. Water is scarce at most times of the year.

Access is gained by county and private roads which enter the area from Cold Spring Canyon and from Juniper Canyon.

The soil is sandy and subject to wind erosion. Portions of sections 2, 3, and 8 support dry land wheat farming. Sections 4, 5, 6, and 7 have areas of drifting sand, sagebrush, bunch grass, and cheat grass. Scattered Junipers are found on the slopes of Juniper Canyon. The area has a high range fire risk during dry periods.

There were no mineral deposits noted within the area.

The average of several readings throughout the area gives a value of 20° E. for the mean magnetic declination.

There is a range of 0° 30' due to local attraction.

22.30	Draw, drains NW; asc. 60 ft. over SE slope.
28.25	Top of ascent, slopes E; desc. 80 ft. over N. slope.
38.30	Downed barbed wire fence, bears N. 80° E. and S. 80° W.
39.94	The W 1/16 sec. cor. of secs. 2 and 8.
1.00	Barbed wire fence, bears N. and S.
3.40	Top of ascent, slopes N; desc. 40 ft. over NW slope.
10.95	Draw, drains N. 25° E.; asc. 10 ft. over NE slope.
13.45	Top of ascent, slopes N; desc. 35 ft. over NW slope.
19.925	The NW 1/16 sec. cor. of sec. 8.
39.85	The N 1/16 sec. cor. of secs. 7 and 8.

GENERAL DESCRIPTION

The portion of Township 5 North, Range 31 East which was surveyed, is located approximately 4 1/2 miles north of the town of Holdman, Oregon. The area is

Form 9600-11  
(August 1979)

UNITED STATES  
DEPARTMENT OF THE INTERIOR  
BUREAU OF LAND MANAGEMENT

FIELD ASSISTANTS

NAMES	CAPACITY
Richard S. Tandlich	Surveying Technician
Timothy J. Ingraham	Land Surveyor (Student Trainee)
Richard W. Gardner	Surveying Aid

*[Faint mirrored text from reverse side of page, including "CERTIFICATE OF APPROVAL" and "BUREAU OF LAND MANAGEMENT"]*

*[Faint mirrored text from reverse side of page, including "The foregoing field notes of the dependent survey of a portion of the west and north boundaries and subdivision lines, and the subdivision of sections 2, 3, 4, 6, 7, and 8, Township 2 North, Range 31 East, Willamette Meridian, Oregon, executed by William D. Kimmel, Cadastral Surveyor, having been critically examined and found correct, are hereby approved."]*

*[Faint mirrored text from reverse side of page, including "October 14, 1983" and "Chief Cadastral Surveyor of Oregon"]*

*[Faint mirrored text from reverse side of page, including "CERTIFICATE OF TRANSCRIPT" and "is a true copy of the original field notes"]*

*[Faint mirrored text from reverse side of page, including "Chief Cadastral Surveyor of Oregon" and "(Date)"]*

CERTIFICATE OF SURVEY

(I) ~~XXX~~, William D. Kimmel, Cadastral Surveyor, HEREBY

CERTIFY upon honor that, in pursuance of special instructions bearing date of the 14th day of May, 19 80, (I) ~~XXX~~ have dependently resurveyed a portion of the west and north boundaries and subdivisional lines, and subdivided sections 2, 3, 4, 6, 7, and 8, Township 5 North, Range 31 East,

of the Willamette Meridian, in the State of Oregon, which are represented in the foregoing field notes as having been executed by (me), ~~XXX~~ and under (my) ~~XXX~~ direction; and that said survey has been made in strict conformity with said special instructions, the Manual of Instructions for the Survey of the Public Lands of the United States, and in specific manner described in the foregoing field notes.

January 7, 1982

(Date)

*William D. Kimmel*

(Cadastral Surveyor)

(Date)

(Cadastral Surveyor)

CERTIFICATE OF APPROVAL

BUREAU OF LAND MANAGEMENT  
Denver, Colorado  
Portland, Oregon

The foregoing field notes of the dependent resurvey of a portion of the west and north boundaries and subdivisional lines, and the subdivision of sections 2, 3, 4, 6, 7, and 8, Township 5 North, Range 31 East, Willamette Meridian, Oregon,

executed by William D. Kimmel, Cadastral Surveyor,

having been critically examined and found correct, are hereby approved.

October 14, 1983

(Date)

*William W. Glenn*

(Chief, Cadastral Survey Examination and Approval Staff)  
Chief Cadastral Surveyor of Oregon

CERTIFICATE OF TRANSCRIPT

I CERTIFY That the foregoing transcript of the field notes of the above described surveys in \_\_\_\_\_, is a true copy of the original field notes.

(Date)

(Chief, Cadastral Survey Examination and Approval Staff)  
Chief Cadastral Surveyor of Oregon