


80.84
271.61
52.46
53.68

4159

Township No. 5 North Range No. 33 East Willamette Meridian.

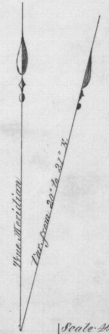

Scale 30 chains to an inch.

Description	Name of Deputy	Conveyed		Amount Received			When Completed
		No.	Date	Dollars	Cents	Fractions	
Subdivisions	Odell & Lewis	110	Dec. 7, 1855	50	79	16	May 5, 1855.
Total Acres	23020.26						

The above map of the Survey of Subdivisional lines in Twp. 5 N. R. 33 East Willamette Meridian, Oregon, is strictly conformable to the field notes of the survey stored on file in this office, which have been examined and approved. Surveyor General's Office, Eugene City, Feb'y 10 1886

E. L. Applegate
Surveyor General.