

FIELD NOTES

Of the survey of the Subdivision  
 Lines of Township 5 South  
Range 33 East, Willamette Meridian,  
 Oregon, as surveyed by George S.  
Pershin, U. S. Deputy Surveyor,  
 under his Contract No. 430, dated  
March 23<sup>rd</sup>, 1882

Survey commenced, May 29 1882  
 Survey completed, June 8<sup>th</sup> 1882

NAMES AND DUTIES OF ASSISTANTS.

- George S. Pershin, Compassman.
- James B. Ellis, Chainman.
- Frank F. Ellis, Chainman.
- \_\_\_\_\_, Chainman.
- \_\_\_\_\_, Chainman.
- Valentine Brown, Axeman.
- \_\_\_\_\_, Axeman.
- \_\_\_\_\_, Flagman.

297

PRELIMINARY OATHS OF ASSISTANTS:

We, James B. Ellis and  
Frank F. Ellis

do solemnly swear that we will faithfully execute the duties of Chain Carriers, that we will level the chain over even and uneven ground, and plumb the tally pins, either by sticking or dropping the same; that we will report the true distance to all notable objects, and the true length of all lines that we will assist in measuring, to the best of our skill and ability, and in accordance with the instructions given us

the survey of the Subdivision

lines of Township No 5 South  
Range 33 East Willamette Meridian, Oregon.

James B. Ellis, Chainman.

Frank F. Ellis, Chainman.

\_\_\_\_\_, Chainman.

\_\_\_\_\_, Chainman.

Subscribed and sworn to before me, this fifteenth  
day of May 1882.

[SEAL.]

George S. Perstein  
A. U. S. Deputy Surveyor

We, J. Valentine Brown and

do solemnly swear that we will well and truly perform the duties of Axemen in the establishment of corners and other duties, according to instructions given us, and to the best of our

skill and ability, in the survey of the Subdivision lines of

Township 5 S. R. 33 East Willamette Meridian Oregon.

Valentine Brown, Axeman.

\_\_\_\_\_, Axeman.

Subscribed and sworn to before me, this fifteenth  
day of May 15 1882.

[SEAL.]

George S. Perstein a  
U. S. Deputy Surveyor

See note page 3

# INDEX.

Referring the Lines to the Pages of the Field Notes.

T. *5 South* ..... R. *33 East* ..... Will. Mer.

6	120	5	88	4	66	3	44	2	22	1
118		116		86		64		42		20
7	114	8	84	9	62	10	40	11	18	12
112		110		82		60		38		16
18	108	17	80	16	58	15	36	14	14	13
106		104		78		56		34		12
19	102	20	76	21	54	22	32	23	10	24
100		98		74		52		30		8
30	96	29	72	28	50	27	28	26	6	25
94		92		70		48		26		4
31	90	32	68	33	44	34	24	35	2	36

Meanders of \_\_\_\_\_ Pages \_\_\_\_\_ to \_\_\_\_\_

Meanders of \_\_\_\_\_ Pages \_\_\_\_\_ to \_\_\_\_\_

Subdivisions of T. 5 South R. 33 East  
Willamette Meridian, Oregon.

Preliminary to commencing survey I run North on the East Boundary of Sec. 36 and at 79.92 The cor to Sec. 25 & 36 Then West on the South Boundary of Sec. 36 and at 39.98 the 1/4 sec. cor and at 79.95 the sec. cor. to 35 & 36 My compass runs the same lines and My chaining is practically the same as that of the Standard and exteriors.

Survey commenced May 29<sup>th</sup> 1882 With Burt's improved solar compass - Young of Philadelphia Maker - in good order and adjustment.

I begin at the Stone (about 6 inches out of ground) cor to Sec. 35 & 36 on South Boundary of Township A Tamarack 16 in. di. lrs. N. 75° E. 211 lrs dist marked T 5 S. R. 33 E. S 36 B. T. S. C. Pine 6 in. di. lrs. N. 38° W. 76 lrs dist marked T 5 S. R 33 E. S. 35. S C. B T

Submissions of T. 5 South R. 33 East  
Willamette Meridian, Oregon.

North between Sec. 35 and 36  
Va.

Ascending

- 18.00 Top of irregular ridge co. E & W. 200. ft. high
- 27.50 A ravine co. S. W. 150 descent
- 40.00 Top of ridge co. E & W. Set Pine post  
marked  $\frac{1}{4}$  S. on west side  
on level for  $\frac{1}{4}$  Sec. cor. from which  
A Fir 24 in. diam. brs. S.  $38^{\circ}$  E marked  $\frac{1}{4}$   
B. T. 16 lbs. dist
- A Pine 22 in. dia. brs. N.  $72^{\circ}$  W. 59 lbs. dist  
Marked  $\frac{1}{4}$  S. B. T.
- 80.00 Set a Basalt stone 14 x 10 x 8 in. 9 in. in  
ground for cor. to Sec. 25, 26, 35 & 36.  
Marked with one notch on S. and one not  
on E edges. South slope from which  
A Pine 10 in. dia. brs. N.  $84^{\circ}$  E. 63 lbs. dist  
Marked T 5 S, R. 33 E. S. 25, B T
- A Fir 8 in. dia. brs. S.  $48^{\circ}$  E. 68 lbs. dist  
Marked T 5 S. R. 33 E. S. 36. B T
- A Pine 14 in. dia. brs. S.  $82^{\circ}$  W. 34 lbs. dist  
Marked T 5 S, R. 33 E, S. 35. B T

Subdivisions of T. 5 South R. 33 East

Willamette Meridian, Oregon.

A Fir 16 ins. dia. br. N.  $62^{\circ}$  W. 16 lbs dist  
marked T 5 S, R. 33 & S. 26 BT

Land: Surface Mountainous. Soil 3<sup>rd</sup> rate. Some green timber but mostly burnt and dead and much of it down. Pin. Fir and Tamarack. Some under bush  
Same

X

\$10

The Justice of the Peace  
Mr. Caldwell of T. 5 S. R. 30 E  
was away on business and the  
nearest other officer qualified  
to administer affidavits was about  
25 or 30 miles distant. Therefore  
I think I was justifiable in  
administering <sup>the oaths to</sup> the affidavits of  
myself

assistant

4

304

Subdivisions of T. 5 South R. 33 East  
Willamette Meridian, Oregon.

East on a random line between Sec. 25 & 36

Var.  $20^{\circ} 15'$  East-

19.50 Hidaaway creek 60 lbs. wide co. North

300 feet below. sec. cor.

40.00 set temporary  $\frac{1}{4}$  sec. cor.

70.00 top of irregular hill 400 ft above creek

79.84 Intersected East Boundary 72 lbs

north of cor. to Sec. 25 and 36

which is a basalt stone

on S. E slope

A Fir 24 in di lbs. N.  $66^{\circ}$  E 55 lbs dist

marked T 5 S. R. 34 E. S. 30 B.T.

A Pine 12 in. dia. lbs. S.  $68^{\circ}$  E 98 lbs. dist

marked T 5 S. R. 34 E. S. 31 B.T.

A Pine 5 in. di. lbs. S.  $45^{\circ}$  W. 10 lbs dist

marked T 5 S. R. 33 E S 36 B.T

A Pine 10 in di. lbs. N.  $85^{\circ}$  W. 50 lbs dist

Marked T 5 S. R. 33 E. S. 25 B.T

from which cor. I run

N.  $89^{\circ} 29'$  West on a true line

between Sec. 25 and 36

Subdivisions of T. 5 South R. 33 East

Willamette Meridian, Oregon.

Pa. 19° 15' East -

39.92 Set a Basalt stone 16 x 8 x 7 ins 11 ins  
in ground on South Slope for 1/4 sec.  
cor. Marked 1/4 on N. side

A Pine 14 ins dia. br. N. 64° E. 36 lbs dist  
Marked 1/4 S. B.T.

A Pine 10 ins diam. br. S. 36° N. 48 lbs dist  
Marked 1/4 S. B.T.

79.84 The cor. to sec. 25, 26, 35 and 36

Land: Surface Mountainous,  
Soil 3<sup>rd</sup> rate; Mostly heavily timbered  
with Pine Fir and Tamarack  
timber with underbrush same  
Some open glades



Subdivisions of T. 5 South R. 33 East  
Willamette Meridian, Oregon.

North between Sec. 25 and 26  
ca.  $20^{\circ} 15'$  East

- 7.00 Top of rise & begin steep descent + 30 ft.
- 40.00 Set Tamarack post 4 ft long flattened  
to 3 inches thickness on E face of  
ridge marked  $\frac{1}{4}$  S on west face  
for  $\frac{1}{4}$  Sec. cor.
- A Fir 20 ins. dia. brs. S.  $54^{\circ}$  E. 25 lbs dist -  
marked  $\frac{1}{4}$  S. B.T.
- A Fir 20 ins. dia. brs. N.  $48^{\circ}$  W. 8 lbs dist  
marked  $\frac{1}{4}$  S. B.T.
- 77.00 Creek, 100 lbs. wide ca. N.W. descent 600 ft  
from top of bluff
- 80.00 Set basalt stone  $16 \times 12 \times 5$  ins.  $11$  in.  
in ground on level in creek bottom  
marked with 2 notches on S and one  
notch on E edges for cor to sec.  
23. 24. 25 & 26 from which
- A Pine 10 ins. dia. brs. N.  $62^{\circ}$  E. 33 lbs dist  
marked T 5 S. R. 33 E. S. 24 B.T.

307

Subdivisions of T. 5 South R. 33 East  
Willamette Meridian, Oregon.

A Fir 12 ins. dia. brs. S. 56° E. 65 lbs dist  
Marked T. 5 S. R. 33 E. S. 25. B.T.

A Spruce, 8 ins. dia. brs. N. 70° W. 34 lbs. dist  
Marked T. 5 S. R. 33 E. S. 23. B.T.

No tree S. W.

Land: Surface, very broken  
and mountainous; Soil, 3. & 2<sup>nd</sup>  
rate. <sup>timbered with</sup> heavily, Pine, Tamarack  
and Fir timber with  
underbrush same

8 10

350  
25  
—  
50

Subdivisions of T. 5 South R. 33 East  
Willamette Meridian, Oregon.

East on a random line between Sec.  
24 and 25

Pa. 20° 30' East

regular ascent S.W. face of bluff

4000. Set temporary  $\frac{1}{4}$  Sec. Cor.

79.36 Intersected E. Boundary 68 lbs. North  
of cor to Sec. 23 and 24 which is <sup>+700</sup>+700  
a stone about 8 in. above ground

A Pine 18 in. di. lbs. N. 46° E. 245 lbs. dist  
marked. T 5 S. R. 34 E. S. 19 BT

A Pine 12 in. di. lbs. S. 18° N. 158 lbs dist-  
marked. T 5 S. R. 33 E. S. 25 BT

No other trees marked

from which cor. I run  
N. 89° 31' West on a true line  
between Sec. 24 and 25

Pa. 19° 20' East

39.68 Set basalt Stone 18 x 10 x 6 ins

## Subdivisions of T. 5 South R. 33 East

Willamette Meridian, Oregon.

12 ins. in ground. on S.W. Slope  
 Marked  $\frac{1}{4}$  on N. face. for  $\frac{1}{4}$   
 Sec. cor.

A Pine 30 ins. di. brs. N.  $28^{\circ}$  E. 60 lbs. dist  
 Marked  $\frac{1}{4}$  S. B.T.

A Pine 14 ins. di. brs. S.  $48^{\circ}$  W. 36 lbs. dist  
 Marked  $\frac{1}{4}$  S. B.T.

79.36 The cor to Sec. 23. 24. 25 & 26

Land: Surface Mountain  
 Side Soil. 3<sup>rd</sup> rate. heavily timbered  
 with Pine timber with open  
 glades

\$10

May 29<sup>th</sup> 1882

## Subdivisions of T. 5 South R. 33 East

Willamette Meridian, Oregon.

North between Sec. 23. and 24  
 ve.  $20^{\circ} 30'$  East

4000 Top of mountain 800 ft above creek  
 Set basalt Stone  $14 \times 12 \times 5$  ins. 10 ins  
 in ground on level for  $\frac{1}{4}$  Sec. cor

A Pine 18 ins dia. lbs. N.  $54^{\circ}$  E. 33 lbs dist  
 Marked  $\frac{1}{4}$  S. B.T.

A Pine 17 ins dia. lbs. S.  $55^{\circ}$  W. 55 lbs dist  
 Marked  $\frac{1}{4}$  S. B.T.

8000 Set a pine post 4 ft long and 4 ins. <sup>-250</sup>  
 square for cor. to Sec. 13. 14. 23. & 24  
 about 250 ft below last  $\frac{1}{4}$  Sec. cor.  
 on north slope, and Marked

T 5 S. S. 13 on N. E

R. 33 E. S. 24 on S. E

S. 23 on S. W.

S. 14 on N. W. from which

A Pine 7 ins dia. lbs. N.  $21^{\circ}$  E 59 lbs. dist,

Mark. T 5 S. R. 33 E. S. 13. B.T.

A Pine 7 ins dia. lbs. S  $82^{\circ}$  E 10 lbs dist

Marked T. 5. S. R. 33. E. S 24 B.T

Subdivisions of T. 5 South R. 33 East  
Willamette Meridian, Oregon.

- A Tamarack, 10 ins dia. brs. S 56° W. 23 lbs. dist  
marked T 5 S. R. 33. E. S. 23 B T
- A Pine 7 ins. dia. brs. N. 68° W. 26 lbs dist  
marked T 5 S. R. 33. E. S. 14. B, T

Land: Surface Mountainous.  
Soil. 3" & 2" rate; <sup>timbered</sup> with  
Tamarack and Fir timber with  
open glades.

#10

Subdivisions of T. 5 South R. 33 East  
Willamette Meridian, Oregon.

East on a random line  
between Sec. 13 and 24

wa.  $20^{\circ} 15'$  East

- 1500 Spring branch co. N. W.  
4000 Set temporary  $\frac{1}{4}$  Sec. cor.  
5800 Top of hill 150 ft above sec. cor.  
7800 Spring branch co North 200 ft below  
79.64 Intersected E Boundary 74 lbs  
North of cor. to Sec. 13 and 24 which  
is a Stone on N. W. Slope  
marked with 3 notches on  
N. and 3 notches on S. edges

A Tamarack 18 in. di. lbs. N.  $34^{\circ} E$  36 lbs dist  
marked T 5 S. R. 34 E. S. 18 C. BT

A Tamarack 7 in di. lbs. S.  $58^{\circ} E$  33 lbs dist  
marked T 5 S. R. 34 E. S. 19 C. BT

A Tamarack 9 in. di. lbs. S. 42 N. 75 lbs dist  
marked T 5 S. R. 33. E S. 24 BT

A Tamarack, 10 in. dia lbs. N. 41 N. 96 lbs dist  
marked T 5 S. R. 33. E. S. 13. BT

from which corner I run

Subdivisions of T. 5 South R. 33 East

Willamette Meridian, Oregon.

N.  $89^{\circ}28'$  West on a true line  
between Sec. 13 and 24  
on  $20^{\circ}30'$  East-

3982 Set a Basalt Stone  $18 \times 14 \times 10$  ins.  
 $12$  ins in ground on west slope for  
 $\frac{1}{4}$  Sec cor. Marked  $\frac{1}{4}$  on N. face  
A Pine  $18$  ins dia. lrs. N.  $12^{\circ}$  W.  $106$  lrs dist  
marked  $\frac{1}{4}$  S. B.T.

A Pine  $10$  ins dia. lrs. S.  $67$  E.  $104$  lrs dist.  
Marked  $\frac{1}{4}$  S. B.T.

79.64 The cor to Sec. 13, 14, 23 and 24  
and Mountainous  
Land Surface broken, Soil  
 $3'$  &  $2'$  Late Pine, Tamarack  
& Fir timber with open glades



314

Subdivisions of T. 5 South R. 33 East  
Willamette Meridian, Oregon.

North between Sec. 13 and 14  
ca.  $20^{\circ} 15'$  East

9.25 Brook 5 lks wide co. N. W. descent 50 ft  
40.00 Set post 4 ft long 4 in diam 2 ft in  
ground marked  $\frac{1}{4}$  S. on west face, on  
North Slope for  $\frac{1}{4}$  Sec. cor.

A Fir 7 in diam. lrs. N.  $70^{\circ}$  E. 36 lks dist  
marked  $\frac{1}{4}$  S. B.T.

A Fir 17 in. dia. lrs. S.  $68^{\circ}$  N. 12 lks dist  
marked  $\frac{1}{4}$  S. B.T.

80.00 Set basalt stone  $12 \times 10 \times 8$  ins. 8 ins. in  
ground for cor. to Sec. 11. 12. 13 & 14  
mark with 4 notches on S and  
1 notch on E edges from which

A Pine 12 ins dia. lrs. N.  $28^{\circ}$  E. 62 lks dist  
marked T 5 S. R 33 E. S. 12 B.T.

A Pine 12 ins dia. lrs. S.  $47^{\circ}$  E. 137 lks dist  
marked T 5 S. R. 33 E. S. 13 B.T.

A Pine 10 ins. dia. lrs S.  $67^{\circ}$  N. 122 lks dist  
marked T. 5 S R. 33 E. S 14 B.T.

315

Subdivisions of T. 5 South R. 33 East  
Willamette Meridian, Oregon.

A. Pine 14 ins. di. br. A. 70° N. 141 lbs dist  
marked T 5 S. R. 33. E S. 11. BT

Land: Surface broken  
Soil 3 & 2<sup>nd</sup> rate. <sup>timbered with</sup> heavily, Pine  
Fir & Tamarack timber with  
under brush same.  
Some open glades

#10

316

Subdivisions of T. 5 South R. 33 East

Willamette Meridian, Oregon.

Cast on a random line  
between Sec. 12 and 13

wa.  $19^{\circ} 30'$  East

Irregular broken surface

40.00 Set temporary  $\frac{1}{4}$  Sec. cor

44.00 Spring branch co N. E

71.50 " " " North

80.12 Intersected E Boundary 43 lbs

north of cor to Sec. 12 and 13

which is a stone projecting 6 ins

above ground. 2 Notches on N. & 4 notches on

South edges

A Pine 15 ins di. lbs N.  $28^{\circ}$  E 21 lbs dist

Marked T' 5 S. R. 34 E. S. 7 B.T.

A Pine 16 ins di. lbs. S.  $38^{\circ}$  E. 55 lbs. dist

Marked T' 5 S. R. 34 E. S. 18 B.T.

A Pine 18 ins di. lbs. S.  $40^{\circ}$  W. 93 lbs dist

Marked T' 5 S. R. 33 E. S. 13. B.T.

A Pine 24 ins di. lbs N.  $66^{\circ}$  W. 46 lbs dist

Marked T' 5 S. R. 33 E. S. 12 B.T.

from which cor I run

Subdivisions of T. 5 South R. 33 East  
Willamette Meridian, Oregon.

N. 89° 42' West on a true line  
between Sec. 12 and 13  
on 20° 00' East -

40.06 Set a basalt stone 18 x 10 x 5 ins  
12 ins in ground on E slope for  
1/4 sec. cor. marked 1/4 on N face  
A Fir 14 in dia. brs. North 16 lbs dist  
marked 1/4 S. T. B.

A Tamarack, 14 ins. dia. brs. S. 54° W. 76 lbs. dis.  
marked 1/4 S. B. T.

80.12 Theor to Sec. 11, 12, 13 & 14  
Land: Surface broken. Soil  
3" & 2" rate. ~~heavily~~ heavily timbered <sup>with</sup> in  
Tamarack & Fir timber  
with open glades

#110



Subdivisions of T. 5 South R. 33 East  
Willamette Meridian, Oregon.

North between Sec. 11 & 12

Ca.  $19^{\circ} 30'$  East

Irregular descent

4000 Set basalt stone  $12 \times 10 \times 8$  ins. 8 ins  
in ground on North slope for  
 $\frac{1}{4}$  sec. cor. marked  $\frac{1}{4}$  on N.  
face from which a

A Tamarack 8 ins. dia. brs. S.  $80^{\circ} E$  37 lbs dist

Marked  $\frac{1}{4}$  S. B.T.

A Pine 5 in di. brs. S.  $82^{\circ} W$ . 18 lbs dist

Marked  $\frac{1}{4}$  S. B.T.

8000 Set basalt stone  $18 \times 8 \times 5$  ins.

12 ins in ground for cor to Sec.

1. 2. 11 & 12 marked with 5

notches on S and 1 notch on

E edges. This point 150 ft below

last sec. cor.

A Tamarack 16 in. dia. brs. N.  $78^{\circ} E$ . 54 lbs dist

marked T. 5 S. R. 33 E. S. 1 B.T.

A Pine 4 in. dia. brs. S.  $36^{\circ} E$ . 42 lbs dist

(Marked T. 5 S. R. 33 E. S. 12 B.T.)

Subdivision of T. 5 South R. 33 East  
Willamette Meridian, Oregon.

A Pine 30 in. dia. brs. S. 10° W. 20 lbs. dist  
Marked T 5 S. R. 33. E. S 11. B. T.

A Tamarack. 10 in. dia. brs. N. 70° W. 52 lbs dist  
Marked T 5 S. R. 33 E. S. 2 B. T.

Land: Surface rolling north  
Slope, Soil 2' & 3' note  
mostly open scattering Pine  
and Tamarack timber  
Small amount of underbrush

## Subdivisions of T. 5 South R. 33 East

Willamette Meridian, Oregon.

East on a random line  
between Sec. 1 and 12  
on a 20° 30' East—

20.50 Spring branch co North

40.00 Set temporary 1/4 Sec. cor.

48.00 Wagon road to hot sulphur  
springs on Sec. 12. co. N. W. & S. E.

54.50 brook 10 lks wide course North

79.78 Intersected East Boundary  
58 lks north of cor to Sec. 1 & 12  
which is a stone projecting  
about 5 ins. above ground

A Pine 6 ins dia lrs. N. 9° E 90 lks dist

Marked T' 5 S R. 34 E S 6 B T

A Pine 8 ins dia lrs. S. 66° E 88 lks dist

Marked T' 5 S R. 34 E S 7 B T

A Pine 8 ins dia lrs S. 75° N. 138 lks dist

Marked T' 5 S R. 33 E S. 12 B T.

A Pine 8 ins. dia lrs. N. 48° N. 139 lks. dist

Marked T' 5 S R. 33 E S. 1 B T

from which cor I run

Subdivisions of T. 5 South R. 33 East  
Willamette Meridian, Oregon.

N. 89° 35' West on a true line  
between Sec. 1 & 12  
or, 19° 45' East -

39.89 Set-basalt stone 20 x 10 x 3 in, 15 in  
in ground on N.W. slope for 1/4  
Sec. cor. Marked 1/4 on N. face

A Pine 24 in dia. lbs. N. 36° W 30 lbs dist  
marked 1/4 S. B.T.

A Pine 8 in dia. lbs. S. 52° E. 33 lbs dist  
marked 1/4 S. B.T.

79.78 The cor. to Sec. 1, 2, 11, & 12

Land: Surface rolling  
Soil 2' 3' & small part 1' rate  
open scattering Pine &  
Tamarack timber #8

James Lehman's improve-  
ment is on N.E. 1/4 of Sec. 12  
but is not visible from  
any line



## Subdivisions of T. 5 South R. 33 East

Willamette Meridian, Oregon.

North on a random line  
between Sec. 1 & 2

wa.  $20^{\circ} 30'$  East-

Gradual descent-

21.00 Creek bottom open prairie E. & W.

40.00 Set temporary  $\frac{1}{4}$  Sec. cor.

42.50 Road Co. N. W. & S. E. to hot sulphur Springs

76.50 Cameo creek 30 lbs wide co west-

descent about 100 ft-

79.84 Intersected North Boundary

38 lbs west of cor to Sec. 1 & 2

which is a stone projecting

about 7 inches above ground

A Pine 20 ins dia. lbs. N.  $52^{\circ}$  E. 160 lbs dist

marked T' 4 S. R. 33 E. S. 36 BT

A Pine 44 ins dia. lbs. S.  $46^{\circ}$  E 126 lbs. dist

marked T' 5 S. R. 33. E. S. 1 BT

A Pine 30 ins dia lbs. S.  $16^{\circ}$  W. 27 lbs. dist

marked T' 5 S R. 3.3. E. S. 2 BT

from which cor I run

323

Subdivisions of T. 5 South R. 33 East  
Willamette Meridian, Oregon.

S.  $00^{\circ} 16'$  West on a true line  
between Sec. 1 & 2  
ra.  $18^{\circ} 15'$  East

39,84 Set basalt stone  $16 \times 7 \times 6$  ins.  $11$  ins  
in ground, on level, at small grove  
of Pine trees. for  $\frac{1}{4}$  sec. cor. Marked  
 $\frac{1}{4}$  on N. face from which  
A Pine 8 in. dia. brs. S.  $58^{\circ} E$  23 lbs dist  
marked  $\frac{1}{4}$  S. B, T.

A Pine 7 ins. dia. brs. N.  $51^{\circ} W$  33 lbs dis.  
marked  $\frac{1}{4}$  S. B, T.

79,84 The cor. to Sec. 1, 2, 11 & 12

Land: Surface level and undu-  
lating: Soil 1<sup>st</sup> & 2<sup>nd</sup> rate  
Some scattering Pine timber  
good natural meadow on  
north 60 chs. good farming  
land

James Lehmanns Improvement  
is on N. E  $\frac{1}{4}$  of Sec. 12 but cannot be seen from  
the line  
May. 30 1882

24

324

Subdivision of T. 5 South R. 33 East

Willamette Meridian, Oregon.

North between Sec. 34 & 35—  
ca.  $19^{\circ} 15'$  East—

The cor to this line is a  
Post on North slope from which  
A Tamarack 18 in. di. lrs. N.  $28^{\circ} E$  42 lks dist

marked T5S. R. 33E. S. 35 S.C. B.T  
A Tamarack 10 in di. lrs. N.  $46^{\circ} W$ . 57 lks dist  
marked T5S. R. 33E. S. 34. S.C. B.T

18.00 A brook 6 lks wide co west  
descent about 50 ft—

39.00 Spring branch co. S. W.

40.00 Set post 4 ft long 4 in diam  
on level at Spring branch  
for  $\frac{1}{4}$  Sec. cor. Marked  $\frac{1}{4} S$   
on west face from which

A Pine 7 in. diam. lrs. N.  $66^{\circ} E$ , 23 lks dist  
marked  $\frac{1}{4} S$ . B.T.

A Pine 11 in. di. lrs. S.  $72^{\circ} W$ . 30 lks dist  
marked  $\frac{1}{4} S$ . B.T.

74.00 Top of hill 150 ft above brook

Subdivisions of T. 5 South R. 33 East  
 Willamette Meridian, Oregon.

325

8000 Set a Tamarack post 4 ft long  
 4 in square on North slope for  
 cor to Sec. 26, 27, 34 and 35

2 ft in ground marked

T 5 S. S. 26 on N. E

R. 33 E S. 35 on S E

S. 34 on S. W.

S. 27 on N. W from which

A Pine 10 in. dia. brs. N.  $53^{\circ}$  E. 22 lbs. dist

marked. T 5 S. R. 33 E. S. 26. B. T.

A Pine 10 in. dia. brs. S.  $74^{\circ}$  E. 16 lbs dist

marked T 5 S. R. 33 E. S. 35 B. T.

A Tamarack. 4 in. dia. brs. S  $68^{\circ}$  W. 25 lbs dist

marked T 5 S. R. 33 E. S. 34 B. T.

A Tamarack 12 in. dia brs. N.  $24^{\circ}$  W. 78 lbs dist

marked. T 5 S. R. 33 E. S. 27 B. T.

Land: Surface rolling soil 3' + 2'  
 rate; some timber Pine & Tamarack  
 timber nearly all burnt and  
 dead. large part fallen #18

## Subdivisions of T. 5 South R. 33 East

Willamette Meridian, Oregon.

East on a random line  
between Sec. 26 & 35  
wa.  $20^{\circ} 45'$  East

Surface rolling

4000 Set temporary  $\frac{1}{4}$  Sec cor

62.00 Spring branch cor N. W.

79.32 On N. & S line 42 lbs North of  
cor to Sec 25, 26, 35 and 36 from  
which cor. B run

N.  $89^{\circ} 42'$  West on a true line  
between Sec. 26 & 35  
wa.  $20^{\circ} 15'$  East

39.66 A Pine 8 in diam. on S.E. slope  
for  $\frac{1}{4}$  Sec. cor. marked  $\frac{1}{4}$  S. on  
North side. from which

A Pine 8 in diam. br. N.  $48^{\circ}$  E. 9 lbs. dist  
marked  $\frac{1}{4}$  S. B, T.

A Pine 8 in diam. br. South 6 lbs dist  
marked  $\frac{1}{4}$  S. B, T.

79.32 The cor to Sec 26, 27, 34 & 35

Subdivisions of T. 5 South R. 33 East <sup>327</sup>

Willamette Meridian, Oregon.

Land! Surface part rolling  
and part broken. Soil  
2<sup>nd</sup> & 3<sup>rd</sup> rate. Mostly  
dense young Pine &  
Tamarack timber some  
Fir a few open glades

\$ 10

## Subdivisions of T. 5 South R. 33 East

Willamette Meridian, Oregon.

North between Sec. 26 & 27  
 wa.  $20^{\circ} 45'$  East -

Gradually descending

4000 Set post 4 ft long 4 in diam  
 2 ft in ground on North slope  
 for  $\frac{1}{4}$  Sec. cor marked  $\frac{1}{4}$  S  
 on west face from which

A Tamarack, 6 in. diam brs. S.  $52^{\circ}$  E. 39 lbs dist  
 marked  $\frac{1}{4}$  S. B.T.

A Pine 5 in. dia. brs S.  $70^{\circ}$  W. 11 lbs dist  
 marked  $\frac{1}{4}$  S. B.T.

79.00 Creek 50 lbs wide co. N. W.  
 descent 600 feet

8000 Set a post 4 ft long 4 in square  
 2 ft in ground on North side of  
 creek in creek bottom on level  
 for cor to Secs. 22, 23, 26 & 27  
 marked.

T 5 S. S. 23 on N. E

R. 33 E. S 26 on S. E

S. 27 on S. W

S. 22 on N. W from which

Subdivisions of T. 5 South R. 33 East  
 Willamette Meridian, Oregon.

A Pine 8 in diam. br. N.  $28^{\circ}$  E. 58 lbs dist -

Marked T 5 S. R. 33 E. S. 23. B.T.

A Fir 18 in. dia. br. S  $5^{\circ}$  E. 12 lbs dist

Marked T 5 S. R. 33 E S. 26. B.T.

A Pine 10 in. dia. br. S.  $68^{\circ}$  W. 120 lbs dist

Marked T 5 S. R. 33 E. S. 27 B.T.

A Fir 7 in. dia. br N.  $22^{\circ}$  W. 22 lbs dist

Marked T 5 S. R. 33 E. S. 22 B.T.

Land: Surface Mountainous

Soil 3<sup>rd</sup> rate small part 2<sup>nd</sup> rate

Timber mostly burnt & dead

Some green Pine Tamarack

and Fir

8/10

My Latitude which I take  
 here indicates approximately  
 $45^{\circ} 4'$  North



Subdivisions of T. 5 South R. 33 East

Willamette Meridian, Oregon.

East on a random line  
between Sec 23 & 26  
ba.  $20^{\circ} 00'$  East

The creek runs almost due west along  
this mile and crosses the line a great  
number of times. I therefore offset  
North 5.00 chs. and run east on  
a blank line.

40.00 Measure South 5.00 chs & set Temporary  
 $\frac{1}{4}$  Sec. cor.

79.62 Intersected N. & S line 43 lks north  
of cor to Sec 23. 24. 25 & 26 from  
which cor. I run  
N.  $89^{\circ} 42'$  West on a true line  
between Sec. 23 & 26  
ba.  $20^{\circ} 30'$  East

39.81 A Fir 10 in dia. for  $\frac{1}{4}$  Sec. cor.  
marked  $\frac{1}{4}$  S. on North face

A Fir 20 in di. brs. N.  $41^{\circ} 06'$  43 lks dist  
no other green tree near

331

## Subdivisions of T. 5 South R. 33 East

Willamette Meridian, Oregon.

79.62 The cor. to Sec. 22, 23, 26, &amp; 27

Land surface mostly creek bottom  
 Some abrupt spurs extending  
 from the creek bluff

Soil 2<sup>d</sup> rate some B<sup>d</sup> rate  
 Mostly very dense pine timber  
 burnt and dead in a few  
 places

#10

Subdivisions of T. 5 South R. 33 East  
Willamette Meridian, Oregon.

North between Sec. 22 and 23  
ra.  $20^{\circ} 00'$  East

21.00 Spring branch co. S.W.

40.00 Set a post 4 ft long 4 in diam 2 ft  
in ground on S.E. slope for  
 $\frac{1}{4}$  Sec. cor. marked  $\frac{1}{4}$  S.  
on West face

A Tamarack 20 in. di. brs. S.  $3^{\circ}$  E. 21 lbs. dist.  
marked  $\frac{1}{4}$  S. B.T.

A Tamarack 10 in. di. brs. S.  $80^{\circ}$  W. 37 lbs dist  
marked  $\frac{1}{4}$  S. B.T.

62.00 Top of irregular hill ascent - 600 ft

80.00 A Point 50 ft lower set a basalt  
Stone  $12 \times 10 \times 5$  in. 8 in. in ground  
on west slope for cor to Sec. 14, 15,  
22, & 23. mark with 3 notches  
on S. and 2 notches on E edges

A Pine 32 in. di. brs. N.  $3^{\circ}$  E. 58 lbs dist  
marked T. 5 S. R. 33 E. S. 14 B.T.

A Pine 30 in dia brs. S.  $87^{\circ}$  E. 14 lbs dist  
marked T. 5 S R. 33 E. S 23. B.T.

Subdivisions of T. 5 South R. 33 East  
 Willamette Meridian, Oregon.

A Pine 20 in. dia brs N. 43 W. 24 lbs dist  
 marked T. 5 S. R. 33 E. S. 15' B T  
 no tree S. W.

Land: Surface Mountainous  
 Soil 3<sup>rd</sup> & 2<sup>nd</sup> rate. Mostly  
 heavily timbered with some  
 open glades Pine. Tam-  
 arack & Fir

\$ 10

Subdivisions of T. 5 South R. 33 East  
Willamette Meridian, Oregon.

East on a random line  
between Sec 14 & 23  
wa.  $20^{\circ} 45'$  East

Ascending

40.00 Set temporary  $\frac{1}{4}$  Sec. cor.

64.50 Spring branch co. North

80.38 Intersected N. & S. line 62 lks  
north of cor. to Sec. 13. 14. 23 & 24

from which cor. I run  
N.  $89^{\circ} 33'$  West on a true line  
between Sec. 14 and 23  
wa.  $20^{\circ} 15'$  East

40.19 Set post 4 ft long 4 in diam 2 ft  
in ground on N. E. Slope for  
 $\frac{1}{4}$  Sec. cor. marked  $\frac{1}{4}$  S. on  
North Side

A Tamarack 15 in. dia. lks. North 10 lks dist  
marked  $\frac{1}{4}$  S. B. T.

A Fir 12 in. dia. lks. S.  $22^{\circ}$  E. 27 lks. dist  
marked  $\frac{1}{4}$  S. B. T.

80.38 The cor. to Sec. 14. 15. 22 and 23

Subdivisions of T. 5 South R. 33 East

Willamette Meridian, Oregon.

Land: Surface rolling. Soil  
3<sup>rd</sup> rate mostly heavily timbered with  
Tamarack and Fir timber  
with some open glades

#10

May 31<sup>st</sup> 1882

## Subdivisions of T. 5 South R. 33 East

Willamette Meridian, Oregon.

North between Sec. 14 and 15  
 wa.  $20^{\circ} 45'$  East

Irregular descent -

4000 Set post 4 ft long. 4 in diam.

2 ft in the ground on N. slope  
 for  $\frac{1}{4}$  Sec. Marked  $\frac{1}{4}$  S. on N. side

A Fir 10 in dia. brs. S.  $65^{\circ}$  E 24 lbs dist  
 marked  $\frac{1}{4}$  S. B.T.

A Fir 8 in dia brs. N.  $70^{\circ}$  W 47 lbs dist  
 marked  $\frac{1}{4}$  S. B.T.

8000 A point 200 ft below last sec cor  
 Set basalt stone  $16 \times 8 \times 7$  in. 11 in  
 in ground on East slope for cor.

To Sec. 10, 11, 14 and 15. marked  
 with 4 notches on the S. and 2 notches  
 on E ~~side~~ edges from which

A Fir 10 dia brs. N.  $23^{\circ}$  E 70 lbs dist  
 marked T 5 S. R 33 E. S. 11 B.T.

A Tamarack 12 in. dia. brs. S.  $28^{\circ}$  E, 62 lbs. dist  
 marked T 5 S. R. 33 E. S. 14 B.T.

Submissions of T. 5 South R. 33 East

337

Willamette Meridian, Oregon.

A Pine 14 in. dia. hrs. S. 64° W. 14 lbs dist  
marked T. 5 S. R. 33 E. S. 15 BT

A Pine 16 in. dia. hrs. N. 21° W. 93 lbs. dist  
marked T. 5 S. R. 33 E. S 10 BT

Land: Surface broken. Soil  
3<sup>rd</sup> & 2<sup>nd</sup> rate heavily timbered  
with Pine, Tamarack & Fir  
timber with some open  
glades

#10



Subdivisions of T. 5 South R. 33 East  
Willamette Meridian, Oregon.

East on a random line  
between Sec. 11 and 14  
wa.  $20^{\circ} 45'$  East -

9,75 Brook 6 lbs wide to North  
40,00 Set temporary  $\frac{1}{4}$  sec cor  
54,00 Spring branch co. N. W.  
80,18 Intersected N. & S. line 66 lbs  
North of cor. to Sec. 11, 12, 13 & 14  
from which cor I run  
N.  $89^{\circ} 32'$  West on a true line  
between Sec. 11. & 14  
wa.  $19^{\circ} 30'$  East

40,09 Set basalt Stone  $12 \times 10 \times 8$  in. 8 in  
in ground on N. E. S slope for  
 $\frac{1}{4}$  sec. cor. marked  $\frac{1}{4}$  on N. face

A Pine 14 in. dia. lbs. N.  $68^{\circ} E$  67 lbs dist  
marked  $\frac{1}{4}$  S. BT

A Pine 18 in. di. lbs. S.  $10^{\circ} W$ . 73 lbs dist  
marked  $\frac{1}{4}$  S. BT

80,18 The cor. to Sec. 10, 11, 14 & 15

## Subdivisions of T. 5 South R. 33 East

Willamette Meridian, Oregon.

Land: Surface rolling,  
Soil 2 & 3' rate. Mostly open  
Scattering Pine Timber

# 8

340

Subdivisions of T. 5 South R. 33 East  
Willamette Meridian, Oregon.

North between Sec. 10 and 11  
wa.  $20^{\circ} 45'$  East

Descending

40,000 Set a basalt Stone  $12 \times 10 \times 6$  in  
8 in. in ground on slight north  
slope for  $\frac{1}{4}$  Sec. cor. marked  
 $\frac{1}{4}$  on west face

A Tamarack, 10 in. dia. brs N.  $51^{\circ}$  E. 22 lbs dist  
marked  $\frac{1}{4}$  S. B.T.

A Tamarack 10 in. dia. brs N.  $31^{\circ}$  W. 19 lbs dist  
marked  $\frac{1}{4}$  S. B.T.

78.75 Spring branch co. N. E descent 150 ft-

80,000 Set a basalt Stone  $17 \times 10 \times 8$  in  
Mound of Stone on rocky S. E  
slope for cor to Sec. 2, 3, 10 and  
11. marked with 5 notches on S  
and 2 notches on E edges

A Pine 12 in. diam. brs. N.  $58^{\circ}$  E. 86 lbs dist  
marked T 5 S. R. 33 E. S. 2. B.T.

A Pine 10 in. dia. brs. S.  $60^{\circ}$  E. 54 lbs dist  
marked T 5 S. R. 33 E S. 11 BT

Subdivisions of T. 5 South R. 33 East  
Willamette Meridian, Oregon.

A Pine 9 in. dia. br. S. 4° W. 42 lbs dist  
marked T 5 S. R. 33 E. S. 10 B T  
no tree N. W

Land: Surface rolling: Soil  
3<sup>rd</sup> & 2<sup>nd</sup> rate, heavily timbered  
with Pine Tamarack & Fir timber  
with open glades

10

342  
 Subdivisions of T. 5 South R. 33 East  
 Willamette Meridian, Oregon.

East on a random line  
 between Sec. 2 and 11  
 wa.  $20^{\circ} 30'$  East

4.00 Brook 12 lks wide co North

40.00 Set temporary  $\frac{1}{4}$  Sec. cor.

80.04 Intersected N & S line 66 lks  
 North of cor. to Sec. 1, 2, 11 & 12  
 from which cor. I run  
 N.  $89^{\circ} 32'$  West on a true line

between Sec. 2 and 11  
 wa.  $20^{\circ} 30'$  East

40.02 Set basalt stone  $12 \times 10 \times 6$  ins. 8 in  
 in ground on N. W. slope for  
 $\frac{1}{4}$  Sec. cor. Marked  $\frac{1}{4}$  on N. face

A Fir 12 in. dia. brs. N.  $31^{\circ}$  E. 26 lks. dist  
 marked  $\frac{1}{4}$  S. B. T.

A Pine 20 in. dia. brs. S.  $28^{\circ}$  W. 13 lks dist  
 marked  $\frac{1}{4}$  S. B. T.

80.04 The cor. to Sec. 2, 3, 10 & 11

Subdivisions of T. 5 South R. 33 East  
Willamette Meridian, Oregon.

Land: Surface undulating  
Soil. 3<sup>rd</sup> & 2<sup>nd</sup> rate: open  
Scattering Pine timber

#8

Subdivisions of T. 5 South R. 33 East  
Willamette Meridian, Oregon.

North on a random line  
between Sec. 2 and 3  
ra.  $20^{\circ} 30'$  East

Descending


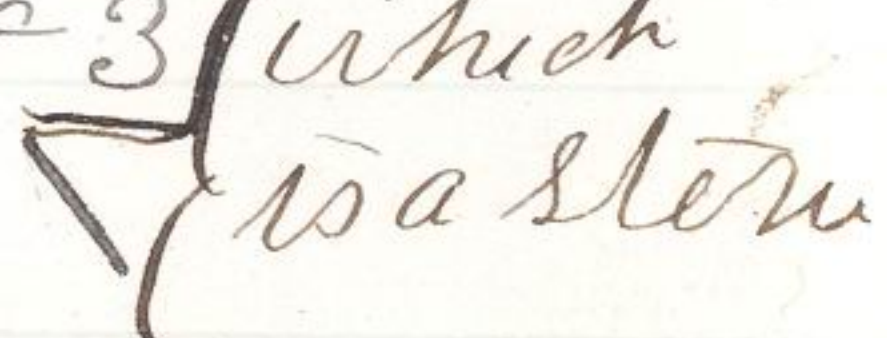
40.00 Set temporary  $\frac{1}{4}$  Sec. cor.

66.50 Fence co. S. E & N. W.

70.00 Creek 30 lbs wide co. west -  
descent 120 feet -

76.50 Fence co. E & W. Leave field

79.60 Intersected North Boundary

 26 lbs west of cor. to Sec. 2 & 3 which  
from which cor I run  is a stone

S.  $00^{\circ} 11'$  West on a true line  
between Sec. 2 and 3

ra  $20^{\circ} 00'$  East -

39.60 Set a basalt stone  $14 \times 10 \times 8$  on  
East slope 10 in. in ground for  
 $\frac{1}{4}$  Sec. cor. Marked  $\frac{1}{4}$  on west-  
face

A Tamarack 16 in. dia. brs. N.  $22^{\circ} E$ . 59 lbs dist -  
marked  $\frac{1}{4}$  S. B. T.

Subdivisions of T. 5 South R. 33 East  
Willamette Meridian, Oregon.

A Pine 5 ins. dia. brs N. 17° W. 61 lks. dist.  
marked 1/4 S. B. T.

79.60 The cor. to Sec. 2. 3. 10. & 11

Land; Surface undulating  
Soil 2" & 1" rate; some  
Scattering Pine & Tamarack  
timber but mostly open  
larger part good farming  
land

Robert H Redman's  
improvement is on Sec. 2.  
his house is near the center of  
the Sec. but not visible from the  
lines

A Pine 7 ins dia brs S. 64° E. 44 lks distant  
marked T 5 S. R. 33 E S 2 B T

A Pine 14 ins. dia brs, S. 3° W. 56 lks dist  
marked T 5 S. R. 33 E S. 3 B T

no other trees

June 1<sup>st</sup> 1882



Subdivisions of T. 5 South R. 33 East  
Willamette Meridian, Oregon.

North between Sec. 33 & 34  
Pa.  $19^{\circ}15'$  East

This cor. is a stone about 6 in  
above ground from which a  
A Pine 5 in. dia. brs. N.  $52^{\circ}$  E 35 lbs dist  
Marked T 5 S, R. 33 E, S. 34 S.C. B.T.  
A Pine 10 in dia. brs. N.  $34^{\circ}$  W. 11 lbs dist  
Marked T 5 S, R. 33 E S. 33 S.C. B.T.

Ascending

4000 A point about 100 ft above Sec. cor  
Set post 4 ft long 4 in diam  
2 ft in ground  
on level for  $\frac{1}{4}$  Sec. cor. marked  
 $\frac{1}{4}$  S on West side

A Pine 5 ins. dia. brs S.  $12^{\circ}$  E 20 lbs dist  
Marked  $\frac{1}{4}$  S. B.T.

A Pine 44 ins dia brs N.  $68^{\circ}$  W. 27 lbs dist  
Marked  $\frac{1}{4}$  S. B.T.

8000 Set basalt stone  $12 \times 10 \times 7$  ins  
8 ins in ground on level for  
Cor. to Sec. 27, 28, 33, & 34,  
Marked with one notch

Subdivisions of T. 5 South R. 33 East  
Willamette Meridian, Oregon.

on South and 3 notches on  
E edges from which

A Pine 8 ins dia. brs N.  $76^{\circ}$  E. 62 lbs dist

marked T 5 S. R. 33 E. S. 27 B.T.

A Pine 11 ins dia. brs S.  $45^{\circ}$  E 80 lbs. dist

marked T 5 S. R. 33 E. S. 34 B.T.

A Pine 12 ins dia. brs S.  $37^{\circ}$  W. 30 lbs dist

marked T 5 S. R. 33 E. S. 33 B.T.

A Pine 8 ins dia. brs. N.  $61^{\circ}$  W. 36 lbs dist

marked T 5 S. R. 33 E. S. 28 B.T.

Land: Surface, slightly rolling  
Soil 2 & 3<sup>rd</sup> rate. Mostly heavily  
timbered some open glades  
Pine Tamarack and Fir

## Subdivisions of T. 5 South R. 33 East

Willamette Meridian, Oregon.

East on a random line  
between Sec. 27 and 34  
ca.  $19^{\circ} 30'$  East

4000 Set temporary  $\frac{1}{4}$  sec. cor.

79.90 Intersected N. & S. line 28 lbs

North of cor. to Sec. 26, 27, 34 & 35

from which cor. I run

N.  $89^{\circ} 48'$  West on a true line  
between Sec. 27. and 34

ca.  $20^{\circ} 45'$  East

39.95 Set a basalt stone  $12 \times 10 \times 5$  ins.  
& ins. in ground on N.W. slope  
for  $\frac{1}{4}$  sec. cor. marked  $\frac{1}{4}$  on  
North face

A Pine 20 in dia. lbs N.  $62^{\circ} E$  42 lbs, dist.

marked  $\frac{1}{4}$  S. B.T.

A Tamarack 16 in. dia. lbs. S.  $21^{\circ} E$  18 lbs dist

marked  $\frac{1}{4}$  S. B.T.

79.90 The cor. to Sec. 27, 28, 33 & 34

Subdivisions of T. 5 South R. 33 East

Willamette Meridian, Oregon.

Land: Surface rolling;  
Soil 2<sup>nd</sup> & 3<sup>rd</sup> rate: heavily tim-  
bered with Pine Tamarack  
and Fir timbe with some  
open glades under brush  
the same

50 350

Subdivisions of T. 5 South R. 33 East

Willamette Meridian, Oregon.

North between Sec. 27 and 28  
wa.  $19^{\circ} 30'$  East-

13.00 Spring branch co west

40.00 Set a basalt stone  $12 \times 8 \times 6$  ins.

8 ins in ground on North slope

for  $\frac{1}{4}$  Sec. cor. marked

$\frac{1}{4}$  on West face

A Pine 16 ins dia brs. N.  $36^{\circ}$  E 36 lbs dist

marked  $\frac{1}{4}$  S. B.T.

A Pine 12 ins dia. brs. S.  $85^{\circ}$  W. 27 lbs dist

marked  $\frac{1}{4}$  S. B.T.

79.75 Creek 75 lbs wide co. N.  $60^{\circ}$  W. - 500 ft

80.00 In creek. I offset N. 85 lbs

and establish the cor. a Fir

10 in diam. on level near creek

for offset cor. to Sec. 21. 22. 27. & 28

Marked T 5 S. S. 22 on N. E

R. 33 E. S. 27 on S. E

S. 28 on S. W.

S. 21 on N. W.

## Subdivisions of T. 5 South R. 33 East

Willamette Meridian, Oregon.

A Fir 10 in dia. brs. N.  $37^{\circ}$  E 46 lbs dist  
marked T 5 S. R. 33 E S. 22. B, T

A Pine 8 in dia. brs N.  $12^{\circ}$  W. 31 lbs. dist  
marked T 5 S. R. 33 E S. 21 B, T,

No. trees S. E & S. W. all dead

Land: Surface mountainous  
Soil 3<sup>rd</sup> & 2<sup>nd</sup> rate: Heavily timber  
ed with Pine Tamarack & Fir timber  
Much of it burnt and dead  
Some open glades

#10

52 352

Subdivisions of T. 5 South R. 33 East  
Willamette Meridian, Oregon.

East on a random line  
between Sec. 22 & 27  
Ra.  $20^{\circ} 15'$  East

creek bottom & crop creek a number  
of times

4000 Set temporary  $\frac{1}{4}$  Sec. cor.

79.68 Intersected N. & S. 46 lbs north of  
cor. to Sec. 22. 23. 26 & 27 from  
which cor.  $\mathcal{D}$  run

N.  $89^{\circ} 40'$  West on a true line  
between Sec. 22 & 27  
Ra.  $20^{\circ} 00'$  East -

39,84 Set basalt stone  $12 \times 10 \times 8$  in  
 $8$  in in ground on level in  
creek bottom on North side  
of creek for  $\frac{1}{4}$  Sec. cor.

marked  $\frac{1}{4}$  on North face

A Tamarack 16 in. dia. brs S.  $12^{\circ} E$  74 lbs dist -  
marked  $\frac{1}{4}$  S. B. T.

A Pine 9 in dia. brs N.  $52^{\circ} E$  27. lbs dist  
marked  $\frac{1}{4}$  S. B. T.

Subdivisions of T. 5 South R. 33 East ~~353~~

Willamette Meridian, Oregon.

79.68 The cor. to Sec. 21. 22. 27 & 28

Land: Surface nearly level  
creek bottom. Soil 2<sup>nd</sup> rate;  
mostly dense timber and  
brush. black Pine, willow  
and Alder with a few  
openings

#10



54

354

Subdivisions of T. 5 South R. 33 East  
Willamette Meridian, Oregon.

North between Sec. 21. & 22  
ca.  $20^{\circ} 15'$  East

16,000 on hill + 250 feet & begin descent

40,000 Set post 4 ft long 4 in diam

2 ft in ground on North

Slope for  $\frac{1}{4}$  Sec. cor. marked

$\frac{1}{4}$  S. on West side

A Tamarack 8 in. dia. brs. N.  $52^{\circ}$  E 22 lbs dist

marked  $\frac{1}{4}$  S. B. T.

A Tamarack 10 in. dia. brs. N.  $34^{\circ}$  W. 35 lbs dist

marked  $\frac{1}{4}$  S. B. T.

59,000 A brook 6 lbs wide co. west - 100 ft

80,000 Set a basalt stone  $20 \times 14 \times 4$  ins

15 ins in ground, on slight

west slope for cor. to Sec 15, 16, 21

and 22. marked with three

notches on S. and 3 notches on

E. edges

A Pine 14 ins. dia. brs N.  $36^{\circ}$  E. 140 lbs dist

marked. T 5 S R. 33. E. S. 15 B T.

Subdivisions of T. 5 South R. 33 East  
Willamette Meridian, Oregon.

A Pine 20 in. dia. brs. S. 45° E. 185 lbs. dist  
marked T' 5 S, R. 33 E. S. 22 B.T.

A Pine 12 in. dia. brs. S. 5° W. 40 lbs dist  
marked T' 5 S R. 33 E S 21 B.T.

A Pine 14 in. dia. brs. N. 32° W. 83 lbs. dist  
marked T' 5 S R. 33 E S 16 B.T.

Land: Surface broken with  
Soil 3<sup>rd</sup> & 2<sup>nd</sup> rate <sup>timbered with</sup> heavily Pine  
Tamarack & Fir timber with  
underbrush the same; some  
open glades

\$10

56356

Subdivisions of T. 5 South R. 33 East  
Willamette Meridian, Oregon.

East on a random line  
between Sec. 15 & 22  
wa.  $19^{\circ} 30'$  East

4000 Set temporary  $\frac{1}{4}$  Sec. cor

79.64 Intersected N. & S. line 58 lks  
north of cor to Sec. 14, 15, 22 and  
23. from which cor. I run  
N.  $89^{\circ} 35'$  West on a true line  
between Sec. 15 & 22

wa.  $20^{\circ} 45'$  East

39.82 Set post 4 ft long and 4 in.  
diam. 2 ft in ground on  
west slope for  $\frac{1}{4}$  Sec. cor.

marked  $\frac{1}{4}$  S. on north side

A Pine 8 in dia. brs. N.  $54^{\circ}$  W. 30 lks dist  
marked  $\frac{1}{4}$  S. B.T.

A Tamarack 8 in. dia. brs. South 15 lks dist,  
marked  $\frac{1}{4}$  S. B.T.

79.64 The com. to Sec. 15, 16, 21 & 22.

357  
357

Subdivisions of T. 5 South R. 33 East  
Willamette Meridian, Oregon.

Lands: Surface undulating  
Plateau; Soil 2<sup>nd</sup> & 3<sup>rd</sup> rate;  
mostly open some Pine  
Tamarack & Fir timber

#8

June 2<sup>nd</sup> 1882

Subdivisions of T. 5 South R. 33 East  
Willamette Meridian, Oregon.

North between Sec. 15 & 16  
wa.  $19^{\circ} 30'$  East—

31.50 Spring branch co. west

32.00 Large open glade co. E & W.

40.00 Set post 3 feet long 4 in dia.  
on level in mound of stone  
for  $\frac{1}{4}$  sec. cor. marked  
 $\frac{1}{4}$  S. on west side

no trees.

68.00 enter timber again co. E & W

80.00 Set basalt stone  $12 \times 10 \times 5$  in. in  
open glade on level 8 in. in  
ground for cor. to Sec. 9. 10. 15  
and 16. Marked with 4  
notches on S and 3 notches  
on E edges. & raised mound  
of stone along side

A Pine 16 in. dia. brs. N.  $51^{\circ}$  E. 149 lbs dist.  
Marked T. 5 S. R. 33 E. S. 10 B.T.

A Pine 20 in dia. brs. S.  $40^{\circ}$  E 170 lbs dist.  
Marked T. 5 S R. 33 E. S. 15 B.T.

Subdivisions of T. 5 South R. 33 East 359

Willamette Meridian, Oregon.

No trees S. W. & N. W.

Land: Surface undulating;  
Soil 2<sup>nd</sup> & 3<sup>rd</sup> rate; mostly open  
Some Pine and Tamarck  
timber

#8

60

360

Subdivisions of T. 5 South R. 33 East  
Willamette Meridian, Oregon.

East on a random line  
between Sec. 10 & 15  
wa.  $19^{\circ} 30'$  East

32,50 Spring branch co. North descent  
about 150 ft

4000 Set temporary  $\frac{1}{4}$  Sec. cor.

79.78 Intersected N. & S. line 38 lks.  
North of cor. to Sec. 10, 11, 14 & 15  
from which cor. I run  
N.  $89^{\circ} 44'$  West on a true line  
between Sec. 10 and 15  
wa.  $20^{\circ} 45'$  East

39,89 Set basalt stone  $14 \times 12 \times 8$  ins.

70 ins in ground for  $\frac{1}{4}$  Sec. cor.

on level. marked  $\frac{1}{4}$  on  
North face from which

A Tamarack 16 in. dia. brs. N.  $54^{\circ}$  W. 40 lks. dist.

marked  $\frac{1}{4}$  S. B.T.

A Pine 26 in. dia. brs. S.  $54^{\circ}$  E. 47 lks. dist.

marked  $\frac{1}{4}$  S. B.T.

Subdivisions of T. 5 South R. 33 East

Willamette Meridian, Oregon.

79.78 The cor to Sec. 9, 10, 15 and 16

Land: Surface rolling.

Soil 3<sup>rd</sup> & 2<sup>nd</sup> rate,

mostly open. Some Pine  
and Tamarack timber  
very scattering

\$8



62

362

Subdivisions of T. 5 South R. 33 East  
Willamette Meridian, Oregon.

North between Sec. 9 & 10

va.  $19^{\circ} 30'$  East

Slightly descending

3750 Spring branch co. N.W.  
descent 100 ft

4000 A Pine 9 in dia. on S.W. slope  
for  $\frac{1}{4}$  Sec. cor. Marked  
 $\frac{1}{4}$  S. on west side

A Pine 5 ins. dia. brs. N.  $71^{\circ}$  E. 74 lbs dist  
Marked  $\frac{1}{4}$  S. B.T.

A Pine 10 ins. dia. brs. N.  $86^{\circ}$  W. 36 lbs dist  
Marked  $\frac{1}{4}$  S. B.T.

8000 Set a basalt stone  $15 \times 10 \times 5$  ins. 10 ins  
in ground on west hill-side  
for cor. to Sec 3, 4, 9 & 10  
Marked with 5 notches on S  
and 3 notches on E edges

A Pine 10 ins. dia. brs. S.  $14^{\circ}$  E. 121 lbs. dist  
Marked T. 5 S. R. 33 E. S 10 B.T.

A Pine 18 ins. dia. brs. S.  $66^{\circ}$  W. 105 lbs dist  
Marked T 5 S. R. 33 E. S 9 B.T.

Subdivisions of T. 5 South R. 33 East  
Willamette Meridian, Oregon.

no other trees near raised mound of stone alongside in line thereof

Land: Surface undulating  
Soil 3<sup>rd</sup> & 2<sup>nd</sup> rate. Some Pine and Tamarack timber but mostly open

My observation on Latitude here indicates approximately  $45^{\circ} 7'$  North

64 364

Subdivisions of T. 5 South R. 33 East  
Willamette Meridian, Oregon.

East on a random line  
between Sec. 3 and 10  
wa.  $20^{\circ} 15'$  East

4000 Set temporary  $\frac{1}{4}$  Sec. cor.

80.18 Intersected N. & S. line 32 lks  
North of cor to Sec. 2, 3, 10 & 11  
from which cor  $\mathcal{L}$  run  
N.  $89^{\circ} 46'$  West on a true line  
between Sec. 3 & 10

wa.  $20^{\circ} 30'$  East

4009 Set post 4 ft long 4 in diam  
2 ft in ground on north slope  
for  $\frac{1}{4}$  Sec. cor. marked  
 $\frac{1}{4}$  S. on North side

A Tamarack. 24 in. diam. brs. N.  $15^{\circ}$  E. 8 lks. dist  
marked  $\frac{1}{4}$  S. B, T.

A Fir 8 in. diam. brs. S.  $5^{\circ}$  E. 45 lks dist  
marked  $\frac{1}{4}$  S. B, T.

80.18 The cor. to Sec. 3, 4, 9 & 10

Subdivisions of T. 5 South R. 33 East 365

Willamette Meridian, Oregon.

Land: Surface rolling,  
Soil 2<sup>nd</sup> and 3<sup>rd</sup> rate, Open  
Scattering Pine and Tamarack  
timber with open glades

88

66

366

Subdivisions of T. 5 South R. 33 East  
Willamette Meridian, Oregon.

North on a random line  
between Sec. 3 and 4  
(ba.  $20^{\circ} 15'$  East -

Descending

12.00 Spring branch co. A. E.

40.00 Set Temporary  $\frac{1}{4}$  Sec. cor.

79.74 Intersected North Boundary

22 hrs. west of cor. to Sec.  
3 and 4. which is a stone  
about 8 in. above ground (descent  
about 200 ft) marked with  
3 notches on East and west  
edges. Mound of stone along side

A Pine 8 ins dia. hrs.  $S. 8^{\circ} W. 102$  hrs  
dist marked T'5S, R. 33 E. S 4 BT'

from which cor. I run

Subdivisions of T. 5 South R. 33 East

Willamette Meridian, Oregon.

S. 00° 09' West on a true line  
between Sec. 3 & 4

aa. 18° 30' East

39.74 Set a basalt Stone 18 x 12 x 7 ins  
12 ins in ground on E slope  
for 1/4 Sec. cor. Marked 1/4 on  
west face from which  
A Tamarack 13 in. dia. br. N. 85° E 37 lbs dist  
marked 1/4 S. B.T.

A Fir 18 in. dia. br. N. 20° W. 16 lbs dist  
marked 1/4 S. B.T.

79.74 The cor. to Sec. 3. 4. 9 & 10

Land: surface rolling. Soil  
3<sup>rd</sup> and 2<sup>nd</sup> rate; open  
Scattering Pine Tamarack  
and Fir timber with open  
glades. North 1/2 mile nearly all  
open prairie

June 3<sup>rd</sup> 1882

#8

Subdivisions of T. 5 South R. 33 East  
Willamette Meridian, Oregon.

North between Sec. 32 & 33  
Cra.  $19^{\circ} 10'$  East

This cor. is a post in mound of  
Stone from which

A Pine 10 in. di. brs. N.  $70^{\circ} E$  32 lbs dist.  
marked T 5 S. R. 33 E S. 33 S. C. B.T

A Pine 12 in di. brs. N.  $17^{\circ} W$ . 70 lbs dist.  
marked T 5 S. R. 33 E S 32. S. C. B.T

rolling and slightly ascending

40.00 Set a basalt stone  $15 \times 8 \times 7$  ins.  $10$  ins  
in ground on level for  $\frac{1}{4}$  sec.

cor. marked  $\frac{1}{4}$  on West face

A Pine 4 in. di. brs. N.  $76^{\circ} E$  61 lbs. dist.

marked  $\frac{1}{4}$  S. B.T.

A Pine 14 in. dia. brs. S.  $78^{\circ} W$ . 61 lbs dist

marked  $\frac{1}{4}$  S. B.T.

80.00 Set a basalt stone  $15 \times 9 \times 7$  ins.

$10$  ins. in ground on level for

cor to Sec. 28, 29, 32 and 33

marked with 1 notch on S. and 4  
notches on E. Edges

## Subdivisions of T. 5 South R. 33 East

Willamette Meridian, Oregon.

A Pine 10 ins dia. brs. S. 34° W. 53 lbs. dist  
 marked T 5 S. R. 33 E. S. 32 B. T.

A Pine 28 ins. dia. brs. N. 67° W. 103 lbs dist  
 marked T 5 S. R. 33, E. S. 29 B T

No trees; open glade east - raised  
 mound of stone along-side in lieu  
 of pits

Land: Surface undulating  
 Soil 2<sup>nd</sup> & 3<sup>rd</sup> rate; open scatter-  
 ing Pine timber with large  
 open glades.



70 370

Subdivisions of T. 5 South R. 33 East  
Willamette Meridian, Oregon.

East on a random line  
between Sec. 28 and 33  
wa.  $20^{\circ} 15'$  East

- 16.00 Enter timber co N. & S.  
40.00 Set temporary  $\frac{1}{4}$  Sec. cor.  
64.50 Spring branch co north  
79.84 Intersected N. and S. line 26 lbs  
north of cor to Sec 27, 28, 33 & 34  
from which cor. I run  
N.  $89^{\circ} 49'$  West on true line  
between Sec. 28 and 33  
wa.  $19^{\circ} 30'$  East

39.92 A Pine 8 in dia. on west slope  
for  $\frac{1}{4}$  Sec. cor. marked  $\frac{1}{4}$  S. on  
North side

A Pine 8 ins. dia. brs. N.  $18^{\circ}$  E 20 lbs dist.  
marked  $\frac{1}{4}$  S. B.T.

A Pine 6 ins. dia. brs. S.  $42^{\circ}$  W. 16 lbs dist  
marked  $\frac{1}{4}$  S. B.T.

79.84 The cor. to Sec 28, 29, 32 & 33

71  
371

Subdivisions of T. 5 South R. 33 East  
Willamette Meridian, Oregon.

Land: Surface undulating  
Soil 2<sup>nd</sup> & 3<sup>rd</sup> rate, open  
scattering Pine and Tamarack  
timber with large open  
glades;

#8

Subdivisions of T. 5 South R. 33 East  
Willamette Meridian, Oregon.

North between Sec. 28 and 29

wa.  $20^{\circ} 15'$  East-

9.00 Enter Timber co. E & W.

40.00 Set a basalt stone  $12 \times 10 \times 8$  ins.

8 ins in ground on level for

$\frac{1}{4}$  sec. cor. marked  $\frac{1}{4}$  on W. face

A Pine 11 in dia. brs. N.  $74^{\circ}$  E. 60 lbs dist

marked  $\frac{1}{4}$  S. B.T.

A Pine 10 in dia. brs. N.  $45^{\circ}$  W. 64 lbs dist

marked  $\frac{1}{4}$  S. B.T.

80.00 Set a basalt stone  $14 \times 12 \times 4$  ins.

10 ins in ground on E slope in

small open glade for cor. to

Sec. 20, 21, 28 and 29 marked with

2 notches on S. and 4 notches on

E edges

A Pine 42 in dia. brs. N.  $69^{\circ}$  E. 118 lbs. dis.

marked T 5 S. R. 33 E. S. 21 B.T.

A Pine 16 in dia. brs. S.  $44^{\circ}$  E. 56 lbs. dist

marked T 5 S. R. 33 E. S. 28 B.T.

Subdivisions of T. 5 South R. 33 East  
Willamette Meridian, Oregon.

A Tamarack, 5 ins. dia. brs. S. 45° W. 86 lbs dist  
marked T 5 S R. 33 E. S. 29 B. T.

A Pine 28 ins. dia. brs. N. 40° W. 136 lbs dist  
marked T 5 S. R. 33 E. S. 20 B. T.

Land! Surface undulating  
Soil 2<sup>nd</sup> and 3<sup>rd</sup> rate; heavily Pine  
Tamarack and Fir timbered;  
underbrush same; some  
open glades

\$10

74 374

Subdivisions of T. 5 South R. 33 East  
Willamette Meridian, Oregon.

East on a random line  
between Sec. 21 & 28  
wa.  $20^{\circ} 30'$  East

Descending

40.00 Set temporary  $\frac{1}{4}$  Sec. cor.

57.00 creek 60 lbs wide from East  
to N.W. descent about 350 ft -  
here  $\perp$  offset south 250 lbs then  
east

80.10 Intersect N. & S line and return  
from offset, to a point 18 lbs  
North of cor to Sec 21, 22, 27, & 28  
from which cor.  $\perp$  run  
N.  $89^{\circ} 52'$  West on a true line  
between Sec. 21 & 28  
wa.  $20^{\circ} 15'$  East

40.05 Set a basalt stone 15 x 10 x 7 ins  
10 ins in ground on N.E. slope  
for  $\frac{1}{4}$  Sec. cor. marked  $\frac{1}{4}$  on  
north face from which

Subdivisions of T. 5 South R. 33 East 375  
 Willamette Meridian, Oregon.

A Pine 20 ins dia. brs. N. 10° W. 19 lbs dist  
 marked  $\frac{1}{4}$  S. B.T.

A Fir 8 ins dia. brs. S 54° E 13 lbs dist  
 marked  $\frac{1}{4}$  S. B.T.

<sup>80,10</sup>  
 80,10 The cor. to Sec. 20, 21, 28 & 29

Land: Surface partly rolling  
 and partly level: soil 3<sup>rd</sup> & 4<sup>th</sup>  
 2<sup>nd</sup> rate, heavily timbered Pine  
 Tamarack and Fir timber  
 with some open glades

\$10

Subdivisions of T. 5 South R. 33 East  
Willamette Meridian, Oregon.

North between Sec. 20 & 21

wa.  $20^{\circ} 30'$  East

Descending on E face of bluff

4000 Set a basalt stone  $16 \times 10 \times 8$  ins

12 ins in ground on E slope

for  $\frac{1}{4}$  Sec. cor. Marked  $\frac{1}{4}$  on  
west face from which

A Pine 5 ins dia. brs. N.  $66^{\circ}$  E. 32 lbs dist

Marked  $\frac{1}{4}$  S. B.T.

A Pine 8 ins dia brs. S.  $67^{\circ}$  W. 71 lbs dist

Marked  $\frac{1}{4}$  S. B.T.

8000 Set a basalt stone  $18 \times 8 \times 7$  in - 300

12 ins in ground on steep

N.E. slope for cor. to Sec.

16, 17, 20 and 21. Marked with

3 notches on S. and 4 notches on

E edges from which

A Fir 8 ins dia, brs. N.  $72^{\circ}$  E. 44 lbs dist,

Marked T 5 S. R. 33 E. S 16 B T

A Tamarack 18 ins dia. brs. S.  $53^{\circ}$  E. 53 lbs. dist

Marked T 5 S, R. 33 E. S. 21 B.T.

Subdivisions of T. 5 South R. 33 East 377  
 Willamette Meridian, Oregon.

A Fir 8 ins dia hrs. S. 64° W. 26 lbs dist.  
 marked T 5 S. R. 33 E S 20 B, T.

A Fir 28 ins. dia. hrs. N. 40° W. 9 lbs dist  
 marked T 5 S. R. 33 E. S. 17. B, T.

Land: Surface broken E face of  
 creek bluff. Soil 3" + 2" red  
 heavily timbered; Pine Tamarack  
 and Fir timber with  
 some open glades



78

378

## Subdivisions of T. 5 South R. 33 East

Willamette Meridian, Oregon.

East on a random line  
between Sec. 16 & 21

wa.  $19^{\circ} 15'$  East -

4,500 Creek 50 lbs wide co N. W.  
descent 100 ft -

4,000 Set temporary  $\frac{1}{4}$  Sec. cor.

5,000 Spring branch co South

7,992 Intersected N. & S line 34 lbs  
North of cor. to Sec. 15, 16, 21 & 22 -  
Ascent 250 - from which cor  
D run

N.  $89^{\circ} 45'$  West on a true line  
between Sec. 16 and 21

wa.  $19^{\circ} 30'$  East -

3,996 Set a basalt stone  $18 \times 12 \times 4$  in  
12 ins in ground on point of spur  
Extending South for  $\frac{1}{4}$  Sec. cor.  
marked  $\frac{1}{4}$  on N. face.

A Pine 28 in. dia. lbs. N.  $22^{\circ}$  W. 100 lbs dist  
marked  $\frac{1}{4}$  S. B, T

Subdivisions of T. 5 South R. 33 East 379

Willamette Meridian, Oregon.

A Pine 20 in. di. brs S. 28° E 15 lbs dist  
marked 1/4 S. B.T.

79.92 The cor to Sec. 16, 17, 20 and 21  
Land: Surface broken  
Soil 3<sup>rd</sup> & 2<sup>nd</sup> rate, heavily tim-  
bered with Pine Tamarack and  
Fir timber with open  
glades

June 4<sup>th</sup> 1882

80

380

Subdivisions of T. 5 South R. 33 East

Willamette Meridian, Oregon.

North between Sec. 16 & 17

Pa.  $19^{\circ}15'$  East

4,750 Creek 50 lbs wide co. N. W.  
descent 125 ft

along up west face of E creek bluff

4,000 Set a basalt stone  $17 \times 8 \times 3$  ins

12 ins in ground on west

slope for  $\frac{1}{4}$  sec. cor. marked

$\frac{1}{4}$  on West face

A Fir 30 in. dia. brs. S.  $72^{\circ}$  E 20 lbs dist

marked  $\frac{1}{4}$  S. B.T.

A Pine 30 ins dia brs. N.  $30^{\circ}$  W. 39 lbs dist

marked  $\frac{1}{4}$  S. B.T.

7,550 Large open glade co. E & W.

8,000 Ascent 400 ft from creek. Set

a post 4 ft long 4 in square and

marked stone in mound of stone

on level for cor. to Sec. 8, 9, 16 and

17, marked T 5 S, S. 9 on N. E

R 33 E S. 16 on S. E

S. 17 on S. W

S 8 on N. W

Subdivisions of T. 5 South R. 33 East  
Willamette Meridian, Oregon.

also 4 notches on S. and 4 notches  
on E edges

Basalt stone 16 x 8 x 5 - in  
marked with 4 notches on  
S. and 4 notches on E edges

Soil 60 chs. mountainous  
Land: surface, greater part  
broken steep bluff. Soil  
3<sup>rd</sup> rate small part 2<sup>nd</sup> rate  
Timber partly thick and  
partly scattering. Pine  
Tamarack and Fir

## Subdivisions of T. 5 South R. 33 East

Willamette Meridian, Oregon.

East on a random line  
between Sec. 9 and 16

ba.  $19^{\circ} 00'$  East

9.00 Enter scattering timber  
40.00 Set temporary  $\frac{1}{4}$  sec. cor

80.04 Intersected N & S. line 58 lbs  
north of cor. to Sec. 9, 10, 15 and 16  
from which cor. I run

N.  $89^{\circ} 35'$  West on a true line  
between Sec. 9 and 16

ba.  $19^{\circ} 30'$  East

40.02 Set a basalt stone  $12 \times 10 \times 5$  ins.  
8 ins in ground on slight  
East slope for  $\frac{1}{4}$  sec. cor.  
marked  $\frac{1}{4}$  on N. face

A Pine 22 ins di. lbs. N.  $52^{\circ} E$ . 48 lbs dist  
marked  $\frac{1}{4}$  S. B. T.

A Pine 30 in. dia. lbs. S.  $26^{\circ} E$ . 31 lbs dist  
marked  $\frac{1}{4}$  S. B. T.

80.04 The cor. to Sec. 8, 9, 16 and 17

Subdivisions of T. 5 South R. 33 East

Willamette Meridian, Oregon.

Land: Surface undulating.  
Soil 3<sup>rd</sup> and 2<sup>nd</sup> rate, open  
Scattering Pine timber  
with open glades.

Subdivisions of T. 5 South R. 33 East  
Willamette Meridian, Oregon.

North between Sec. 8 and 9  
wa.  $19^{\circ} 00'$  East

6,500 Enter timber to S.E. & N.W

40,000 Set a basalt Stone  $16 \times 10 \times 8$  in  
11 ins in ground on slight  
N.E. slope for  $\frac{1}{4}$  Sec. cor.

Marked  $\frac{1}{4}$  on W. face

A Pine 12 ins dia. brs. N.  $40^{\circ}$  E. 67 lbs dist

Marked  $\frac{1}{4}$  S. B.T.

A Pine 16 ins dia. brs. N.  $36^{\circ}$  W. 26 lbs dist

Marked  $\frac{1}{4}$  S. B.T.

8,000 Descent 150 ft - Set basalt Stone

$16 \times 8 \times 6$  ins. 11 ins in ground on  
slight N.W. slope for cor. to

Sec. 4, 5, 8 and 9 marked with

5 notches on S. and 4 notches  
on E edges

A Tamarack 8 ins dia brs. N.  $43^{\circ}$  E 20 lbs dist

Marked T 5 S. R. 33 E. S. 4 B.T.

A Tamarack 8 ins dia. brs. S.  $15^{\circ}$  E 60 lbs dist

Marked T 5 S R. 33 E. S. 9 B.T.

Subdivisions of T. 5 S. out R. 33 East  
Willamette Meridian, Oregon.

A Tamarack. 10 ins dia brs. S. 30° W. 28 lbs. dist  
marked T 5 S. R. 33 E. S. 8 BT

A Fir 6 ins dia. brs. N. 40° W. 49 lbs. dist  
marked T 5 S. R. 33 E S. 5 BT

Land: Surface undulating  
Soil 3<sup>rd</sup> & 2<sup>nd</sup> rate: mostly open  
Scattering Pine Tamarack  
and Fir timber with  
open glades



86

386

Subdivisions of T. 5 South R. 33 East

Willamette Meridian, Oregon.

East on a random line  
between Sec. 4 & 9

va.  $20^{\circ}$  East

Surface rolling

40.00 Set temporary  $\frac{1}{4}$  Sec. cor

45.00 Top of main ridge cor. N. & S  
ascent - 100 ft -

77.25 Spring branch cor. north  
descent - 100 ft -

80.08 Intersected N. & S. line

18 lbs. north of cor. to  
Sec. 3, 4, 9 and 10 from  
which cor. 2 run

N.  $89^{\circ} 52'$  West on a true  
line between Sec. 4 and 9  
va.  $20^{\circ} 15'$  East -

40.04 Set a basalt stone  $17 \times 10 \times 7$  ins  
 $12$  ins in ground on slight  
west slope for  $\frac{1}{4}$  Sec. cor.  
marked  $\frac{1}{4}$  on its face

Subdivisions of T. 5 South R. 33 East  
Willamette Meridian, Oregon.

A Pine 10 ins. dia. brs. N.  $61^{\circ}$  E. 43 lbs. dia  
marked  $\frac{1}{4}$  S. B.T.

A Pine 10 ins. dia. brs. S.  $52^{\circ}$  W. 105 lbs. dia  
marked  $\frac{1}{4}$  S. B.T.

<sup>80.08</sup> 30.08 The cor. to sec. 4. 5. 8. and 9

Land: surface rolling  
Soil 3<sup>rd</sup> & 2<sup>nd</sup> rate mostly  
open scattering Pine  
Damarack and Fir  
timber with open  
glades

Subdivisions of T. 5 South R. 33 East  
Willamette Meridian, Oregon.

North on a random line  
between Sec. 4 and 5  
wa.  $20^{\circ} 00'$  East

4.50 Ravine co. N. E. descent 50 ft

40.00 Set temporary  $\frac{1}{4}$  sec. cor

79.68 Intersected North Boundary

42 lbs. west of cor. to sec.

4 and 5 ~~from~~ which is a

Stone about 6 inches above ground

A Fir 18 ins dia. lbs. N.  $20^{\circ}$  E. 25 lbs dist

marked T'4 S. R. 33 E S. 33 BT

A Pine 11 ins dia. lbs. S.  $14^{\circ}$  E 30 lbs dist

marked. T'5 S. R. 33 E S. 4 BT

A Pine 6 ins dia. lbs. S.  $20^{\circ}$  W. 27 lbs dist

marked. T'5 S R. 33 E S. 5 BT

A Pine 10 ins. dia. lbs. N.  $68^{\circ}$  W. 38 lbs dist

marked. T'4 S. R. 33 S 32 BT

from which I run

S.  $00^{\circ} 18'$  West on a true line

between Sec. 4 and 5

Subdivisions of T. 5 South R. 33 East  
Willamette Meridian, Oregon.

wa.  $20^{\circ} 15'$  East

39.68 Set a basalt stone  $15 \times 10 \times 5$  ins  
10 ins in ground on E slope  
for  $\frac{1}{4}$  sec. cor. marked

$\frac{1}{4}$  on West face from which  
A Pine 6 in. dia. brs. N.  $72^{\circ}$  E 48 lbs. dist.  
marked  $\frac{1}{4}$  S. B.T.

A Pine 8 in. dia. brs. west-16 lbs. dist  
marked.  $\frac{1}{4}$  S. B.T.

79.68 The cor. to Sec. 4, 5, 8 and 9

Land: Surface broken  
Soil 3<sup>rd</sup> rate, dense young  
Pine Tamarack and Fir  
timber with underbrush  
same. Some open glades

330  
 Subdivisions of T. 5 South R. 33 East -  
 Willamette Meridian, Oregon.

North between Sec. 31 & 32  
 ca.  $19^{\circ} 00'$  East

This cor. is a basalt stone in  
 mound of stone projecting about 6 in.  
 A Pine 6 in. dia. brs. N.  $46^{\circ}$  E. 19 lbs dist

Marked T 5 S. R. 33 E. S. 32 S. C. B.T.  
 A Pine 40 in. dia. brs. N.  $67^{\circ}$  W. 39 lbs. dist  
 Marked T 5 S. R. 33 E. S. 31. S. C. B.T.

14.50 Leave timber co. E & W. enter  
 small prairie

40.00 Set a basalt stone  $14 \times 10 \times 6$  ins  
 10 ins. in ground on level  
 for  $\frac{1}{4}$  sec. cor. Marked  
 $\frac{1}{4}$  on W. face

A Pine 20 in. dia. brs. N.  $48^{\circ}$  E 28 lbs dist.  
 Marked  $\frac{1}{4}$  S. B.T.

A Pine 42 ins dia brs. N.  $46^{\circ}$  W. 92 lbs. dist  
 Marked  $\frac{1}{4}$  S. B.T.

40.50 Enter timber co. S. E & N. W

391

Subdivisions of T. 5 South R. 33 East -  
Willamette Meridian, Oregon.

8000 Set a basalt-stone 18 x 12 x 7 ins  
12 in in ground on level for  
cor. to Sec. 29, 30, 31 and 32  
Marked with 1 notch on S  
and 5 notches on E edges

A Tamarack 12 in. dia. brs. N. 64° E 15 lbs dist  
marked T 5 S. R. 33 E. S. 29. B T

A Tamarack 10 in. di. brs S. 82° E 45 lbs. dist  
marked T 5 S. R. 33 E. S 32 B, T.

An Alder. 8 in. dia. brs. S. 88° W. 43 lbs dist  
marked T 5 S R. 33 E. S 31 B T

A Tamarack 12 in. dia. brs. N. 17° W. 57 lbs dist  
marked T 5 S. R. 33 E S. 30 B T

Land: Surface undulating  
Soil 2<sup>nd</sup> & 3<sup>rd</sup> rate; Pine. Tam-  
arack and fir timber heavy  
on N. 1/2 mile S. 1/2 mile  
S. mostly open

June 5<sup>th</sup> 1882

92 392

Subdivisions of T.5 South R.33 East

Willamette Meridian, Oregon.

East on a random line  
between Sec. 29 and 32  
ba.  $20^{\circ} 30'$  East

40.00 Set temporary  $\frac{1}{4}$  sec. cor.

79.48 Intersected N. and S. line  
22 lks. north of cor to sec.

28, 29, 32 and 33 - ascent 100 ft -  
from which cor I run  
N.  $89^{\circ} 51'$  West on a true line  
between Sec. 29 and 32

ba.  $20^{\circ} 15'$  East

39.74 Set post 4 ft long 4 in dia.

2 ft in ground on slight N. W.  
slope for  $\frac{1}{4}$  sec. cor. marked  
 $\frac{1}{4}$  S on North face

A Pine 8 in. dia. brs. N.  $42^{\circ}$  E 48 lks dist  
marked  $\frac{1}{4}$  S. B.T.

A Pine 10 in. dia brs S.  $30^{\circ}$  W. 77 lks dist  
marked  $\frac{1}{4}$  S. B.T.

79.48 The cor. to sec. 29, 30, 31 & 32

Subdivisions of T. 5 South R. 33 East -  
Willamette Meridian, Oregon.

Land: Surface undulating;  
Soil 3<sup>rd</sup> and 2<sup>nd</sup> rate, mostly  
open scattering Pine & Tama-  
rack timber with large  
open glades



94 394

Subdivisions of T. 5 South R. 33 East

Willamette Meridian, Oregon.

West on a random line  
between Sec. 30 & 31  
ba.  $20^{\circ} 30'$  East

38.00 begin steep descent

40.00 set temporary  $\frac{1}{4}$  sec. cor.

68.50 creek 40 lks wide co. N.W.  
descent 300 ft

79.42 Intersected west boundary  
28 lks North of cor. to Sec. 30  
and 31 which is a stone  
projecting about 6 inches

A Tamarack 8 in. di. lrs. N.  $30^{\circ}$  E. 10 lks dist

Marked T 5 S. R. 33 E. S. 30 BT

A Tamarack 6 in. di. lrs. S.  $30^{\circ}$  E. 19 lks dist

Marked T 5 S. R. 33 E. S. 31. BT.

A Tamarack 16 in. di. lrs. S.  $32^{\circ}$  W. 72 lks dist

Marked T 5 S. R. 32 E. S. 36 BT

A Tamarack 17 in di. lrs. N.  $25^{\circ}$  W. 43 lks dist

Marked T 5 S. R. 32 E. S. 25 BT

from which cor A run  
N.  $89^{\circ} 48'$  East on a true  
line between Sec 30 & 31

Subdivisions of T. 5 South R. 33 East 395  
 Willamette Meridian, Oregon.

Na.  $16^{\circ}05'$  East-

39,42 Set. A Fir 8 in. dia on steep  
 west slope for  $\frac{1}{4}$  sec. cor.  
 marked  $\frac{1}{4}$  S. on N. side

A Fir 10 in. dia. brs N.  $48^{\circ}$  W. 8 lks. dist-  
 marked  $\frac{1}{4}$  S. B.T.

A Fir 10 in. dia. brs S.  $50^{\circ}$  E 15 lks. dist-  
 marked  $\frac{1}{4}$  S. B.T.

79,42 The cor. to Sec. 29. 30. 31 & 32

Land: Surface N.  $\frac{1}{2}$  mile  
 steep creek bluff. E  $\frac{1}{2}$  mile  
 undulating;

Soil 3<sup>rd</sup> & 2<sup>nd</sup> rate. Some  
 Pine Tamarack & Fir timber  
 scattering with large open  
 glades 48

96 396

Subdivisions of T. 5 South R. 33 East

Willamette Meridian, Oregon.

North between Sec. 29 and 30  
and  $20^{\circ} 30'$  East

9.00 Leave timber co. E & W.

38.00 Enter timber co. N. W. & S. E

40.00 Set a basalt stone  $16 \times 10 \times 7$  ins

11 ins in ground on level for

$\frac{1}{4}$  Sec. cor marked  $\frac{1}{4}$  on N. face

A Tamarack 26 in. dia. brs. N.  $58^{\circ}$  E. 14 lks. dist

marked  $\frac{1}{4}$  S. B. T.

A Fir 20 in. dia. brs. N.  $70^{\circ}$  W. 33 lks dist

marked  $\frac{1}{4}$  S. B. T.

43.00 Leave grove

80.00 Set a basalt stone  $18 \times 8 \times 6$  in

12 ins. in ground on level for

cor to Sec. 19. 20. 29 and 30

mark with 2 notches on S

and 5 notches on E edges

A Pine 28 in. dia. brs. N.  $69^{\circ}$  E. 239 lks dis

marked T 5 S, R. 33 E, S. 20 B. T.

A Pine 16 ins. dia. brs. S.  $64^{\circ}$  E. 279 lks. dist

marked T 5 S, R 33 E, S 29, B. T.

Subdivisions of T. 5 South R. 33 East <sup>397</sup>  
 Willamette Meridian, Oregon.

No other trees near  
 Raised a mound of stone  
 along side

Land: Surface undu-  
 lating Soil 2 & 3<sup>rd</sup> rate  
 Some Pine and Tam-  
 arack timber mostly  
 open. good grass

My Latitude here  
 indicates approximately  
 45° 6' North

98

398

## Subdivisions of T. 5 South R. 33 East

Willamette Meridian, Oregon.

East on a random line  
between Sec. 20 and 29  
va 20° 00' East

4000 Set temporary  $\frac{1}{4}$  Sec. cor.

41.50 Spring branch co. North

79.64 Intersected N and S. line 40 lks  
north of cor. to Sec. 20, 21, 28 & 29  
from which cor. I run  
N. 89° 43' West on a true line  
between Sec. 20 and 29  
va 20° 30' East

39.8<sup>82</sup>~~84~~ Set a basalt stone 14 x 8 x 8 ins  
39.8<sup>82</sup> 9 ins in ground on slight north  
slope for  $\frac{1}{4}$  Sec. cor. marked  
 $\frac{1}{4}$  on North side

A Fir 16 ins. dia brs. N. 58° W. 13 lks. dist,  
marked  $\frac{1}{4}$  S. B. T.

A Tamarack, 14 in. dia brs. S. 26° E 62 lks. dist  
marked  $\frac{1}{4}$  S. B. T.

79.64 The cor. to Sec. 19, 20, 29, and 30

## Subdivisions of T. 5 South R. 33 East

Willamette Meridian, Oregon.

Land: Surface undulating

Soil 3<sup>rd</sup> and 2<sup>nd</sup> rate

Mostly open prairie some

scattering groves of Pine

timber good grass

100

400

Subdivisions of T. 5 South R. 33 East  
Willamette Meridian, Oregon.

West on a random line  
between Sec. 19 & 30  
Ra. 20° 00' East

Slightly descending

4000 Set temporary  $\frac{1}{4}$  Sec. cor.

79.20 Intersected West Boundary 72 lbs  
north of cor. to Sec. 19 & 30.  
descent about 100 ft which  
cor. is a Stone set in a  
mound of Stone

A Pine 28 in dia. lbs. S. 4° E. 146 lbs dist -  
Marked T 5 S. R. 33 E S. 30' BT

A Pine 26 in dia lbs. S. 12° N. 177 lbs dist -  
Marked T 5 S. R. 32 E. S. 25' BT

from which I run

N. 89° 29' East on a true line  
between Sec. 19 and 30  
Ra. 20° 15' East

39.20 Set a basalt Stone 18 x 12 x 10 ins

Subdivisions of T. 5 South R. 33 East

Willamette Meridian, Oregon.

12 ins. in ground on slight S. W.  
Slope for  $\frac{1}{4}$  Sec. cor. marked  
 $\frac{1}{4}$  on N. face

raised a mound of stone  
along side in lieu of  
pits

7920 The cor to Sec 19. 20. 29 & 30

Land: Surface undulating;  
Soil 2<sup>nd</sup> & 1<sup>st</sup> rate good grass  
no timber on line



102  
402

Subdivisions of T. 5 South R. 33 East  
Willamette Meridian, Oregon.

North between Sec. 19 & 20

wa.  $20^{\circ} 00'$  East

Slightly descending

4000 Set basalt stone  $17 \times 10 \times 5$  ins.

12 ins. in ground for  $\frac{1}{4}$  Sec. cor  
marked  $\frac{1}{4}$  on West side

Raised mound of stone  
along side

8000 Set a post 4 ft long and 4 ins square

in mound of stone for cor to  
Sec. 17, 18, 19 and 20 marked

T 5 S. S. 17 on N. E

R. 33 E S. 20 on S. E

S. 19 on S. W. and S. 18 on N. W.

also 3 notches on S. and 5 notches

on E. edges. also set basalt stone

in mound  $16 \times 10 \times 7$  ins marked

with 3 notches on S. and 5 notches

on E edges. descent about

80 ft

103

403

Subdivisions of T. 5 South R. 33 East  
Willamette Meridian, Oregon.

Land: Surface undulating  
and sloping north. Soil  
2<sup>nd</sup> & 3<sup>rd</sup> rate. a few small  
groves of Pine timber on  
this mile good grass

48

June 6<sup>th</sup> 1882

Subdivisions of T. 5 South R. 33 East  
Willamette Meridian, Oregon.

East on a random line between  
Sec. 17 and 20

Pa.  $18^{\circ} 15'$  East

14,25 Spring branch co. N. W.

40,00 Set temporary  $\frac{1}{4}$  Sec. cor.

61,00 on ridge co. N. W. & S. E. creek

bluff ascent about 200 ft

80,04 Intersected N. and S line 12 lbs

North of cor. to Sec. 16, 17, 20 & 21 -  
descent about 200 ft -

from which cor. Q run

N.  $89^{\circ} 55'$  West on a true

line between Sec. 17 and 20

Pa.  $19^{\circ} 15'$  East

40,02 Set a basalt stone  $16 \times 10 \times 8$  ins

11 ins in ground on west slope

for  $\frac{1}{4}$  Sec. cor. marked  $\frac{1}{4}$  on

North face

A Pine 20 in. dia. br. N.  $86^{\circ} W.$  33 lbs dist

marked  $\frac{1}{4}$  S. B. T.

405

Subdivisions of T. 5 South R. 33 East

Willamette Meridian, Oregon.

A Pine 18 in. dia brs. S. 85 W. 24 lks dist  
marked 74 S. B.T.

80,04 The cor. to Sec. 17, 18, 19 & 20

Land: Surface broken

Soil 2<sup>nd</sup> and 3<sup>rd</sup> rate

Some open Pine & Tama-  
rack timber mostly on  
E half mile. West 1/2 mile  
mostly open only a few  
scattering trees except along  
spring branch

78

706 406

Subdivisions of T. 5 South R. 33 East  
Willamette Meridian, Oregon.

West on a random line  
between Sec. 18 and 19  
Pa.  $18^{\circ} 15'$  East

4000 Set Temporary  $\frac{1}{4}$  Sec. cor.

78,84 Intersected West Boundary 78 lks  
north of cor. to Sec 18 and 19 which  
is a post and stone in  
a mound of stone in  
open prairie on slight  
N. W. slope

from which I run  
N.  $89^{\circ} 27'$  East on a true line  
between Sec. 18 & 19  
Pa.  $19^{\circ} 30'$  East

3884 Set basalt stone  $18 \times 8 \times 7$  ins  
12 ins in ground on level

Subdivisions of T. 5 South R. 33 East  
Willamette Meridian, Oregon.

in grove for 1/4 sec. cor.  
marked 1/4 on North face

A Pine 18 in dia. brs N. 22° E. 52 lbs dist

" marked 1/4 S. B.T.

A Pine 22 in dia. brs S. 42° W. 106 lbs dist

marked 1/4 S. B.T.

78.8# The cor. to sec. 17. 18-19 & 20

Land: Surface undulating,  
Soil 2' & 1" rate, a grove of  
Pine timber at and around  
half mile corner. remainder  
nearly all open, <sup>prairie</sup> good grass  
good farming land

108

408

Subdivisions of T. 5 South R. 33 East

Willamette Meridian, Oregon.

North between Sec. 17 and 18  
or.  $18^{\circ} 15'$  East

24.00 Enter strip of open timber  
co. N. W. & S. E

39.75 Spring branch co. N. W.

40.00 Set basalt stone  $18 \times 12 \times 5$  on  
level near spring branch  
for  $\frac{1}{4}$  Sec. cor. 12 ins. in  
ground and marked  $\frac{1}{4}$   
on west face

A Pine 24 ins. dia. brs. S.  $30^{\circ}$  E. 16 lbs dist  
marked  $\frac{1}{4}$  S. B. T.

A Pine 20 in. dia. brs S.  $60^{\circ}$  W. 41 lbs dist  
marked  $\frac{1}{4}$  S B. T.

51.00 leave strip of timber co. N. W. & S. E.

80.00 Set a post 4 ft long 4 in. square  
and stone  $15 \times 8 \times 7$  in mound  
of stone for cor to Sec. 7. 8. 17 and  
18. post marked T 5 S. S 8 on  
N. E. R 33 E. S 17 on S. E

Subdivisions of T. 5 South R. 33 East

Willamette Meridian, Oregon.

S 18 on S, W,

S. 7 on N. W. also 4 notches on S.

and 5 notches on E Edges

Stone Marker with 4 notches on

S. edge and 5 notches on E edge

no trees

Land: Surface undulating

Soil 2<sup>nd</sup> & 1<sup>st</sup> rate. a grove

of Pine trees along

Spring branch. good crop



Subdivisions of T. 5 South R. 33 East  
Willamette Meridian, Oregon.

East on a random line  
between Sec. 8 and 17  
ba.  $19^{\circ} 15'$  East,

1700 on creek bluff. co. N.W. & S.E.  
ascent 100 ft. & enter timber

3200 on creek bottom descent 200 ft.

3600 creek 30 lbs wide co. N.W.

4000 Set temporary  $\frac{1}{4}$  Sec. cor.

79.52 Intersected N. and S. line 18 lbs  
North of cor to Sec. 8, 9, 16 and 17  
- ascent about 500 ft -

from which cor. I run  
N.  $89^{\circ} 52'$  West on a true line  
between Sec. 8 and 17

ba.  $19^{\circ} 00'$  East -

39.76 Set a basalt stone  $18 \times 10 \times 8$  in  
12 in in ground on west  
face of bluff for  $\frac{1}{4}$  Sec. cor.  
marked  $\frac{1}{4}$  on N. face

A Pine 28 in di. lbs. N.  $62^{\circ} E$ . 86 lbs. dist  
marked  $\frac{1}{4}$  S. B. T.

Subdivisions of T. 5 South R. 33 East  
Willamette Meridian, Oregon.

A Pine 26 in dia. brs S. 38° E. 40 lbs dist  
marked 1/4 S. B. T.

79.52 The cor. to Sec. 7, 8, 17 & 18

Land: Surface mountainous  
Soil 3<sup>rd</sup> & 2<sup>nd</sup> rate; some  
Pine Tamarack & Fir  
timber with open glades

\$10

June 7<sup>th</sup> 1882

112

412

Subdivisions of T. 5 South R. 33 East  
Willamette Meridian, Oregon.

West on a random line  
between Sec. 7 & 18

wa.  $19^{\circ} 15'$  East

24.00 Enter strip of timber S.E. & N.W.

28.00 Spring branch co. N.W.

40.00 Set temporary  $\frac{1}{4}$  Sec. cor.

78.76 Intersected west boundary  
82 lbs north of cor. to Sec.

7. and 18. which is a stone  
in mound of stone

A Pine 10 in. di. lbs. N.  $70^{\circ}$  E. 56 lbs dist  
marked. T. 5 S. R. 33 E. S. 7 B.T.

A Pine 7 in di. lbs. S.  $18^{\circ}$  E. 60 lbs dist  
marked. T. 5 S. R. 33 E S. 18 B.T.

from which cor. I run  
N.  $89^{\circ} 25'$  East on a true line  
between Sec 7 and 18  
wa.  $18^{\circ} 45'$  East

Subdivisions of T. 5 South R. 33 East  
Willamette Meridian, Oregon.

38.76 Set a basalt stone  $16 \times 8 \times 7$  ins  
11 ins in ground on level for  
 $\frac{1}{4}$  Sec. cor, marked  $\frac{1}{4}$  on  
North face from which

A Pine 22 in dia. hrs. N.  $7^{\circ}$  W. 66 hrs dist  
marked  $\frac{1}{4}$  S. B.T.

no tree south raised a mound  
of stone in lieu of pit

<sup>78.76</sup>  
78.76 The cor to Sec. 7, 8, 17 and 18

Land: Surface undulating  
Soil. 2<sup>nd</sup> 3<sup>rd</sup> and 1<sup>st</sup> rate some  
Pine timber mostly open  
prairie good grass

114 414

Subdivisions of T. 5 South R. 33 East  
Willamette Meridian, Oregon.

North between Sec. 7 & 8  
wa.  $19^{\circ} 15'$  East

36.00 Center timber co. N.W. & S.E.  
and begin descent

40.00 a Fir 12 in. dia. on N.E. slope  
of creek bluff for  $\frac{1}{4}$  sec. cor.  
marked  $\frac{1}{4}$  S. on west face

A Fir 8 in dia. brs. S.  $38^{\circ}$  E. 22 lbs dist  
marked  $\frac{1}{4}$  S. B.T.

A Fir 12 in. dia. brs. west 41 lbs. dist.  
marked  $\frac{1}{4}$  S. B.T.

46.50 creek. 60 lbs. wide co. North  
descent about 150 ft

51.00 Leave creek co. to N.W.

80.00 Set a basalt stone  $18 \times 8 \times 6$  ins  
12 ins in ground on S.W. slope  
for cor. to Sec. 5, 6, 7 and 8  
Marked with 5 notches on S and  
E edges. ascent about 100 ft

A Tamarack 8 in dia brs. N.  $20^{\circ}$  E. 33 lbs dist  
marked T. 5 S. R. 33 E. S. 5 B.T.

Subdivisions of T. 5 South R. 33 East

Willamette Meridian, Oregon.

A Pine 15 in. dia. brs. S. 44° E. 57 lbs. dist  
marked T 5 S. R. 33 E. S. 8 B. T.

A Tamarack 14 in. di. brs. S. 47° W. 63 lbs. dist  
marked T 5 S. R. 33 E. S. 7. B. T.

A Pine 44 in. di. brs. N. 68° W. 8 lbs. dist  
marked T 5 S. R. 33 E. S. 6 B. T.

Land: Surface broken: soil  
2<sup>nd</sup> & 3<sup>rd</sup> rate: heavy timber  
on N. 44 chs Pine Tamarack  
and Fir with underbrush  
same. good grass on S. 36  
chs

116

416

Subdivisions of T. 5 South R. 33 East  
Willamette Meridian, Oregon.

East on a random line  
between Sec. 5 and 8  
wa.  $19^{\circ} 30'$  East

Ascending

34.00 Top of ridge course N. & S.  
ascent 300 ft-

40.00 Set Temporary  $\frac{1}{4}$  Sec. cor.

79.68 Intersected N. and S. line 32 lks  
north of cor. to Sec. 4, 5, 8 and  
9 - descent about 200 ft -  
from which cor. I run  
N.  $89^{\circ} 46'$  West on a true line  
between Sec. 5 and 8  
wa  $20^{\circ} 00'$  East

39.84 Set a basalt stone  $12 \times 10 \times 8$  ins  
8 ins in ground on E slope  
for  $\frac{1}{4}$  Sec. cor. marked  $\frac{1}{4}$   
on N. face from which

A Fir 10 in. dia. brs. N.  $40^{\circ}$  E. 20 lks dist.  
marked  $\frac{1}{4}$  S. B.T.

Subdivisions of T. 5 South R. 33 East

Willamette Meridian, Oregon.

A Tamarack. 14 in. di. br. S. 57° E. 22 lbs. dist  
marked. 1/4 S. B. T.

<sup>79.68</sup> 79.68 The cor. to Sec. 5, 6, 7 and 8

Land: surface rolling: soil  
3<sup>rd</sup> and 2<sup>nd</sup> rate: heavy Pine  
Tamarack and Fir timber  
with underbrush same  
open glades

8/10



718

418

Subdivisions of T. 5 South R. 33 East  
Willamette Meridian, Oregon.

West on a random line  
between Sec. 6 and 7  
ba.  $19^{\circ} 30'$  East

20.50 creek 60 lks wide co. N.W.  
descent 180 ft

32.00 An spur extending North

36.00 A ravine do North

40.00 Set temporary  $\frac{1}{4}$  sec. cor.

44.00 Leave timber co. N.W. & South

79.12 Intersected west Boundary

58 lks north of cor. to Sec

6 and 7 which cor. is a

post in mound of stone

all in good repair (ascent 100 ft)

from wh cor. I run

N.  $89^{\circ} 35'$  East on true line

between Sec. 6 & 7

ba  $20^{\circ} 45'$  East

39.12 Set basalt stone  $20 \times 8 \times 6$  ins. in

mound of stone on E slope

of bluff for  $\frac{1}{4}$  sec cor

marked  $\frac{1}{4}$  on its face

Subdivisions of T. 5 South R. 33 East  
Willamette Meridian, Oregon.

A Pine 8 in. dia. brs. N.  $18^{\circ}$  W. 86 lbs dist  
marked  $\frac{1}{4}$  S. B. T.

A Pine 28 in. di. brs. South 75 lbs dist  
marked  $\frac{1}{4}$  S. B. T.

79.12 The cor. to Sec. 5. 6. 7. & 8

Land: surface on E.  $\frac{1}{2}$  mile  
very broken. W.  $\frac{1}{2}$  mile  
undulating: Soil 3<sup>rd</sup> & 2<sup>nd</sup> rate  
Heavily timbered on E.  $\frac{1}{2}$  mile  
Pine Tamarack & Fir  
W.  $\frac{1}{2}$  mile prairie good  
grass

Subdivisions of T. 5 South R. 33 East  
Willamette Meridian, Oregon.

North on a random line  
between Sec. 5 and 6  
wa.  $19^{\circ} 36'$  East

Gradually ascending

4000 Set temporary  $\frac{1}{4}$  sec. cor.

79.88 Intersected North Boundary  
18 lbs east of cor. to Sec. 5 and  
6 which is a - ascent - 200 ft -

Stone projecting about 6 ins above ground

A Pine 6 ins dia lbs. N.  $7^{\circ}$  E. 109 lbs dist

marked T' 4 S R. 33 E S. 32 B' T

A Pine 5 ins dia lbs. S.  $14^{\circ}$  E. 68 lbs dist

marked T' 5 S. R. 33 E S. 5 B' T

A Pine 10 ins dia lbs. S.  $50^{\circ}$  W. 52 lbs dist

marked T' 5 S. R. 33 E S. 6 B. T

from which cor. I run  
S.  $00^{\circ} 08'$  East on a true line  
between Sec. 5 and 6  
wa.  $20^{\circ} 15'$  East

Subdivisions of T. 5 South R. 33 East 421  
 Willamette Meridian, Oregon.

<sup>39.88</sup>  
 39.88 Set a basalt stone 12 x 10 x 8 in  
 8 in in the ground for  $\frac{1}{4}$

Sec. cor. on west slope -  
 marked  $\frac{1}{4}$  on West face

A Pine 16 in. dia. lrs. N.  $45^{\circ}$  E 33 lrs dist  
 marked  $\frac{1}{4}$  S. B.T.

A Pine 16 in. dia. lrs. west 33 lrs dist  
 marked  $\frac{1}{4}$  S. B.T.

<sup>79.88</sup>  
 79.88 The cor. to Sec. 5-6-7 and 8

Land: Surface rolling  
 and sloping S. W. Soil  
 2<sup>nd</sup> and 3<sup>rd</sup> rate the greater  
 part heavily <sup>timbered with</sup> Pine Tamarack  
 and Fir timber, with  
 open glades

June 8<sup>th</sup> 1882

\$10

12<sup>2</sup>  
422

Subdivisions of T. 5 South R. 33 East  
Willamette Meridian, Oregon.

General description

The S. Eastern part is broken and mountainous: the western and Northern part is undulating or rolling.

About one fourth of the land can be cultivated and is of good second rate quality. a small part in the north and western parts is first rate. The remainder is third rate and is only valuable for grazing or for timber.

The distribution of timber is very irregular and cannot be definitely described in field notes. about one half the surface is covered with heavy timber. the other half either open or scattering.

There are two settlers in

Subdivisions of T. 5 South R. 33 East <sup>423</sup>

Willamette Meridian, Oregon.

this township. James Lehman  
on Sec. 12 and Robert H  
Redman on Sec. 2

426

FINAL OATHS FOR SURVEYS.

A list of the names of the individuals employed by George S. Pershin, U. S. Deputy Surveyor, to assist in running, measuring and marking the lines and corners described in the foregoing field notes of the survey of the Subdivision lines of Township 5 South Range 33 East Willamette Meridian, Oregon, showing the respective capacities in which they acted:

- Geo. Pershin, Compassman.
- James B. Ellis, Chainman.
- Frank F. Ellis, Chainman.
- Valentine Brown, Axeman.
- Valentine Brown, Axeman.
- Valentine Brown, Flagman.

FINAL OATHS OF ASSISTANTS.

We hereby certify that we assisted George S. Pershin, U. S. Deputy Surveyor, in surveying all those parts or portions of the Subdivision lines of Township 5 South Range 33 East Willamette Meridian, Oregon, as are represented in the foregoing field notes as having been surveyed by him and under his direction; and that said survey has been in all respects, to the best of our knowledge and belief, well and faithfully surveyed, and the corner monuments established, according to the instructions furnished by the U. S. Surveyor General of Oregon.

- James B. <sup>but</sup> Ellis, Compassman.

Subscribed and sworn to before me, this Eight day of

June 1882  
George S. Pershin  
A. U. S. Deputy Surveyor

[SEAL.]

## FINAL OATH OF DEPUTY SURVEYOR.

I, George S. Pershin

United States Deputy Surveyor, do solemnly swear that in pursuance of instructions received from James C. Tolman

U. S. Surveyor General for Oregon, bearing date of the 23<sup>rd</sup> day of

March, 1882, I have well, faithfully, and truly, in my own proper person, and in strict conformity with the instructions furnished by the U. S. Surveyor General for Oregon, the Surveying Manual, and the laws of

the United States, surveyed all those parts or portions of the subdivisions

on lines of Township 5 South Range 33 East

Willamette Meridian, in the State of Oregon, as are represented in the foregoing Field Notes as having been surveyed by me and under my directions; and I do further solemnly swear that all the corners of said survey have been established and perpetuated in strict accordance with the Surveying Manual, printed instructions, the special written instructions of the U. S. Surveyor General for Oregon, and in the specific manner described in the field notes, and that the foregoing are the true field notes of such survey, and should any fraud be detected I will suffer the penalty of perjury under the provisions of an Act of Congress approved August 8, 1846.

George S. Pershin  
U. S. Deputy Surveyor.

Subscribed and sworn to before me, this 30<sup>th</sup>

day of June, 1882.

James C. Tolman  
Surveyor General for Oregon.



428  
FINAL OATH OF DEPUTY SURVEYOR.

**Office U. S. Surveyor General,**

Portland, Oregon, August 12 1882

The following Field Notes of the Survey of  
the Subdivisional lines of  
Township 5 South, Range 33 East  
Willamette Meridian Oregon  
executed by George S. Pershin U.S. Dept  
Surveyor under his contract No 430  
dated March 23 1882, having been  
critically examined, the necessary corrections and ex-  
planations made, the said field notes and the survey  
they describe, are hereby approved.

James C. Tolman  
Surveyor General.