


*Fractional*  
**Township No 6 North Range No 30 East of the Willamette Meridian, Oregon**  
*(Meridith and Switzer Islands)*

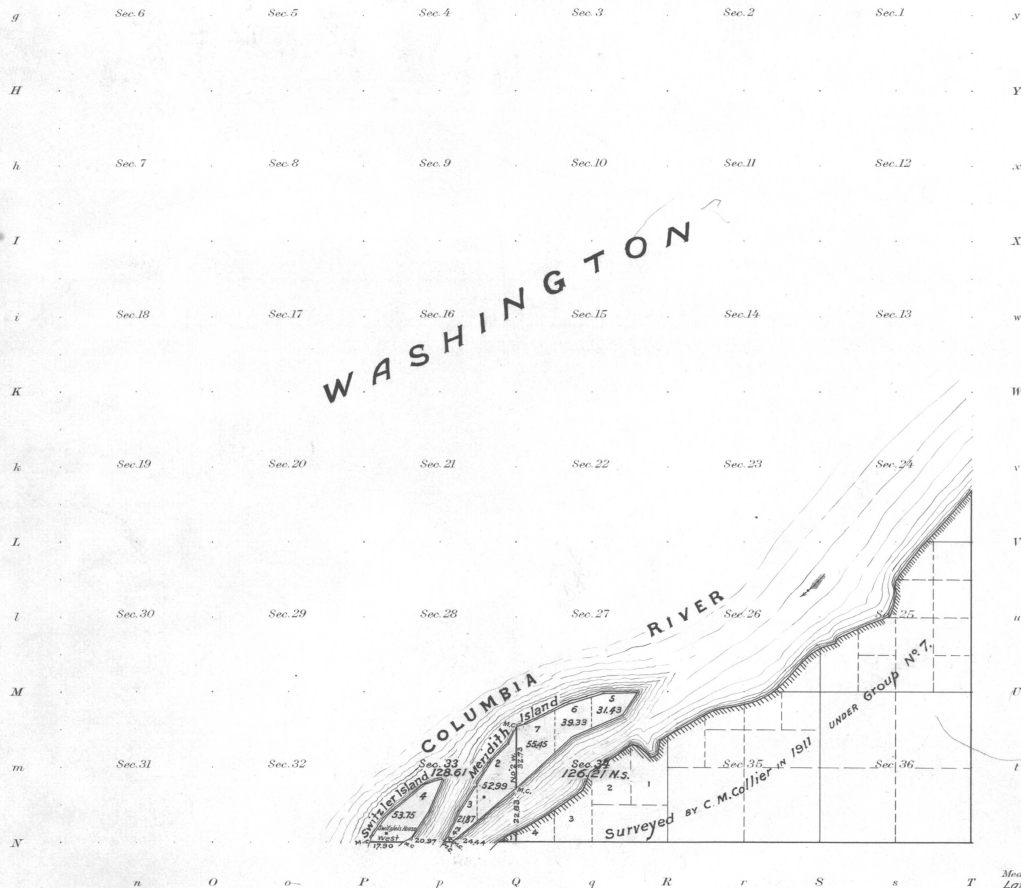

*Meanders of Meridith Island*  
 Beginning at meander cor. of frac.  
 sec's 4 and 33 on West side of Island

**Sec. 33**

N. 29° 15' E. 1.50 chs.  
 N. 26° 45' E. 14.90 "  
 N. 31° 30' E. 33.40 "  
 N. 44° 30' E. 12.70 "  
 N. 26° 45' E. 8.83 "

**Sec. 34**

N. 71° 30' E. 5.90 chs.  
 N. 63° 45' E. 24.00 "  
 N. 73° 45' E. 20.00 "  
 S. 87° 00' E. 18.00 "  
 S. 33° 45' W. 13.70 "  
 S. 68° 00' W. 33.00 "  
 S. 47° 30' W. 40.32 "

**Sec. 33**  
 S. 50° 45' W. 43.04 chs.

*Meanders of Switzer Island.*

**Sec. 33**

*Beginning at meander cor. of frac.  
 sec's 4 and 33 on East side of Island.*

N. 62° 30' E. 5.00 chs.  
 N. 34° 15' E. 16.70 "  
 N. 23° 00' E. 13.70 "  
 S. 71° 45' W. 8.80 "  
 S. 52° 00' W. 15.00 "  
 S. 23° 00' W. 11.20 "  
 S. 36° 30' W. 14.00 "  
 S. 24° 15' W. 3.52 "

Areas in Acres	
Public Land MS.	254.82
Indian Reservations	
Indian Allotments	
Mineral Claims	
Water Surface	
Former Survey	1949.58
<b>Total Area</b>	<b>2204.40</b>

Scale 40 Chains to an inch

Mean Magnetic Declination 21° 45' E.  
 Latitude 45° 57' N  
 Longitude 119° 03' W

Surveys Designated	By Whom Surveyed	Group No.	Special Instructions	Date	Amount of Surveys			When Surveyed	
					Mts.	chs.	lks.	Began	Completed
Subdivisions	Joseph A. Ganong	17		May 19, 1913	0	55	56	Dec 6, 1913	Dec 6, 1913
Meanders	"	"		"	4	42	91	"	"
Portion of South Bdy.	"	"		"	0	67	78	Dec 6, 1913	Dec 6, 1913
East and South Bdy's read	Charles M. Collier	7		August, 2, 1911				1911	1911
Subdivisions	"	"		"				"	"

*Fractional*  
 The above map of Township No. 6 North Range No. 30 East of the Willamette Meridian Oregon is strictly conformable to the field notes of the survey thereof on file in this office, which have been examined and approved

U. S. Surveyor General's Office.

Surveyor General for Oregon

Portland, Oregon, July 30, 1914.

ACCEPTED BY THE HON. COMMISSIONER G. L. O. June 18, 1915.

JW