6-34-A

Township No 6 North Range No 34 East Willamette Meridian.

Recd with Surveyor Genls letter of Jany 30. 1867

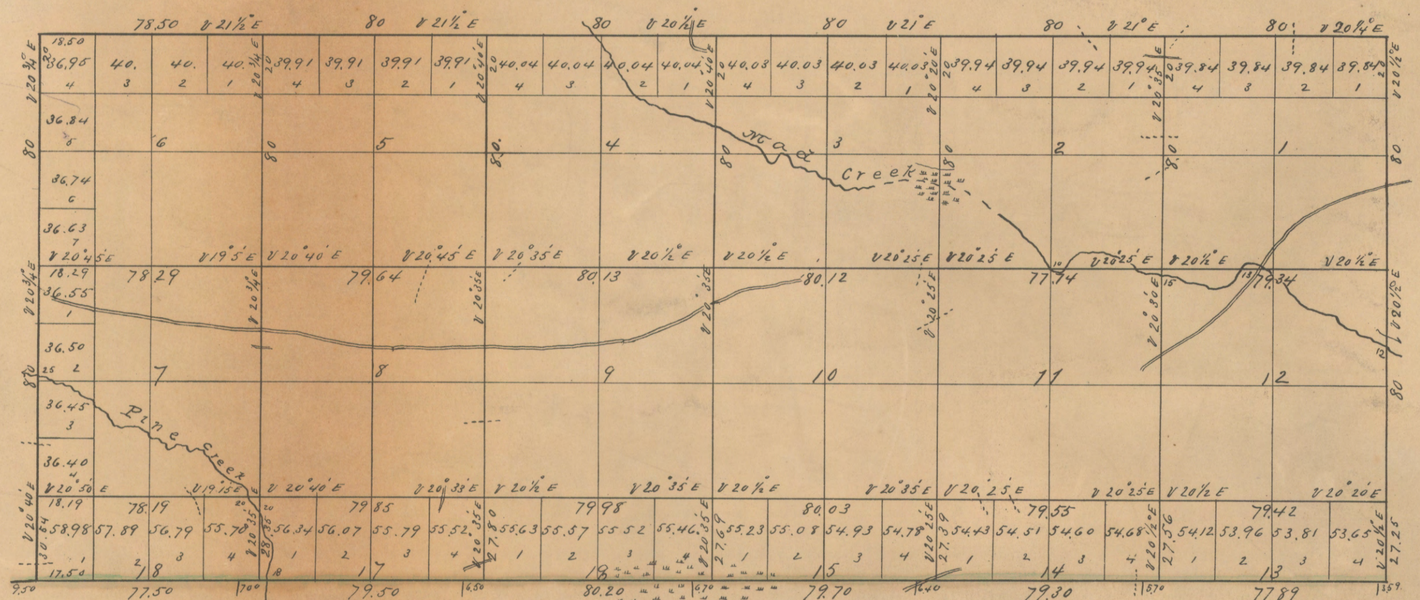

Surveys designated	By whom Surveyed	Contract No	Contract Date	Amt of Surveys Miles	Bks	Links	When Surveyed	When chargeable in the Surveyor Genls account
Subdivisions	Daniel G. Major	72	5th May 1863.	23	53	07	Apr 6th to 16th 1864	3rd quarter 1867.
Exterior W. Bdy.	" " "			2	30	54	Apr 15th to 6 may 1864	
Total No of Acres 8,981.14								

The above Map of Township No 6 North of Range No 39 East of the Willamette Meridian in the Territory of Washington is strictly conformable to the field notes of the survey thereof on file in this office, which have been examined and approved.

Surveyor Generals Office
Olympia W.T. Jany 30th 1867.

S Garfielde
Surveyor General W.T.

Department of the Interior
General Land Office
March 18-1868

I hereby certify that the above is a true photo-lithographic copy of the original on file in this Office.

Acting Commissioner.