


Township No. 6 North Range No. 34 East Will. Mer.

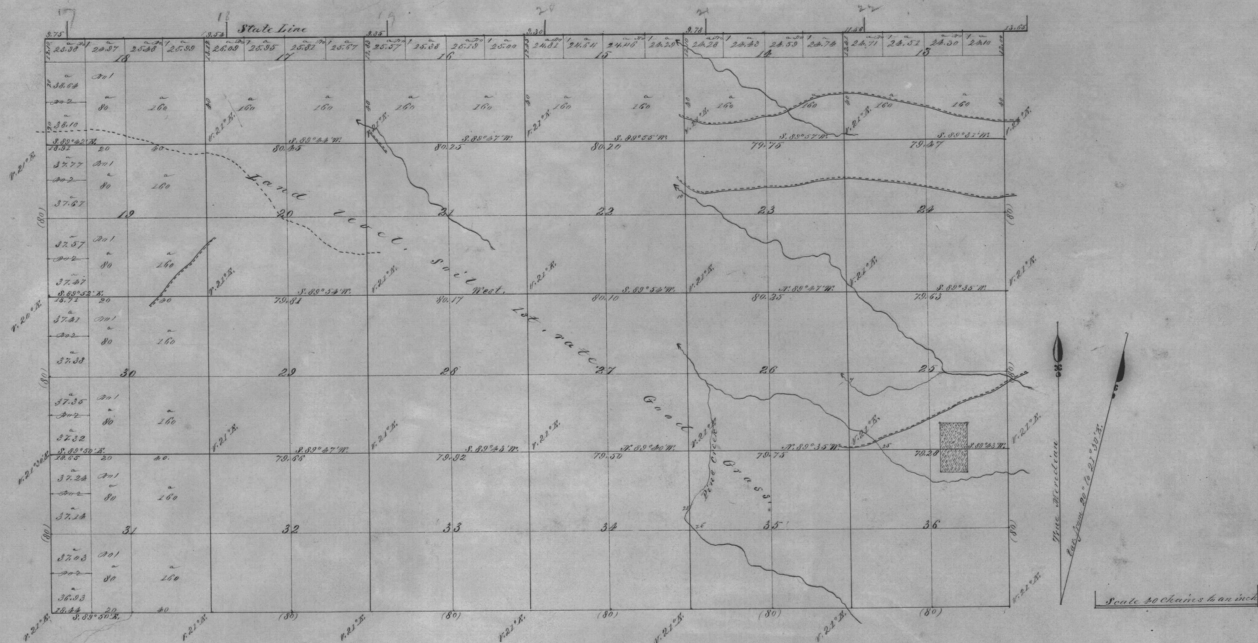

The above map of Township No. 6 North of Range No. 34 East Willamette Meridian Oregon, is strictly conformable to the field notes of the survey thereof on file in this office, which have been examined and approved.
 Surveyor General's Office,
 Eugene City, Aug. 24, 1865.

E. L. Applegate
 Surveyor General.

Description of Lines	Name of Deputy	Contract		Amount surveyed Acres (Chains Lines)	When surveyed
		No.	Date		
Subdivisions	Odell & Davis	110	Feb. 7, 1865	86 68 86	April 25, 1865.
incoming cont.	Odell & Davis	562			