

Bk 117


See Page 74 - Line between 13824 not  
within limit with the line bet 24825 <sup>470</sup>  
See Page 102. No Variation given at the  
corner Osces 5, 6, 7 & 8

Transcript for Washington, made  
July 29<sup>th</sup>, 1873,  
W. B. W.

A. H. Simmons having been  
Employed by George William Deputy  
Surveyor as compassman do solemnly  
swear that I will well and faithfully  
and to the best of my skill and ability  
execute the duties as compassman  
according to the Laws of the United  
States and the instructions furnished  
by the Surveyor General of Oregon

Subscribed and sworn  
to before me this 13<sup>th</sup>  
day of May A.D. 1873  
C. Moore  
Notary Public

A H Simmons

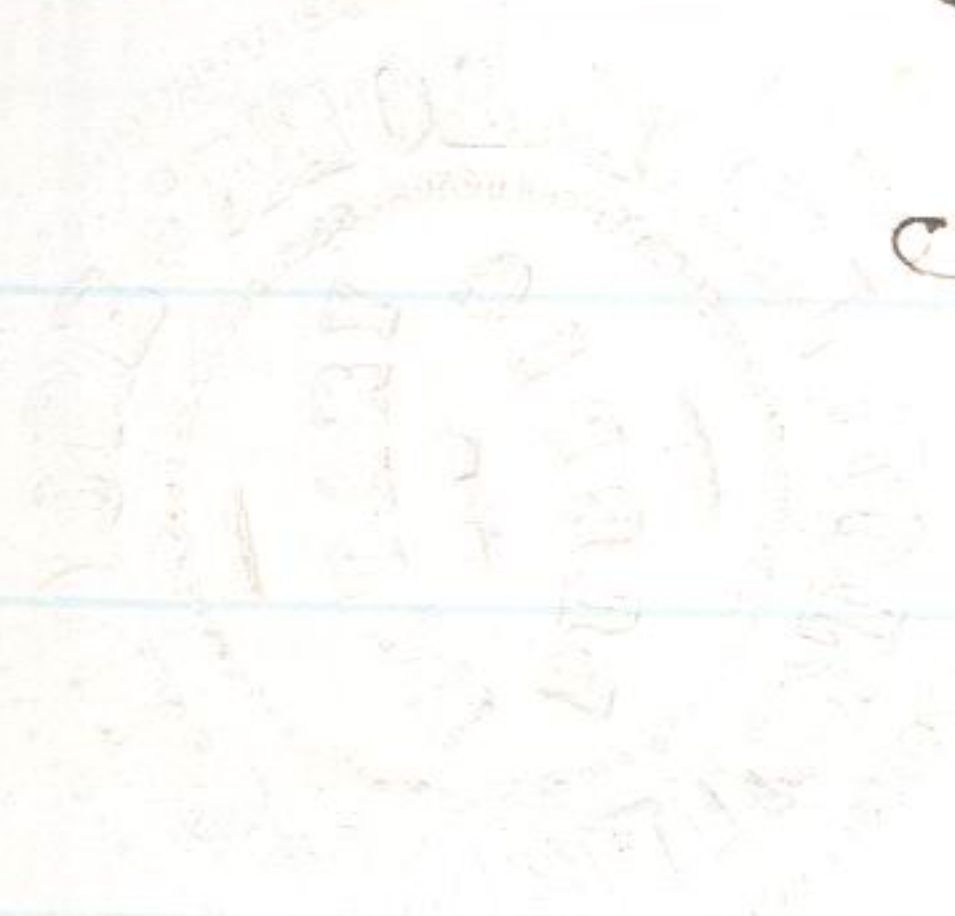

2  
P. 472  
Blank

473

No

I Erchas H Love, and Benjamin  
Baxter do solemnly swear  
that I will faithfully execute  
the duties of Chain Carrier  
that I will level the chain  
on uneven ground and plumb  
the tall pins & other by dropping  
or sticking, the same that  
I will report the true distance  
on line to all notable objects  
and the true length of all  
lines measured be use to  
the best of my skill and ability

E. H. Love,

B. Baxter

Sworn and subscribed to before  
me this 27<sup>th</sup> Sept 1852

J. P. Daley  
Notary Public

Field notes To complete  
 the exterior lines of Township  
 5 & 6 N. R. 37 & 38 East of  
 the Wadumette Meridian by  
 Grov Williams Dep. Sur.  
 under his Contract No.

Dated 1872

Assisted by E. M. Love and  
 B. Bayter Chumman  
 Andrew Jasper Teagman  
 and R. Hays Aronson  
 and A. H. Linnins Compsman  
 Work commenced September  
 29<sup>th</sup> 1872

Township 6 N. R. 37 E. Will. Mer.

Begin at the established corner  
 for Sec 19, 24, 25 & 30 on the  
 Range line between Ranges  
 37 & 38 E Township 6 N. Witness  
 trees standing and agree with  
 description furnish me by

Between 586 N. Range 38. E Hill, Mer.

80.00 Set post on summit of trail ridge  
in mound of stone for the Cor. to Secs.  
1, 2, 35 & 36. from which a Spruce  
Tree, dia. about N. 2° E 49 lks dist  
no other trees convenient, Land  
mountainous, Lumber Blue Pine  
Spruce Lamsack & Fir

East on S. boundary of Sec. 36  
Var.  $21\frac{3}{4}^{\circ}$  E.

40.00 Set Basalt Stone  $27 \times 18 \times 10$  for  $\frac{1}{4}$  Sec, Cor.  
a Pine tree 13 in. dia bears N. 27° W 86 lks  
dist. no other trees convenient

67.00 Ridge full north

80.00 Set post in mound of earth with pits  
& planted marked basalt stone  $6 \times 6$   
 $\times 4$  for the Cor. to Townships 586  
N. R. 38 & 39 E

Land mountainous  
Lumber Spruce, fir & Lamsack

Oct. 1<sup>st</sup> 1872

Between Ranges 387398 S. W. Hill, Mex.

North on E. boundary of Sec 36.  
Var. 21° E

5.  
5.00

Drum

40.00  
40.00

Set stone 22 x 14 x 18 in mound  
of earth & stone on side hill  
face N. W.

43.  
43.00

Bottom of gulch falls N 83° W 400

56.  
56.00

Ridge falls N. 300 ft.

80.  
80.00

Set post on side hill face NW  
for Cor. to Secs 25, 30, 31 & 36.

A Spruce tree 27 in. dia. bears N 27° E 78 lbs

" Pine " 41 " " " S 24° W 49 lbs

No other trees common, I saw  
mountainous Limber Pine, Fir  
Lamarck & Spruce Scattering & scrubby

North on E. boundary of Sec. 25

Var 21 3/4° E. — De Cherting

40.  
40.00

Set post for 1/4 Sec. Cor. from which  
Fir 10 in. dia. bears N 84° W 75 lbs dist

" 14 " " " S 59° E 21 " "

80.  
80.00

Set post & marked stone in mound

Return R. 388 39 E. T. C. W. Hill. Mer

of stone on side hill face N E  
 a Lumberack 13 in. dia. bears N 50° E 190 lks  
 " Fir 10 " " " " N 18° E 78 lks dist  
 " " 7 " " " " S 40° E 91 " "  
 Land mountainous Lumber Pele  
 Fir Lumberack & Spruce

North on E. boundary of Sec 24  
 Var 21° E

- 21.00 Bottom of Gulch a creek & lks wide  
 full N W ascend
- 40.00 Set post for 1/4 Sec Cor from which  
 Fir 8 in. dia. bears W 10° E 7 1/2 lks dist  
 " " " " " S 30° N 42 " "
- 47.00 Ridge 400 ft. full N W
- 56.50 Bottom of Gulch falls N 60° W 200 ft
- 56.75 Creek 15 lks wide flows N 60° W ascend
- 80.00 Set post from which  
 a Fir tree 10 in. dia. bears N 30° E 18 lks dist  
 " " 11 " " " " N 42° W 76 " "  
 " " 12 " " " " S 31° E 24 " "  
 " " " " " " S 29° W 37 " "

486

Between R 38 & 39 S. C.W. Hill, Mex.

for the Cor of Secs 19, 30, 24 & 25 -  
Land hilly 2<sup>nd</sup> Rate Lumber  
Pine Fir Lummuck

North on E boundary Sec 13,  
Car 2 1/2 E

6,00<sup>6</sup>

Ridge full N 72 W 300 ft

18,00<sup>14</sup>

Bottom a creek 13 lbs wide full N  
50° W a prong of Mill Creek, ascend

40,00<sup>40</sup>

Set post for 1/4 Sec Cor from which  
a Birch 8 in, dia. bears N 76° W 46 lbs

" Fir 9 " " " " S 38° E 29 lbs, d

52,20<sup>52,20</sup>

Intersect the State boundary 16, 80 chs  
West of the 4 1/2 mile Cor, Set Stone

28 x 21 x 15, in mound of Stone for  
closing cor, to fractional Towns

C.W. R. 38 & 39 E

Land mountainous

Lumber Fir Lummuck & Pine

Complete Oct. 2<sup>nd</sup> 1872



6N-38E General Description

This Township is rough and very  
 mountainous Canons & Ridges  
 Travers it in all directions and  
 is valuable for its timber  
 consisting of Pine, Fir, Larch  
 Spruce, Birch, Cottonwood  
 Alder & Willow

The Geological formation is  
 volcanic Basalt being almost  
 the entire rock

I George William Deputy Surveyor do solemnly swear that in pursuance of a contract with W. H. Odell Surveyor General of the public lands of the United States in the State of Oregon bearing date the 20<sup>th</sup> day of July 1872 and in strict conformity to the Laws of the United States and the instructions furnished by the said Surveyor General, I have faithfully surveyed the Exterior and Subdivisional lines of Township 5 North Range 37 East, the Exterior and Subdivisional lines of Fractional Townships 6 North Ranges 37 & 38 East and the Subdivisional lines of Fractional Township 5 North Range 38 East <sup>in the State of</sup> Oregon aforesaid and do further solemnly swear that the foregoing are the true and original field notes of such survey.

George William  
Deputy Surveyor

Subscribed & sworn to  
before me this 6<sup>th</sup> day  
of May A. D. 1873

W. H. Odell  
Surveyor General

584

585

List of Persons Employed to  
assist in running measuring or  
marking the lines and corners described  
in the foregoing field notes showing  
the respective capacities in which  
they acted

E H Love & B Baxter Chairman  
Richard Hays Assessor  
Andrew Jasper Flagman  
A H Simmons Comptroller

We hereby certify that we have appointed  
Geo Williams, deputy surveyor, in  
surveying the exterior boundaries and in subdividing  
Townships Number 5 & 6 N R 37 & 38 N, R 28 & 29 and  
four sections in Township 5 N 38 E, of the Willamette  
Meridian Territory of Oregon and that said  
Townships have been in all respects, to the  
best of our knowledge and belief well  
and faithfully surveyed and the boundary  
monuments planted according to the instructions  
furnished by the Surveyor General,

E H Love, Chairman

B Baxter ..

R Hays Assessor

Andrew Jasper Flagman

A H Simmons Comptroller

Given and subscribed to before me  
on this 24<sup>th</sup> day Dec 1872

O P Lacy  
Notary Public

We the undersigned Bondsmen in the Contract No. 176 made between George Williams Deputy Surveyor and the Surveyor General of the United States for the State of Oregon bearing date the 20<sup>th</sup> day of July 1873 hereby consent to the substitution of fractional Township 5. & 6. North Range 38 East. Surveyed instead of Township 4 North Range 37 East left unsurveyed by reason of unfitness; And we hold ourselves in every respect liable under said Contract with said Substitution as under the original Contract  
G. Williams

Mr S. C. Adams the other Bondsmen on the above mentioned contract is out of the State, he being in Cincinnati Ohio and will not return the present year.

L. H. Williams  
Dep. Sur.

Salem, May 7<sup>th</sup> 1873.