

Bk 117


See Page 74 - Line between 13824 not
within limit with the line bet 24825 ⁴⁷⁰
See Page 102. No Variation given at the
corner Osces 5, 6, 7 & 8

Transcript for Washington, made
July 29th, 1873,
W. B. W.

A. H. Simmons having been
Employed by George William Deputy
Surveyor as compassman do solemnly
swear that I will well and faithfully
and to the best of my skill and ability
execute the duties as compassman
according to the Laws of the United
States and the instructions furnished
by the Surveyor General of Oregon

Subscribed and sworn
to before me this 13th
day of May A.D. 1873
C. Moore
Notary Public

A H Simmons

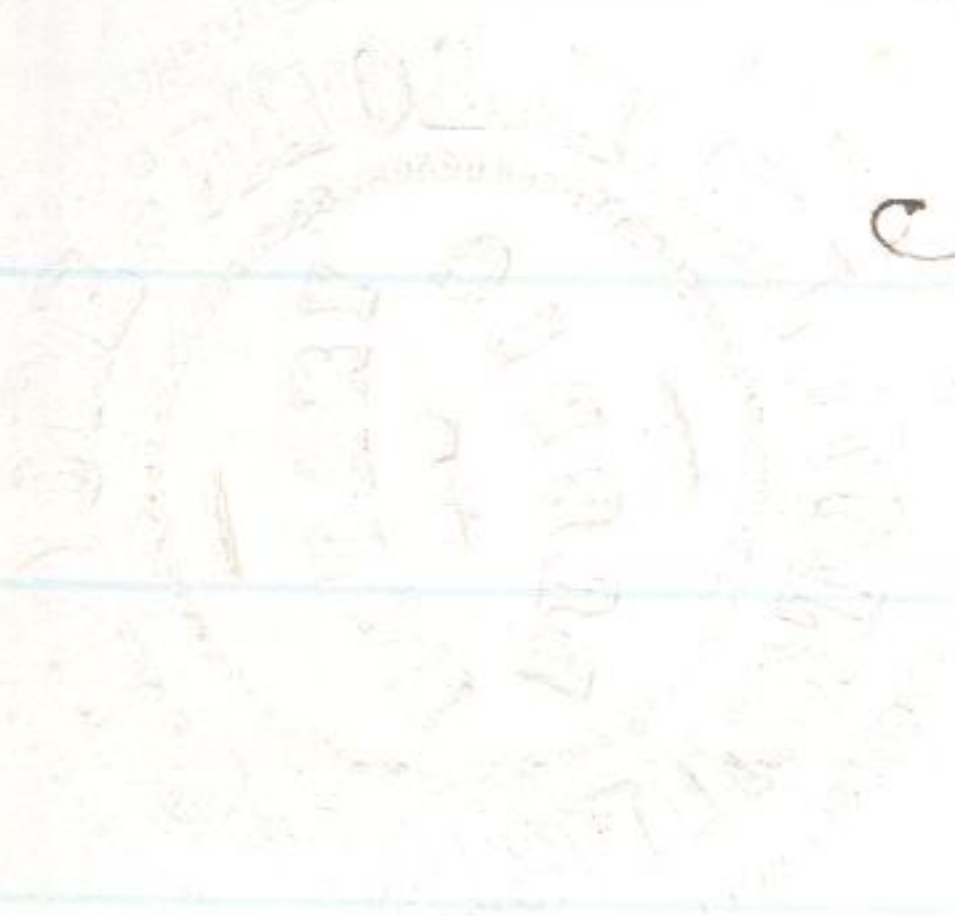

2
P. 472
blank

473

no

I Erchas H Love, and Benjamin
Baxter do solemnly swear
that I will faithfully execute
the duties of Chain Carrier
that I will level the chain
on uneven ground and plumb
the tall pins ^{no} either by dropping
or sticking, the same that
I will report the true distance
on line to all notable objects
and the true length of all
lines measured by me to
the best of my skill and ability

E. H. Love,

B. Baxter

Sworn and subscribed to before
me this 27th Sept 1853

J. P. Deary
Notary Public

Field notes To complete
the exterior lines of Township
5 & 6 N. R. 37 & 38 East of
the Wadumette Meridian by
Grover Williams Dep. Surv.
under his Contract No.

Dated 1872

Assisted by E. M. Love and
B. Bayter Chumman
Andrew Jasper Teagman
and R. Hays Aronson
and A. H. Linnins Comptroller
Work commenced September
29th 1872

Township 6 N. R. 37 E. Will. Mer.

Begin at the established corner
for Sec 19, 24, 25 & 30 on the
Range line between Ranges
37 & 38 E Township 6 N. Witness
trees standing and agree with
description furnish me by

486

Between R 38 & 39 S. C.W. Hill, Mex.

for the Cor of Secs 19, 20, 24 & 25 -
Land hilly 2nd Rate Lumber
Pine Fir Lummuck

North on E boundary Sec 13,
Car 2 1/2 E

6,00⁶

Ridge fall N 72 W 300 ft

18,00¹⁴

Bottom a creek 13 lbs wide fall N
50° W a prong of Mill Creek, ascend

40,00⁴⁰

Set post for 1/4 Sec Cor from which
a Birch 8 in, dia. bears N 76° W 46 lbs

" Fir 9 " " " " S 38° E 29 lbs, d

52,20^{52,20}

Intersect the State boundary 16, 80 chs
West of the 4 1/2 mile Cor, Set Stone

28 x 21 x 15, in mound of Stone for
closing cor, to fractional Towns

C.W. R. 38 & 39 E

Land mountainous

Lumber Fir Lummuck & Pine

Complete Oct. 2nd 1872

I George William Deputy Surveyor do solemnly swear that in pursuance of a contract with W. H. Odell Surveyor General of the public lands of the United States in the State of Oregon bearing date the 20th day of July 1872 and in strict conformity to the Laws of the United States and the instructions furnished by the said Surveyor General, I have faithfully surveyed the Exterior and Subdivisional lines of Township 5 North Range 37 East, the Exterior and Subdivisional lines of Fractional Townships 6 North Ranges 37 & 38 East and the Subdivisional lines of Fractional Township 5 North Range 38 East ^{in the State of} Oregon aforesaid and do further solemnly swear that the foregoing are the true and original field notes of such survey.

George William
Deputy Surveyor

Subscribed & sworn to
before me this 6th day
of May A. D. 1873

W. H. Odell
Surveyor General

584

585

List of Persons Employed to
assist in running measuring or
marking the lines and corners described
in the foregoing field notes showing
the respective capacities in which
they acted

E H Love & B Baxter Chairman
Richard Hays Assessor
Andrew Jasper Flagman
A H Simmons Comptroller

We hereby certify that we have appointed
Geo Williams, deputy surveyor, in
surveying the exterior boundaries and in subdividing
Townships Number 5 & 6 N R 37 & 38 N, R 28 & 29 and
four sections in Township 5 N 38 E, of the Willamette
Meridian Territory of Oregon and that said
Townships have been in all respects, to the
best of our knowledge and belief well
and faithfully surveyed and the boundary
monuments planted according to the instructions
furnished by the Surveyor General,

E H Love, Chairman

B Baxter ..

R Hays Assessor

Andrew Jasper Flagman

A H Simmons Comptroller

Given and subscribed to before me
on this 24th day Dec 1872

O P Lacey
Notary Public

We the undersigned Bondsmen in the contract No. 176 made between George Williams Deputy Surveyor and the Surveyor General of the United States for the State of Oregon bearing date the 20th day of July 1873 hereby consent to the substitution of fractional Township 5. & 6. North Range 38 East. Surveyed instead of Township 4 North Range 37 East left unsurveyed by reason of unfitness; And we hold ourselves in every respect liable under said Contract with said Substitution as under the original Contract
G. Williams

Mr S. C. Adams the other Bondsmen on the above mentioned contract is out of the State, he being in Cincinnati Ohio and will not return the present year.

L. H. Williams
Dep. Sur.

Salem, May 7th 1873.