

R622

# FIELD NOTES


OF THE

352

REMONUMENTATION OF CERTAIN ORIGINAL CORNER POINTS,

TOWNSHIP 7 SOUTH, RANGE 31 EAST,

INDEX DIAGRAM

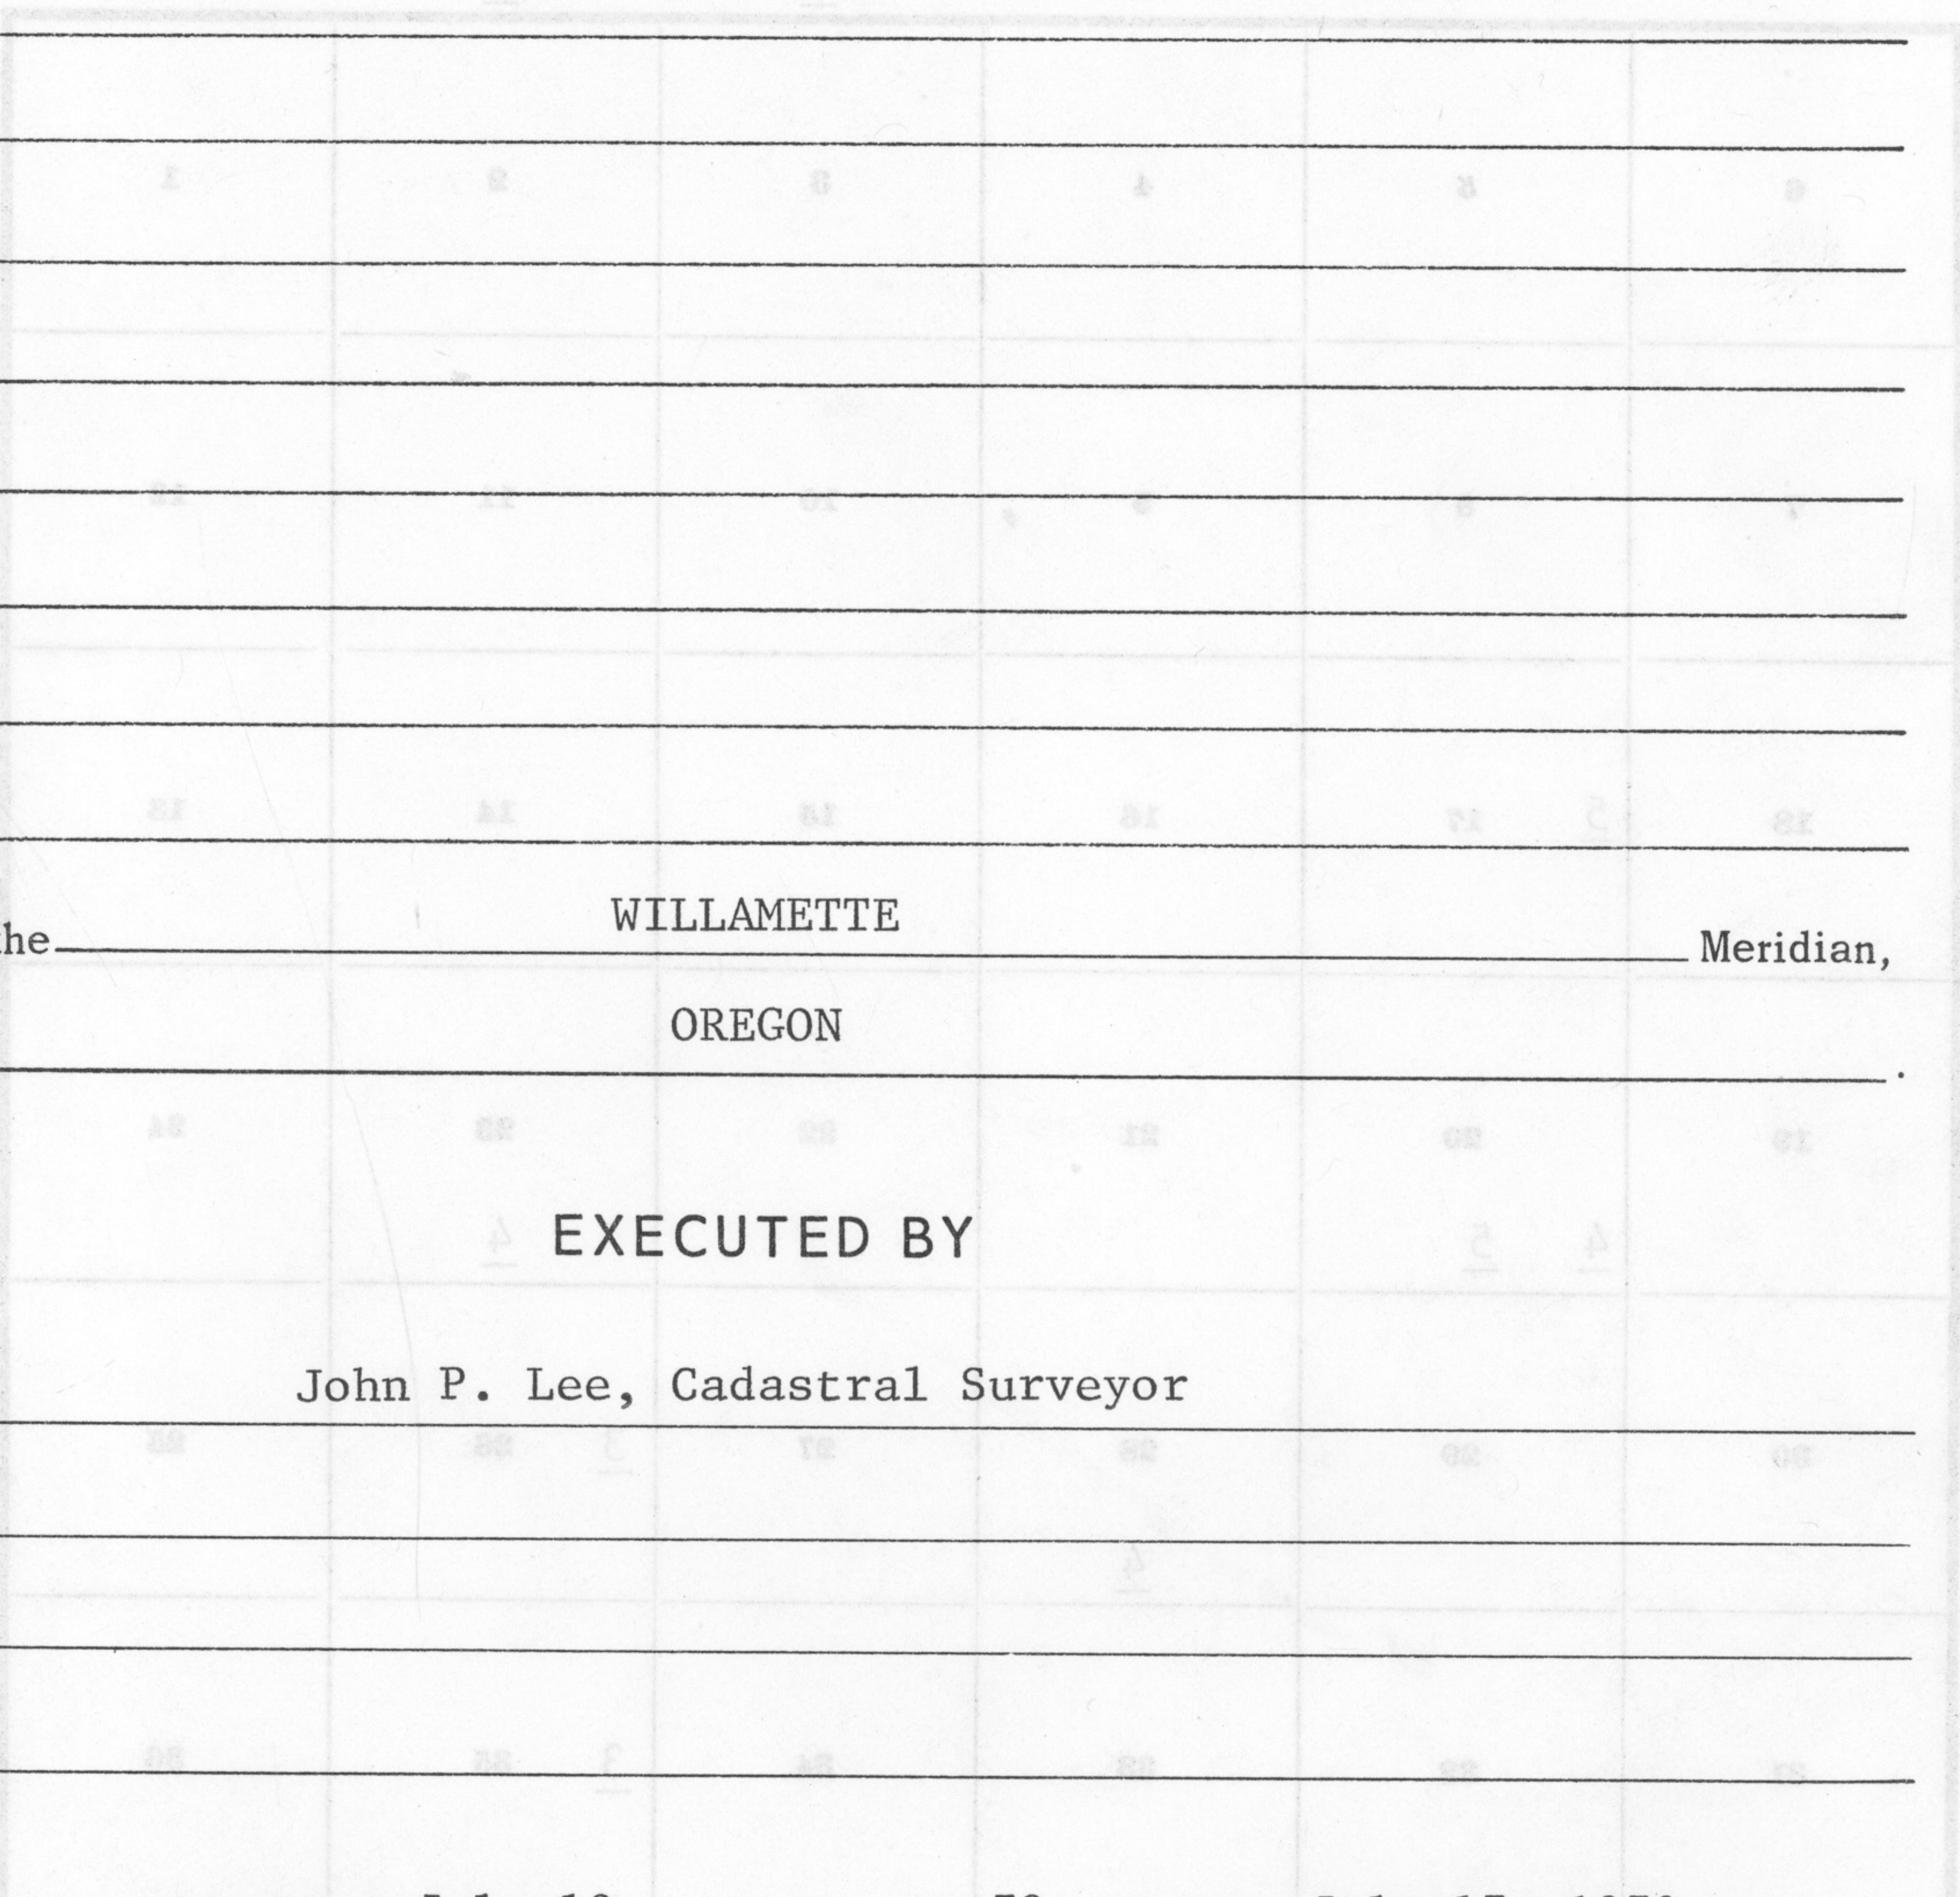

Of the WILLAMETTE Meridian,

In the State of OREGON

EXECUTED BY

John P. Lee, Cadastral Surveyor

Under special instructions dated July 13, 19 79, approved July 17, 1979

\_\_\_\_\_, which provided for the surveys included under U.S. Survey/Group  
Number 1000, and assignment instructions dated March 25, 19 80.

Survey commenced May 14, 19 80

Survey completed May 16, 19 80



ORIGINAL

353

353

# FIELD NOTES

OF THE

REMONUMENTATION OF CERTAIN ORIGINAL CORNER POINTS,

TOWNSHIP 7 SOUTH, RANGE 31 EAST,

## INDEX DIAGRAM

Township 7 South, Range 31 East

6	5	4	3	2	1
7	8	9	10	11	12
18	<u>5</u> 17	16	15	14	13
19	20	21	22	23	24
30	<u>4</u> <u>5</u>	28	27	<u>3</u> 26	25
31	32	33	34	<u>3</u> 35	36

1

Number 1000 and assignment instructions dated March 25, 1980, which provided for the surveys included under U.S. Survey Group

Survey commenced May 14, 1980  
Survey completed May 16, 1980



## T. 7 S., R. 31 E., Willamette Meridian, Oregon

## CHAINS

The following field notes describe the remonumentation of certain original corner points, township 7 south, range 31 east, Willamette Meridian, Oregon, as provided for in the Special Instructions, Group 1000, Oregon, dated July 13, 1979, "Investigation of Physical Evidence of Corner Positions and Accessories, Followed by Remonumentation of Corner Points, with New Accessories when Needed".

The remonumentation of original corner points was made at the request of the United States Forest Service, in conjunction with their Land Line Location Program.

The mean magnetic declination is 20° E.

West Boundary, T. 7 S., R. 31 E.,  
Willamette Meridian, Oregon

(Remonumenting a corner established by Henry Meldrum,  
U. S. Deputy Surveyor, in 1881)

The cor. of secs. 7, 12, 13, and 18, on the W. bdy. of the Tp., monumented with a mound of stone, 2 ft. base, 6 ins. high, from which the original bearing tree:

A pine, 30 ins. diam., bears S. 81° E., 64 lks. dist., with scribe marks S R31 S visible on partially open blaze.

At the corner point

Set an iron post, 28 ins. long, 2½ ins. diam., 21 ins. in the ground, with brass cap mkd.

T 7 S	
R 30 E	R 31 E
S 12	S 7
S 13	S 18
1980	

from which new bearing trees

A fir, 15 ins. diam., bears N. 50° E., 33 lks. dist., mkd. T7S R31E S7 BT.

A pine, 10 ins. diam., bears S. 39° W., 74 lks. dist., mkd. T7S R30E S13 BT.

A pine, 16 ins. diam., bears N. 39¼° W., 44½ lks. dist., mkd. T7S R30E S12 BT.

Corner is located 2 lks. E. of barbed wire fence, fence extends N. and S.

North Boundary, T. 7 S., R. 31 E.,  
Willamette Meridian, Oregon

(Remonumenting corners established by Henry Meldrum,  
U. S. Deputy Surveyor, in 1881)



355

Remonumentation of Certain Original Corner Points,  
T. 7 S., R. 31 E., Willamette Meridian, Oregon

## CHAINS

The  $\frac{1}{4}$  sec. cor. of secs. 2 and 35, on the N. bdy. of the Tp., monumented with a basalt stone, 10 x 12 x 23 ins., not of record, firmly set 13 ins. in the ground, no marks visible, from which the remains of the original bearing trees:

A fir snag, 28 ins. diam., bears S.  $30^{\circ}$  E., 32 lks. dist., with partially chopped out blaze, no marks visible. (Record, S.  $32^{\circ}$  E.)

A pine snag, 9 ins. diam., bears N.  $64^{\circ}$  W., 50 lks. dist., with scribe marks BT visible on partially opened blaze.

At the corner point

Set an iron post, 28 ins. long,  $2\frac{1}{2}$  ins. diam., 22 ins. in the ground, with brass cap mkd.

T 6 S R 31 E

$\frac{1}{4}$  S 35  
S 2

T 7 S

1980

from which new bearing trees

A fir, 15 ins. diam., bears S.  $55^{\circ}$  E., 63 lks. dist., mkd.  $\frac{1}{4}$  S2 BT.

A fir, 15 ins. diam., bears N.  $3\frac{1}{2}^{\circ}$  W.,  $17\frac{1}{2}$  lks. dist., mkd.  $\frac{1}{4}$  S35 BT.

Deposit corner stone alongside iron post.

Corner is located 27 lks. N. of barbed wire fence, fence extends E. and W.

The  $\frac{1}{4}$  sec. cor. of secs. 3 and 34, on the N. bdy. of the Tp., monumented with an iron shaft, 1 in. diam., 2 ft. long, not of record, firmly set 18 ins. in the ground, from which the remains of the original bearing trees:

A decayed pine stump, 28 ins. diam., bears N.  $45^{\circ}$  E., 118 lks. dist., no marks visible. (Record, N.  $43^{\circ}$  E.)

A fir snag, 28 ins. diam., bears S.  $55^{\circ}$  W., 29 lks. dist., with scribe mark S visible on partially opened blaze.

At the corner point

Set an iron post, 28 ins. long,  $2\frac{1}{2}$  ins. diam., 22 ins. in the ground, directly over iron shaft, with brass cap mkd.

T 6 S R 31 E

$\frac{1}{4}$  S 34  
S 3

T 7 S

1980

from which new bearing trees



Remonumentation of Certain Original Corner Points,  
T. 7 S., R. 31 E., Willamette Meridian, Oregon

## CHAINS

A fir, 14 ins. diam., bears N.  $9^{\circ}$  E.,  $69\frac{1}{2}$  lks.  
dist., mkd.  $\frac{1}{4}$  S34 BT.

A fir, 14 ins. diam., bears S.  $80^{\circ}$  E.,  $46\frac{1}{2}$  lks.  
dist., mkd.  $\frac{1}{4}$  S3 BT.

Subdivisions, T. 7 S., R. 31 E.,  
Willamette Meridian, Oregon

(Remonumenting corners established by Frank W. Campbell,  
U. S. Deputy Surveyor, in 1881)

The  $\frac{1}{4}$  sec. cor. of secs. 34 and 35, determined at record  
bearing and distance from the remains of the original  
bearing trees:

A decayed pine stump, 29 ins. diam., bears  
N.  $81^{\circ}$  E., 33 lks. dist., with scribe marks  
BT visible on loose piece of wood on top of  
stump.

A root hole, bears S.  $74^{\circ}$  W., 27 lks. dist.

At the corner point

Set an iron post, 28 ins. long,  $2\frac{1}{2}$  ins. diam., 22 ins.  
in the ground, with brass cap mkd.

T 7 S R 31 E

$\frac{1}{4}$   
S 34 | S 35  
1980

from which new bearing trees

A pine, 12 ins. diam., bears S.  $73\frac{1}{4}^{\circ}$  E.,  $114\frac{1}{2}$  lks.  
dist., mkd.  $\frac{1}{4}$  S35 BT.

A pine, 12 ins. diam., bears N.  $48\frac{1}{2}^{\circ}$  W., 7 lks.  
dist., mkd.  $\frac{1}{4}$  S34 BT.

Corner is located 10 lks. W. of barbed wire fence, fence  
extends N. and S.

The  $\frac{1}{4}$  sec. cor. of secs. 26 and 27, monumented with the  
original basalt stone, 15 x 15 x 10 ins., firmly set 9  
ins. in the ground, no marks visible, in a mound of stone,  
2 ft. base, 1 ft. high, from which the original bearing  
tree:

A pine, 18 ins. diam., bears S.  $89^{\circ}$  E., 19 lks.  
dist., with scribe mark S visible on partially  
healed double blaze.

At the corner point

Set an iron post, 28 ins. long,  $2\frac{1}{2}$  ins. diam., 21 ins.  
in the ground, with brass cap mkd.

T 7 S R 31 E

$\frac{1}{4}$   
S 27 | S 26  
1980







CERTIFICATE OF SURVEY

Form 8000-11  
(August 1979)

(I) ~~(XX)~~, John P. Lee, Cadastral Surveyor, HEREBY

CERTIFY upon honor that, in pursuance of special instructions bearing date of the 13th day of July, 1979, (I) ~~(XX)~~ have remonumented certain original corner points, township 7 south, range 31 east,

of the Willamette Meridian, in the State of Oregon, which are represented in the foregoing field notes as having been executed by (me), ~~(XX)~~ and under (my) ~~(XXX)~~ direction; and that said survey has been made in strict conformity with said special instructions, the Manual of Instructions for the Survey of the Public Lands of the United States, and in specific manner described in the foregoing field notes.

April 7, 1981

(Date)

*John P. Lee*  
(Cadastral Surveyor)

(Date)

(Cadastral Surveyor)

CERTIFICATE OF APPROVAL

BUREAU OF LAND MANAGEMENT  
Portland, Oregon

The foregoing field notes of the remonumentation of certain original corner points, township 7 south, range 31 east, Willamette Meridian, Oregon,

executed by John P. Lee, Cadastral Surveyor,

having been critically examined and found correct, are hereby approved.

December 5, 1983

(Date)

*William W. Glenn*

(Chief Cadastral Surveyor of Oregon)

CERTIFICATE OF TRANSCRIPT

I CERTIFY That the foregoing transcript of the field notes of the above-described surveys in \_\_\_\_\_, is a true copy of the original field notes.

(Date)

(Chief, Cadastral Survey Examination and Approval Staff)