



Township No. 7 South Range No. 32 East Willamette Meridian, Oregon.

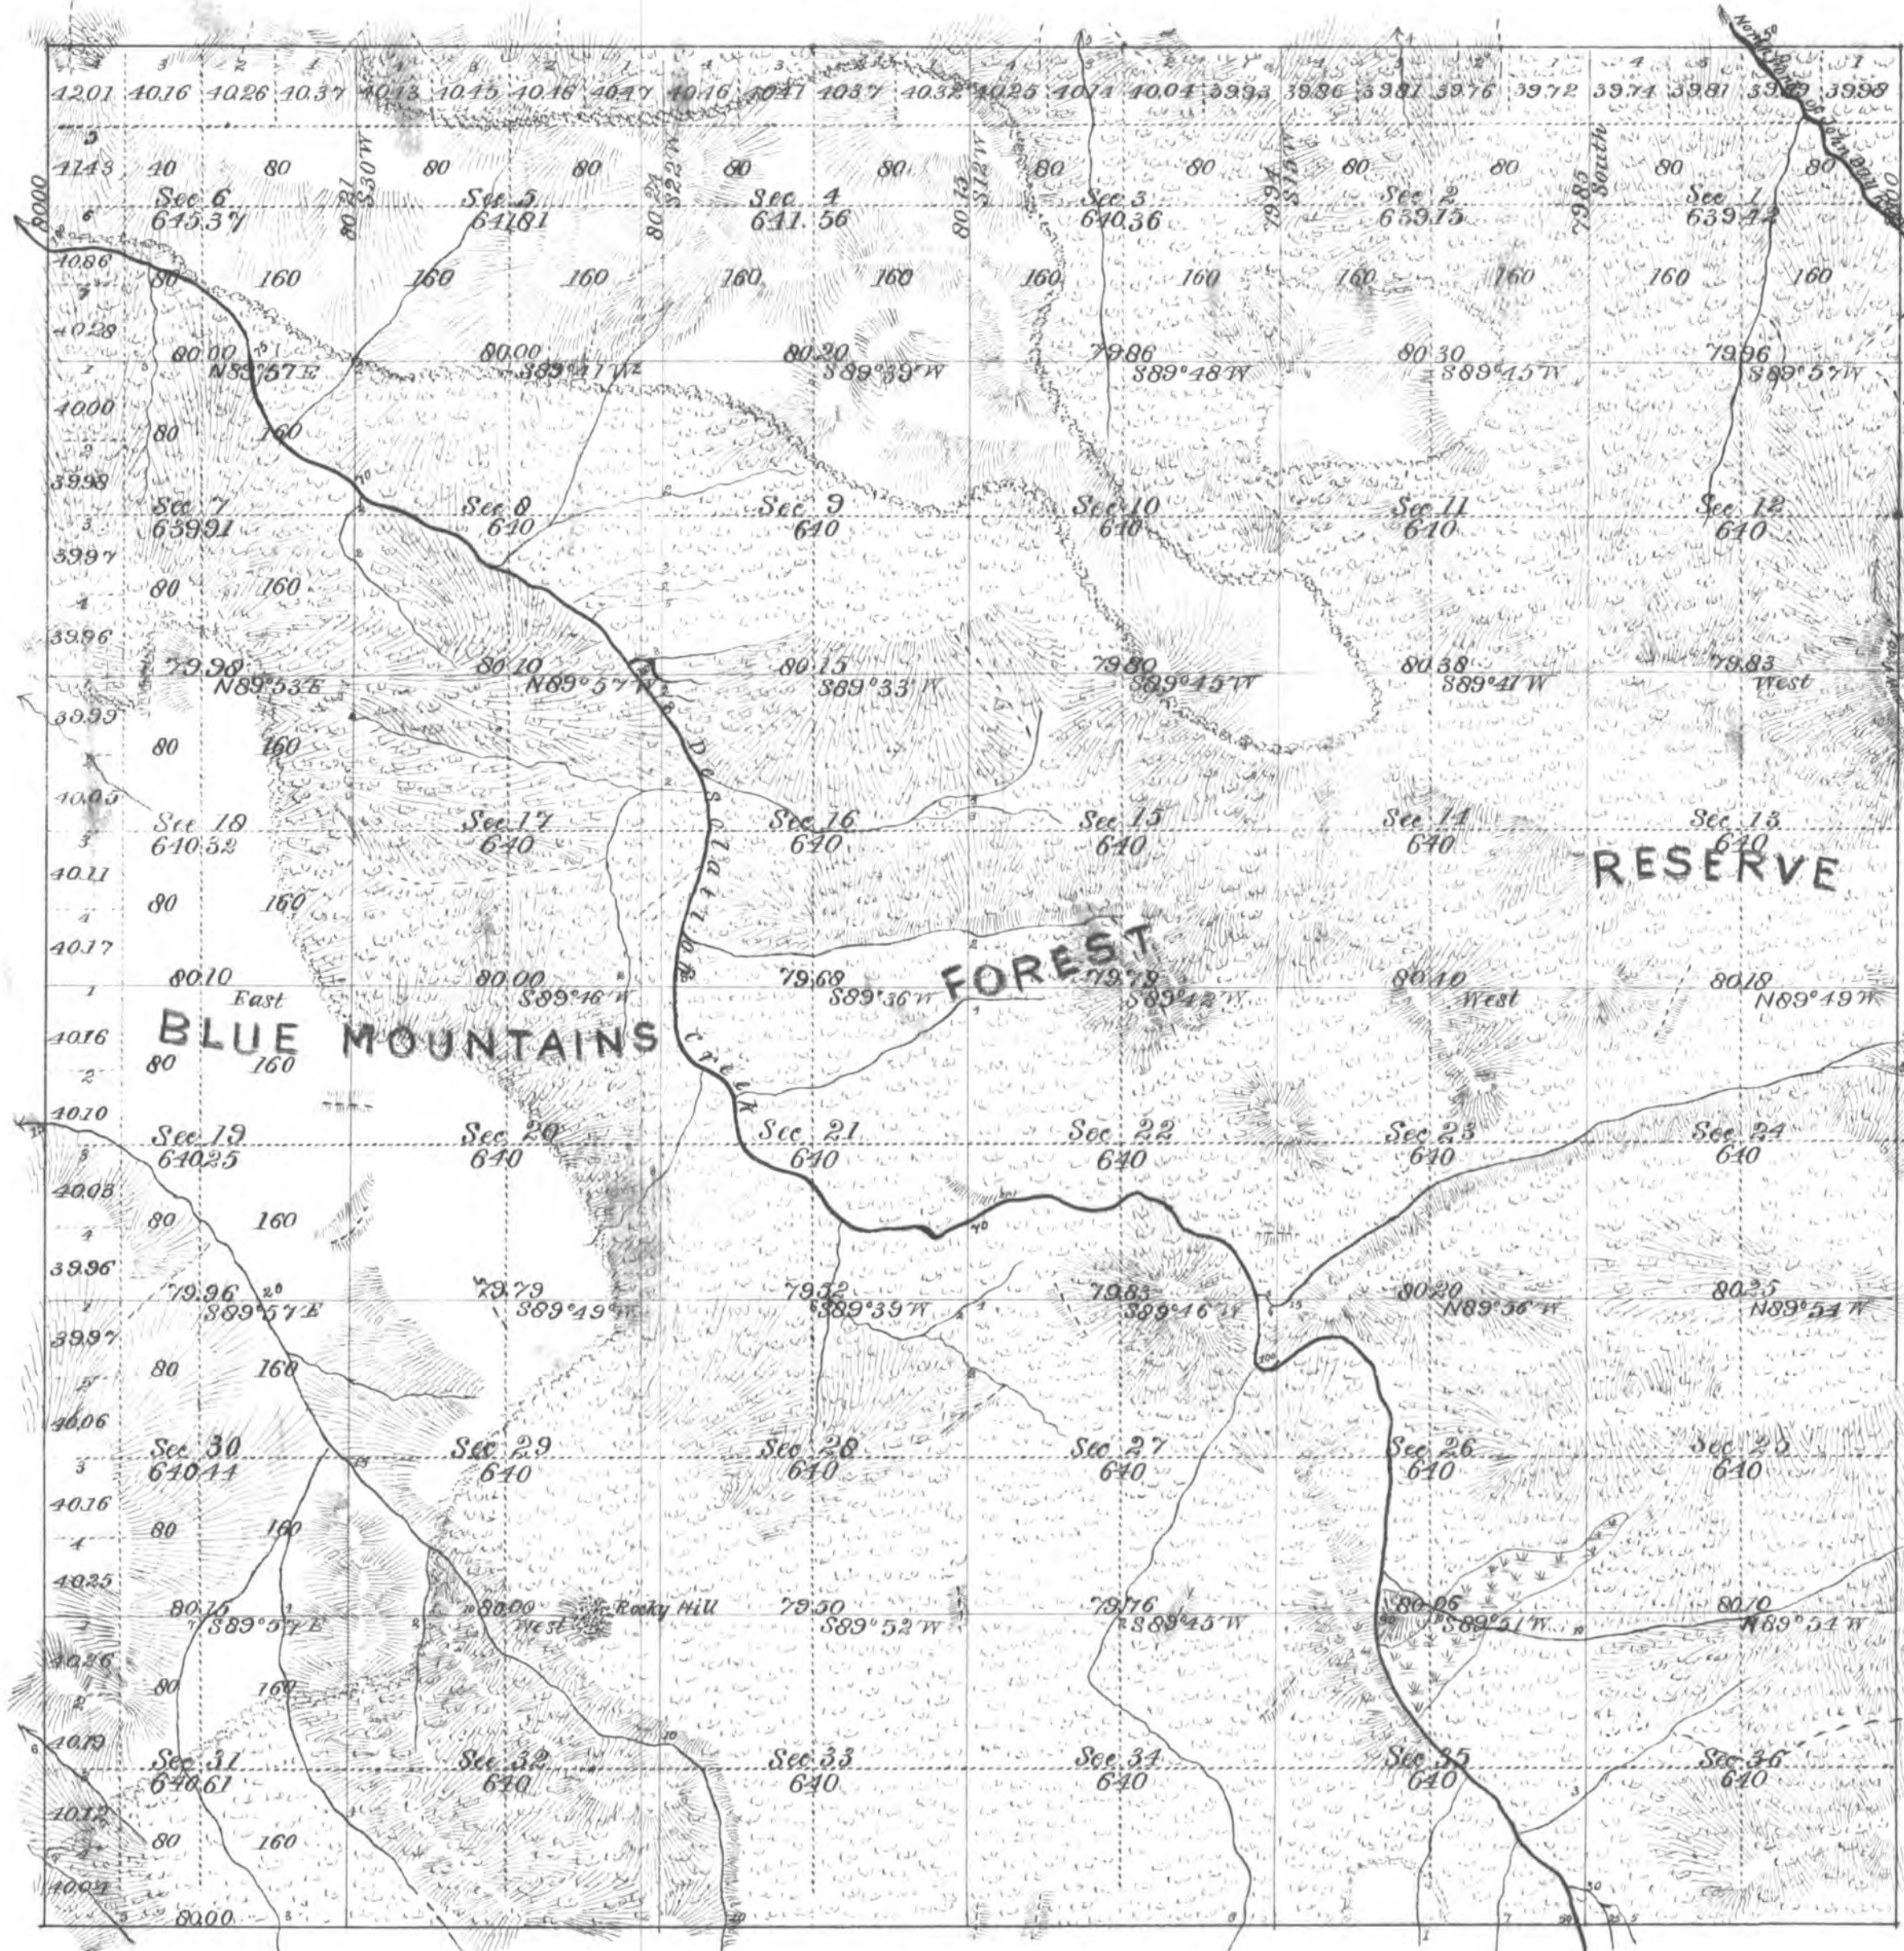

Total number of Acres 23,049.20

SURVEYS DESIGNATED.	BY WHOM SURVEYED.	NO.	DATE OF CONTRACT.	AMOUNT OF SURVEYS.			WHEN SURVEYED.	MEAN DECLINATION.
				Miles.	Chains.	Links.		
Township Lines	Moore & Thompson	382	March 23 1881					
Subdivisions	do do do		do do do	60	00	22	June 9 to 20, 1881	19° 37' 30" East

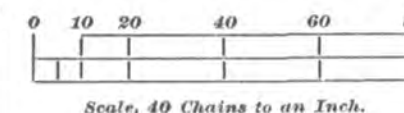

The above Map of the Subdivisions of Township No. 7 South of Range No. 32 East of the Willamette Meridian, Oregon, is strictly conformable to the Field Notes of the survey thereof on file in this Office, which have been examined and approved.

U. S. Surveyor-General's Office,
Portland, Oregon,

Dec 8, 1881. James C. Tolman
Surveyor-General of Oregon