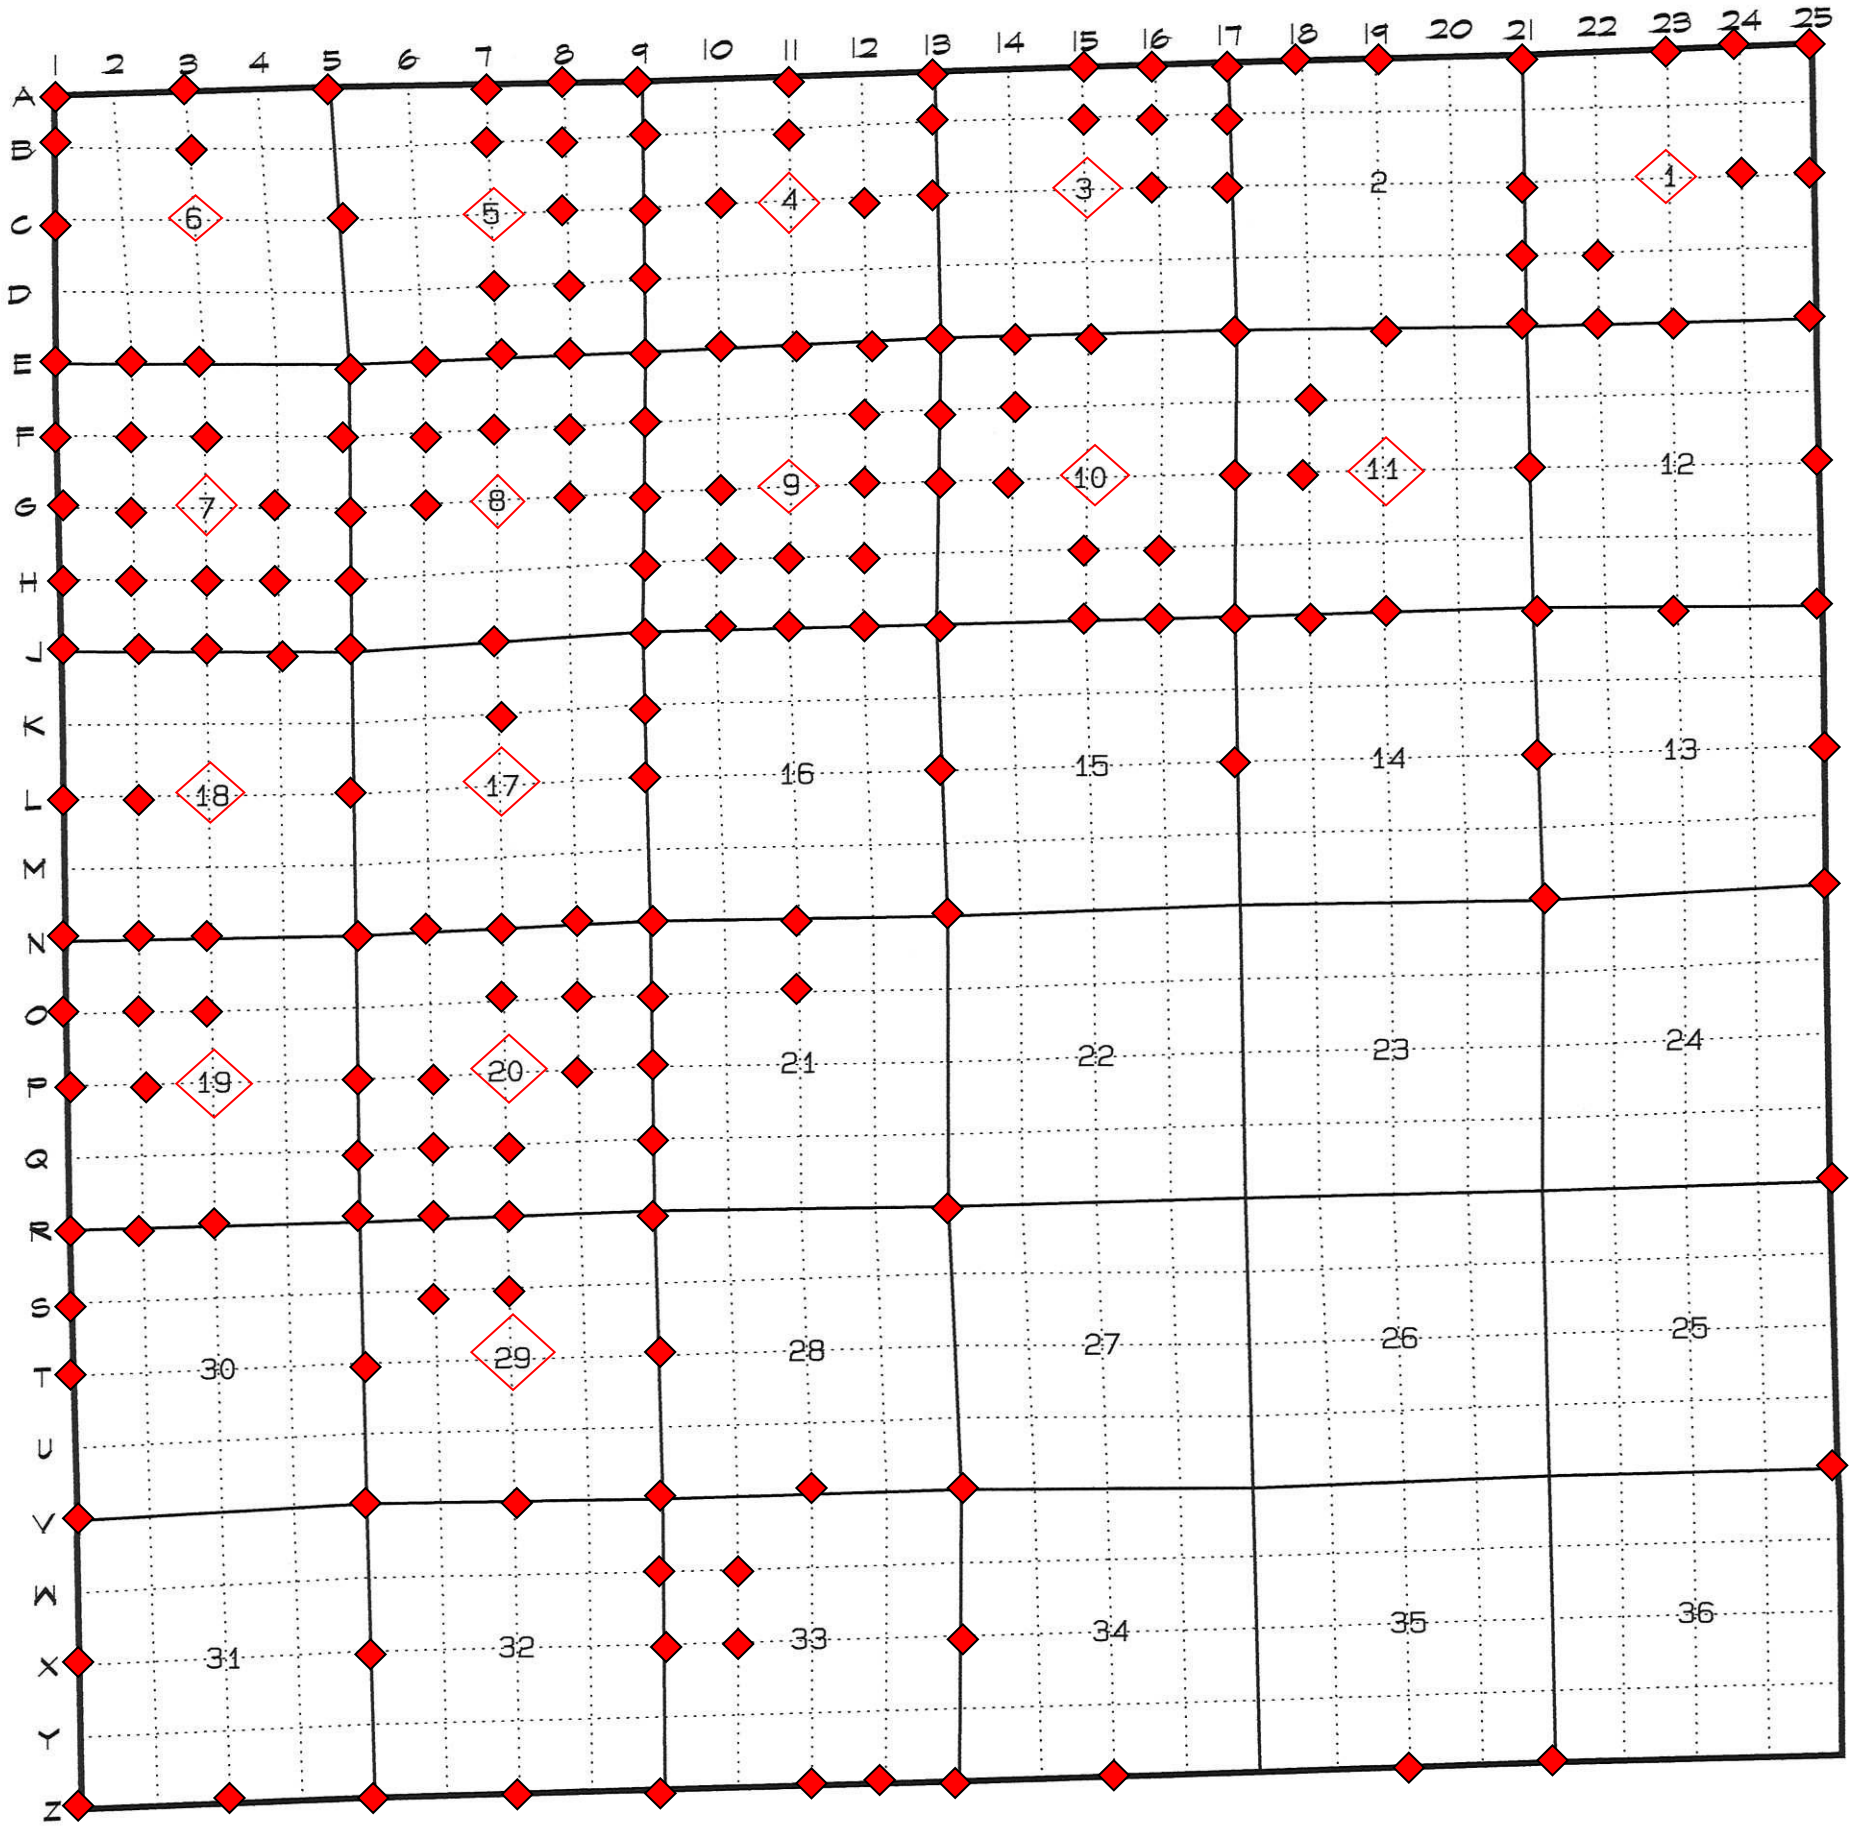TOWNSHIP 1 SOUTH RANGE 36 EAST