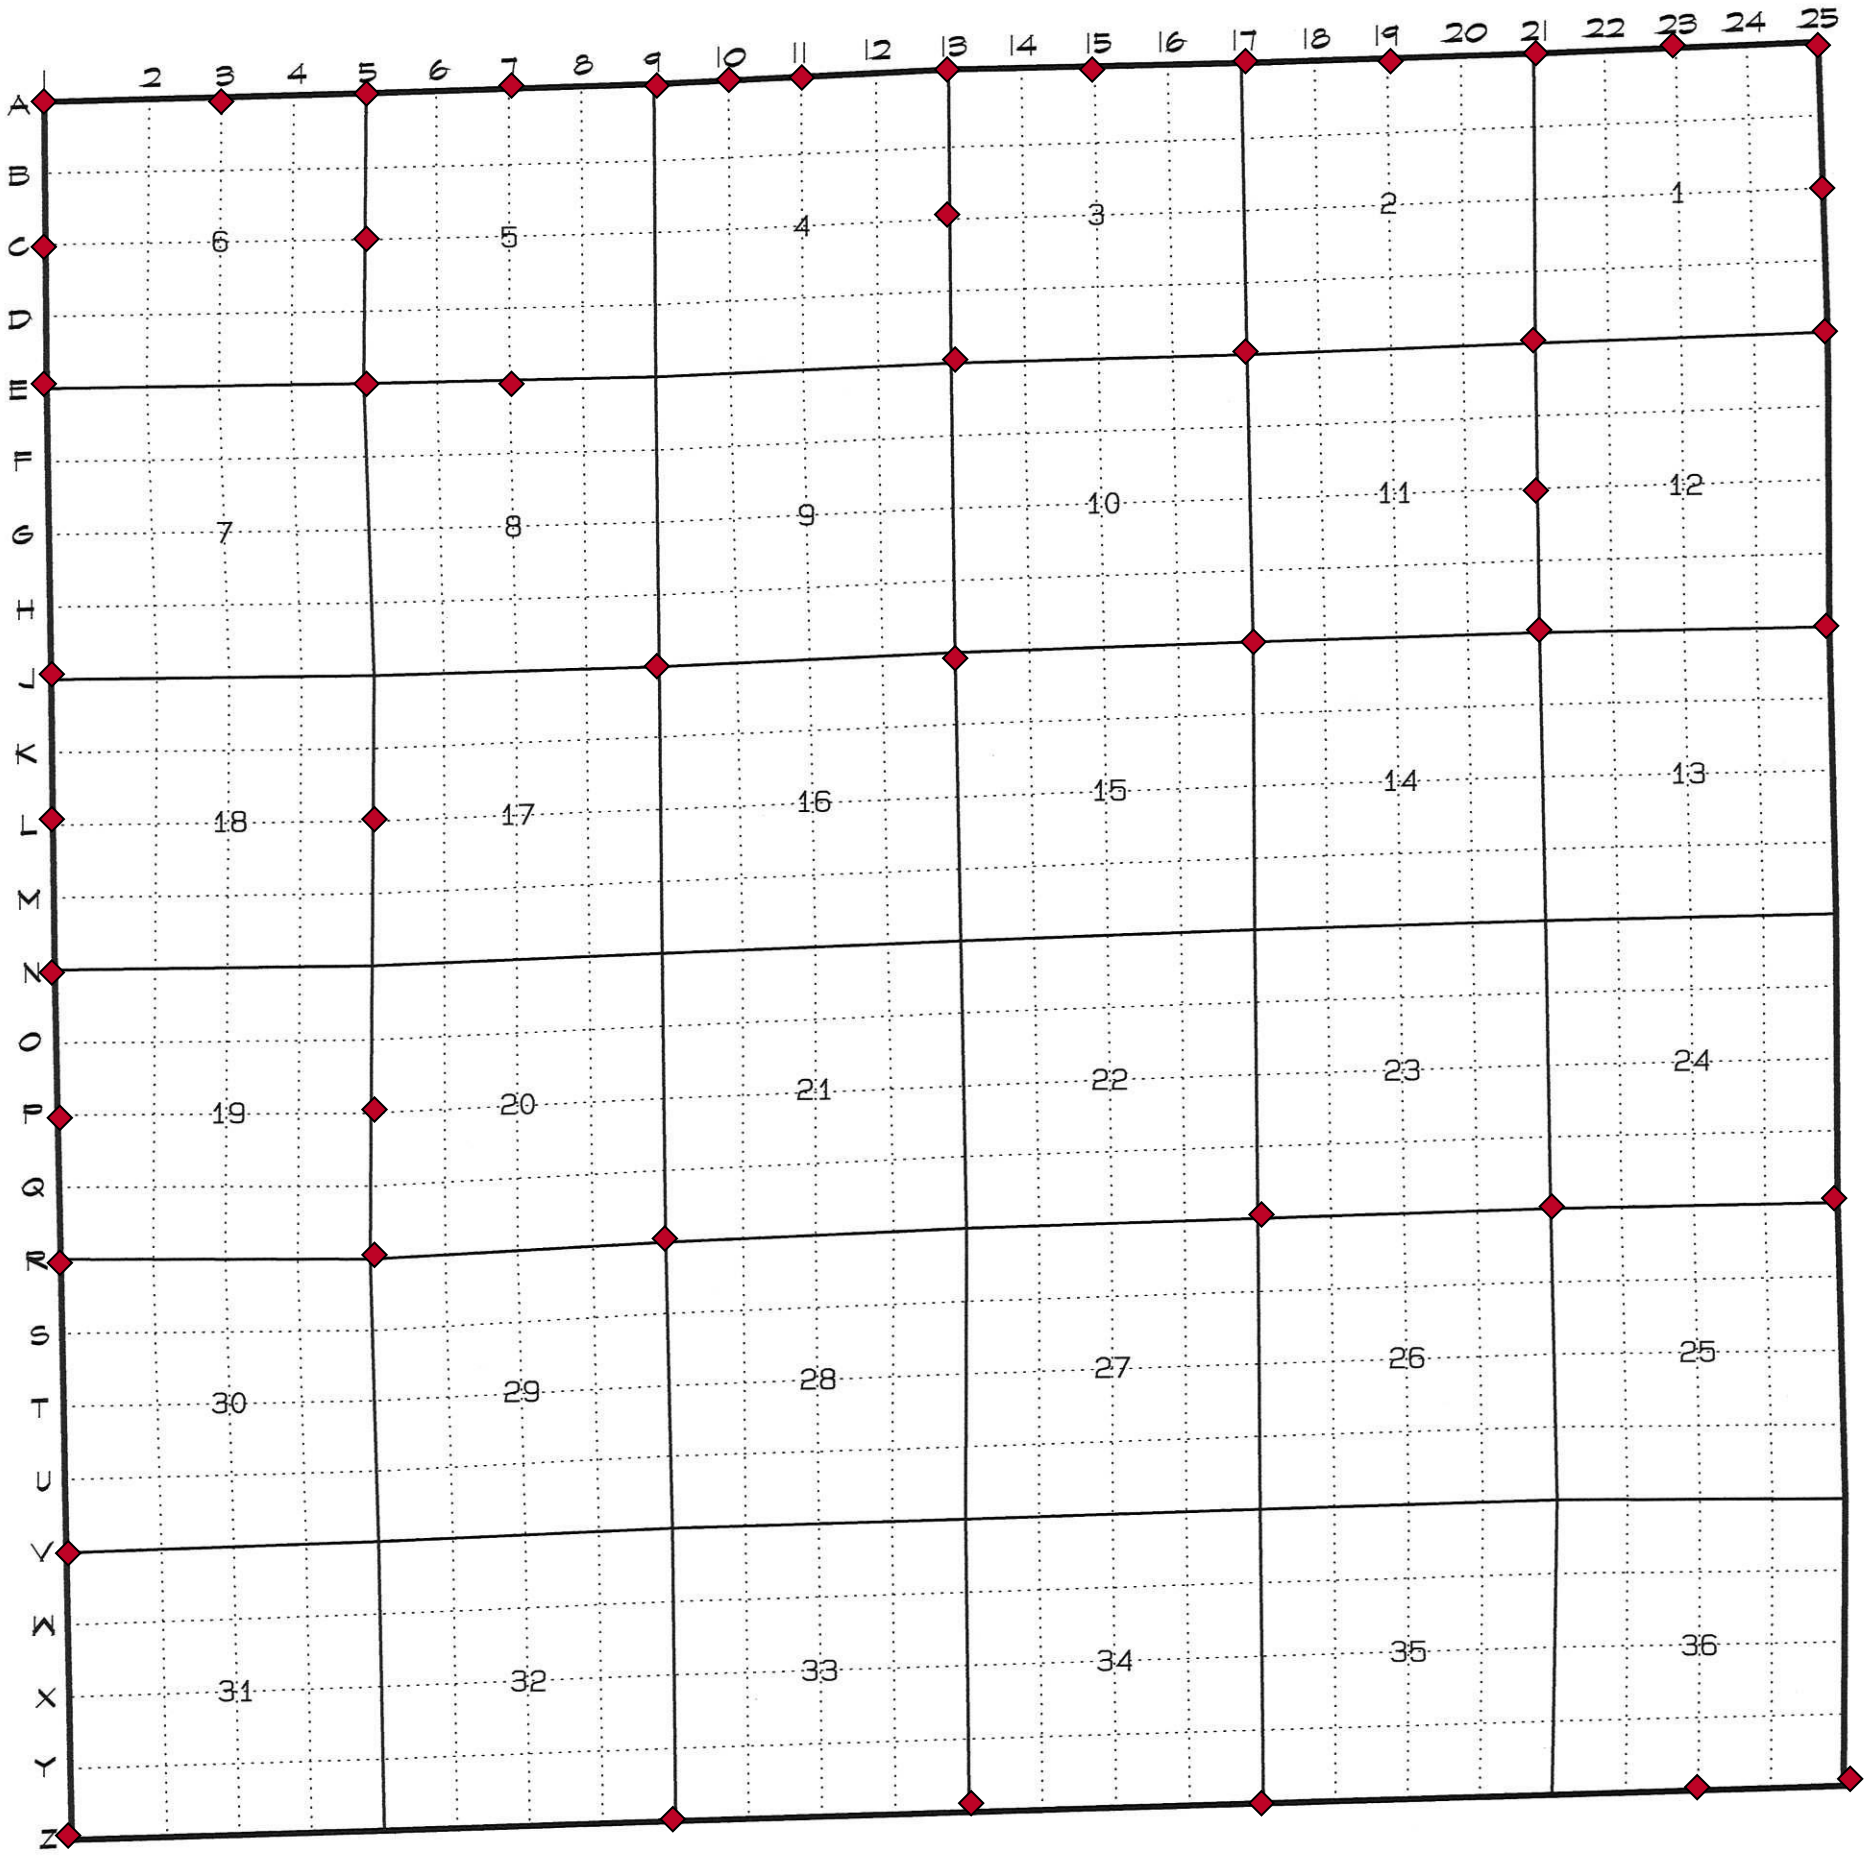TOWNSHIP 2 NORTH RANGE 29 EAST