


Township 1 North Range 32 East Willamette Meridian

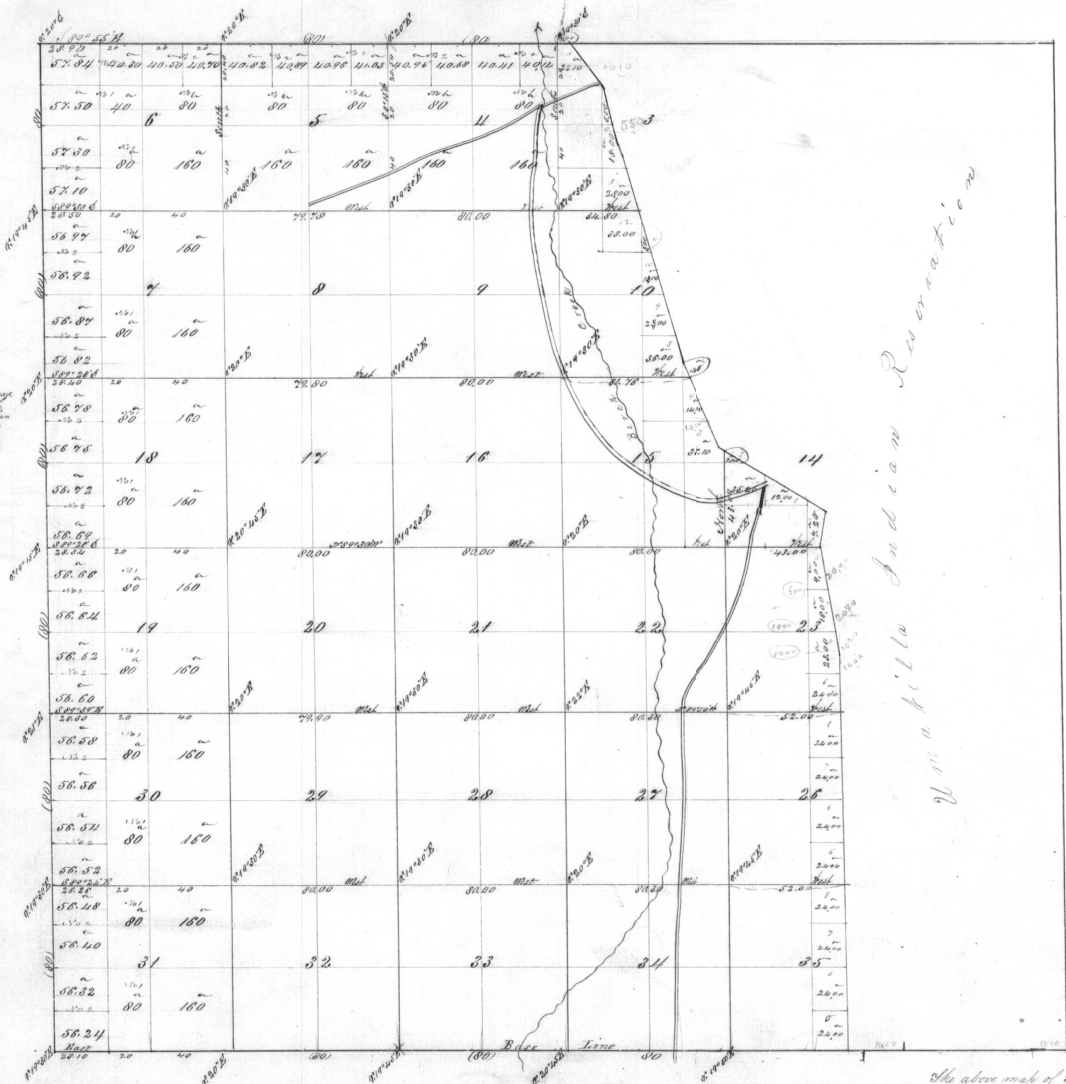

 Township 1 N. R. 32 E. Will. Mer.  
 for Oregon as reported on this plat  
 as aforesaid.  
 W. H. Burgess Surveyor  
 Eugene Ore.

See Gen





Total Area 16386.49

This above map of T. 1 N. R. 32 E. Will. Mer. Oregon  
 is hereby confirmed to the original field notes  
 of the survey hereon on file in this office which have  
 been examined and approved  
 Surveyor General's Office  
 Eugene Ore. October  
 2nd 1892

W. H. Burgess  
 See Gen