4183

Township No. 1 South Range No. 33 East Willamette Meridian, Oregon

Compared with books
Compared

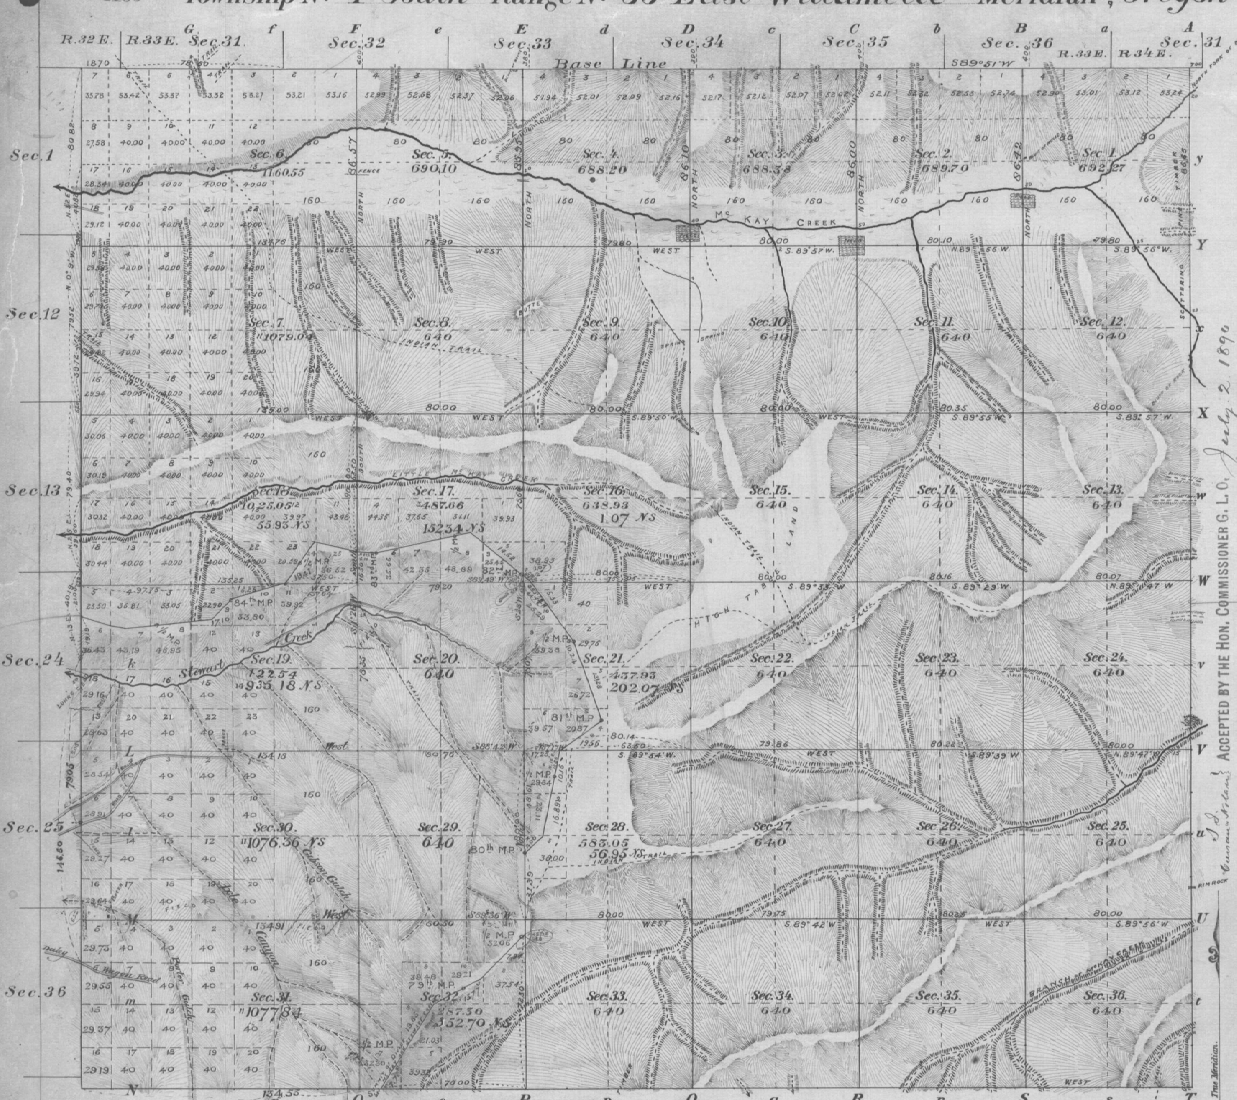

Area of Former Survey 20,790.70 — of New Survey 5190.44 Total number of Acres 25,981.14

Surveys Designated	By Whom Surveyed	Date of Contract	Amount of Surveys M.	Ch.s	Lk.s	When Surveyed	Mean Declination
Township lines	Currin.ns Noland	May 4 1887					
Subdivisions			51	67	91	July 11 to 19 1887	19° 30 E.
Connections				68	68		
Subdivisions	John C. Arnold	March 19 1890	11.	74	78	Sept 10 to 16. 1890	22° 15' E
Retracing Exterior Line			1	65	50		
Connections				11	50		
Contract No. 551							

Meanders of

Posts	Courses	Ch.s Lk.s	Posts	Courses	Ch.s Lk.s	Posts	Courses	Ch.s Lk.s

ACCEPTED BY THE HON. COMMISSIONER G. L. O. July 2. 1890

ACCEPTED BY THE HON. COMMISSIONER G. L. O. July 26. 1893

The above Map of Township No. 1 South, of Range No. 33 East Willamette Meridian, Oregon, is strictly conformable to the field notes of the survey thereof on file in this Office, which have been examined and approved.

Surveyor General's Office,
Portland, Oregon
September 20. 1892.

H. Henry Hyde
Sur.r Gen.l for Oregon

The above Map of Township No. 1 South, of Range No. 33 East Willamette Meridian, Oregon, is strictly conformable to the field notes of the survey thereof on file in this Office, which have been examined and approved.

Surveyor General's Office,
Portland, Oregon June 14. 1890

Douglas W. Taylor
Sur.r Gen.l