4334

Township No. 1 South Range No. 35 East of the Willamette Meridian Oregon

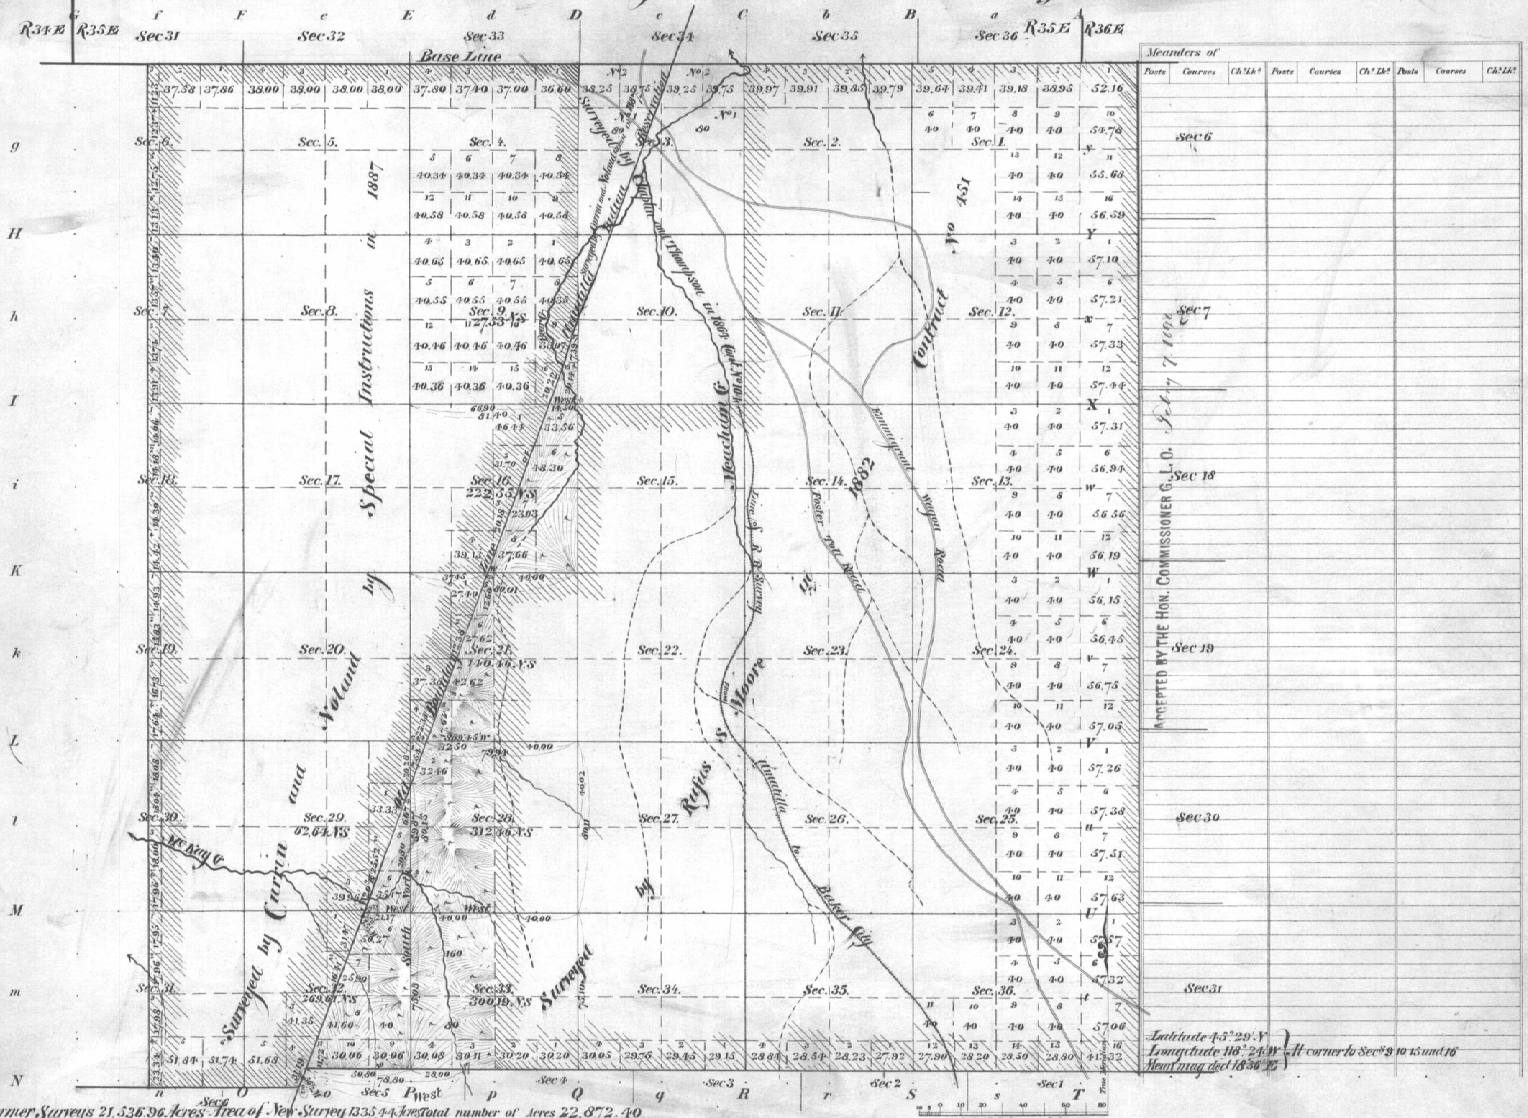

Area of Former Surveys 21,536.96 Acres Area of New Survey 1335.44 Acres Total number of Acres 22,872.40

Surveys Designated	By Whom Surveyed	Date of Contract	Amount of Surveys M. Ch's Lk's	When Surveyed	No. of Contract
Township lines Protracted on South Bd'y Subdivisions	Manius Buchanan	April 19th 1895	3 . 05 . 63	June 28 to 30 1895	635
Connections			31 70		
North Boundary	T. W. Davenport	July 20 1863		1863	102
" " Re Surveyed	Curran and Noland	May 4 1887		1887	Special Instructions
East Boundary	J. C. Cooper	July 1 1881		1881	397
S. Bd'y of Secs 33 34 35 & 36					
West Boundary	Curran and Noland	May 4 1887		1887	Special Instructions
S. Bd'y of Secs 31 & 32					

The above Map of Township No. 1 South of Range No. 35 East of the Willamette Meridian, Oregon, is strictly conformable to the field notes of the survey thereof on file in this Office, which have been examined and approved.

Surveyor General's Office,
Portland, Oregon November 28, 1896

Robert A. Habersham
Sur. Gen. for Oregon