


Township N. 2 North Range N. 28 East Willamette Meridian.

3828

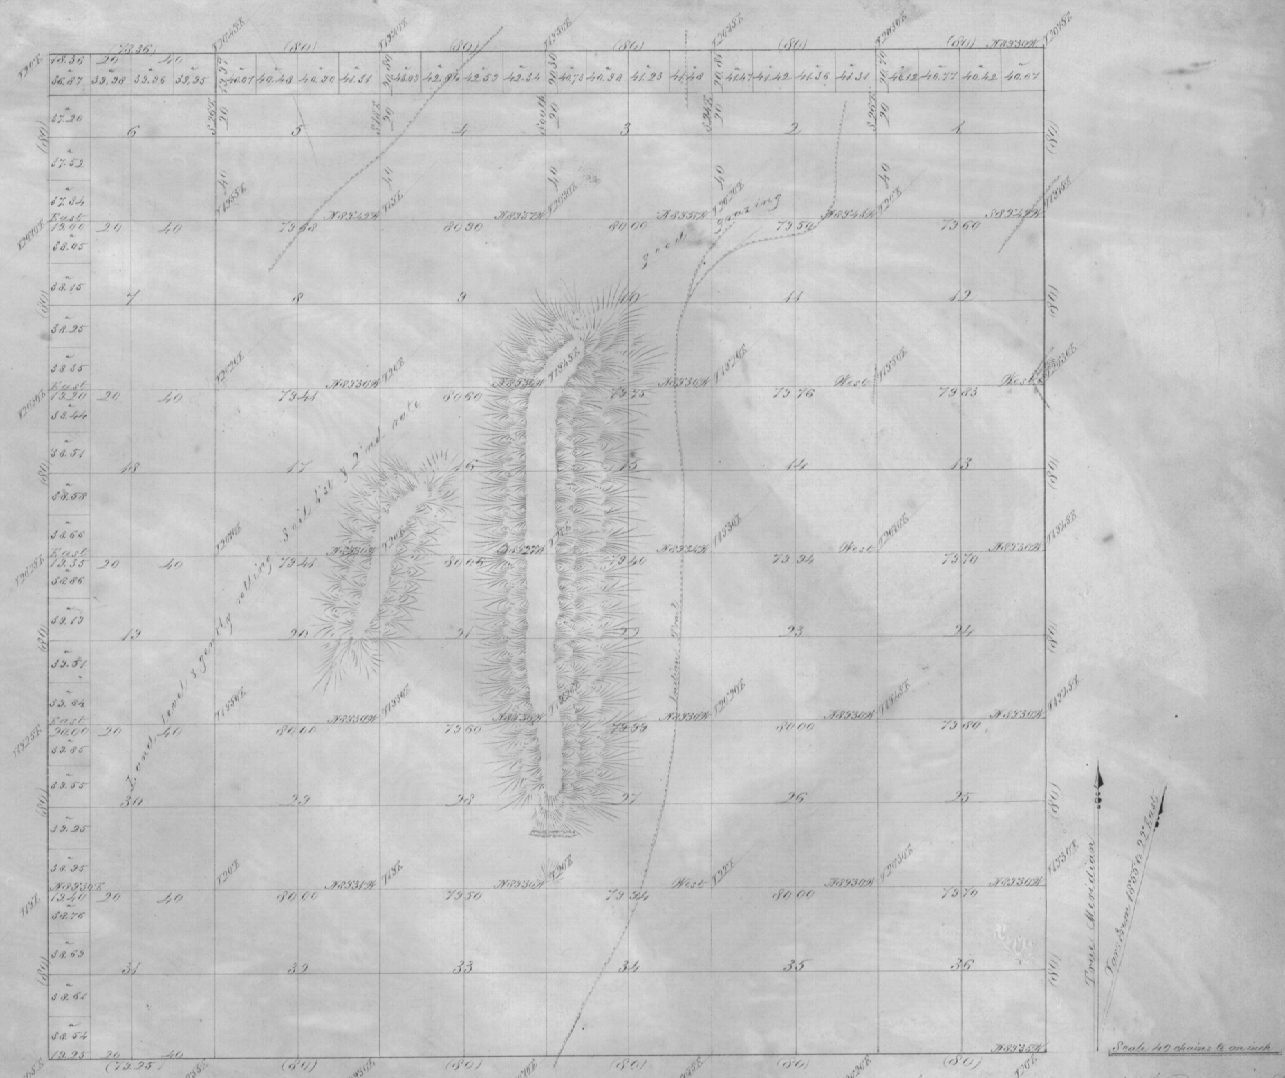

Surveys designated	By whom surveyed	Contract		Acut. or surveys		When surveyed
		No.	Date	Acres	Chains	
Township Lines	David P. Thompson	83	July 22nd 1853	11 7/8	35	January 31st 1860
Section lines 1-36	David P. Thompson	83	July 22nd 1853	5 3/4	60	January 31st 1860
Total quantity of Acres 25030.83.						

The above Map of Township N. 2 North, Range N. 28 East of the Willamette Meridian, Oregon, is herewith confirmed to the full extent of the survey thereof on file in this Office, which have been examined and approved.
 Surveyor General's Office
 Eugene City, January 31st 1860.
 J. W. Chapman
 Sec. Gen.
 O. G. W.