


Township No. 4 North Range No. 37 East Willamette Meridian, Oregon.

4462

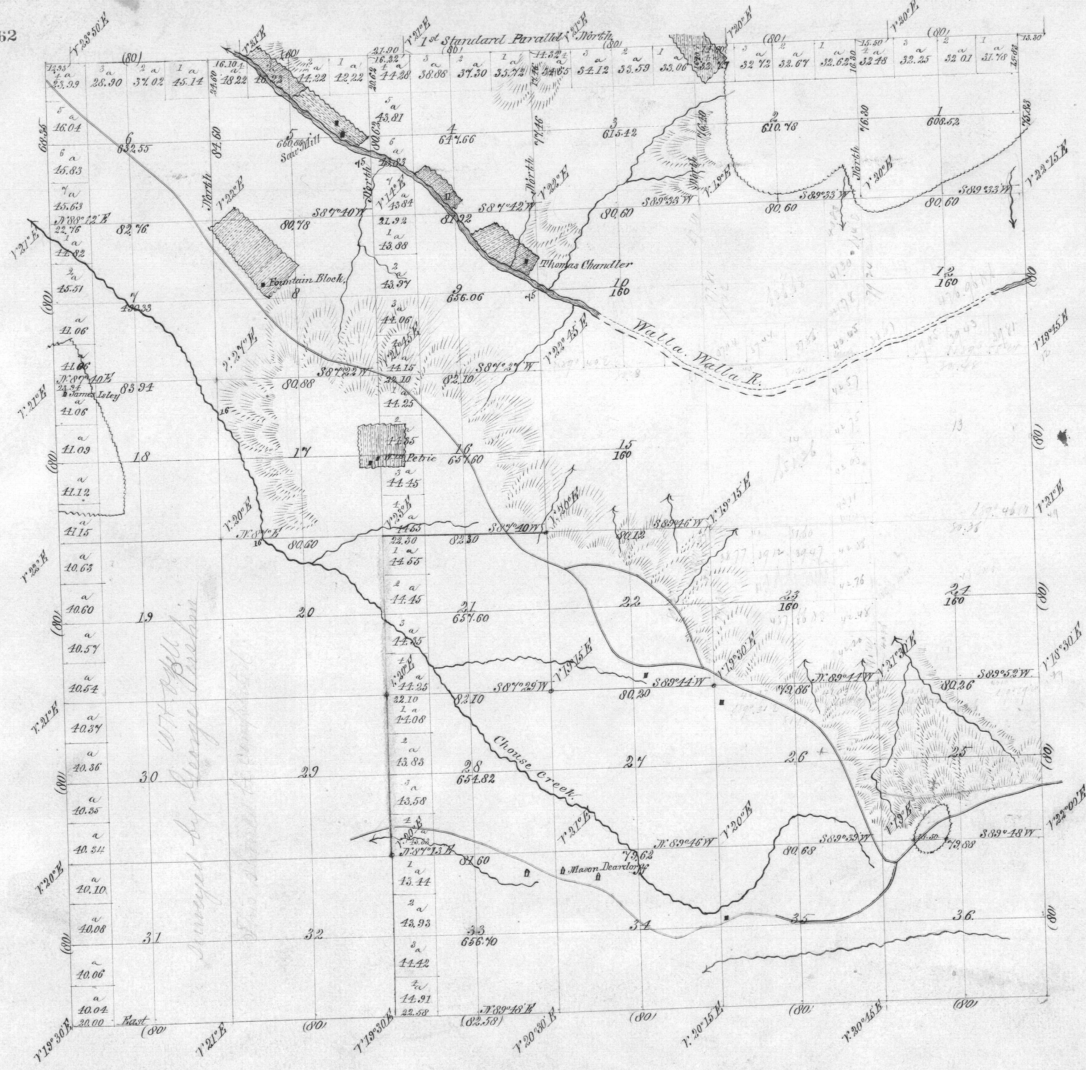

*General Description*  

Total Acres, 13500.32.



Scale 40 Chains to an Inch.

Lines.	Contractor.	Contract.		Amount Surveyed.			Commenced.	Completed.
		No.	Date.	Miles.	Chains.	Links.		
Subdivision Intersections.	Geo. S. Perkins	533	July 29, 1879	41.	76	74	August 16, 1879	August 30, 1879
	"		Total	42.	73	48		
Augmented States	"	532		37.	72	48		
	"			4.	21.	00		

The above Map of the subdivision lines of Township No. 4 North Range No. 37 East Willamette Meridian, Oregon, is strictly conformable to the original field notes of the survey thereof on file in this office, which have been examined and approved.  
 U. S. Surveyor-General's Office,  
 Portland, Oregon, Oct. 22<sup>d</sup> 1879.

*James C. Freeman*  
 Surveyor-General of Oregon