4463

Township No 4 North Range No 37 East of the Willamette Meridian Oregon

G f F e E d D c C b B a A

First Standard Parallel North

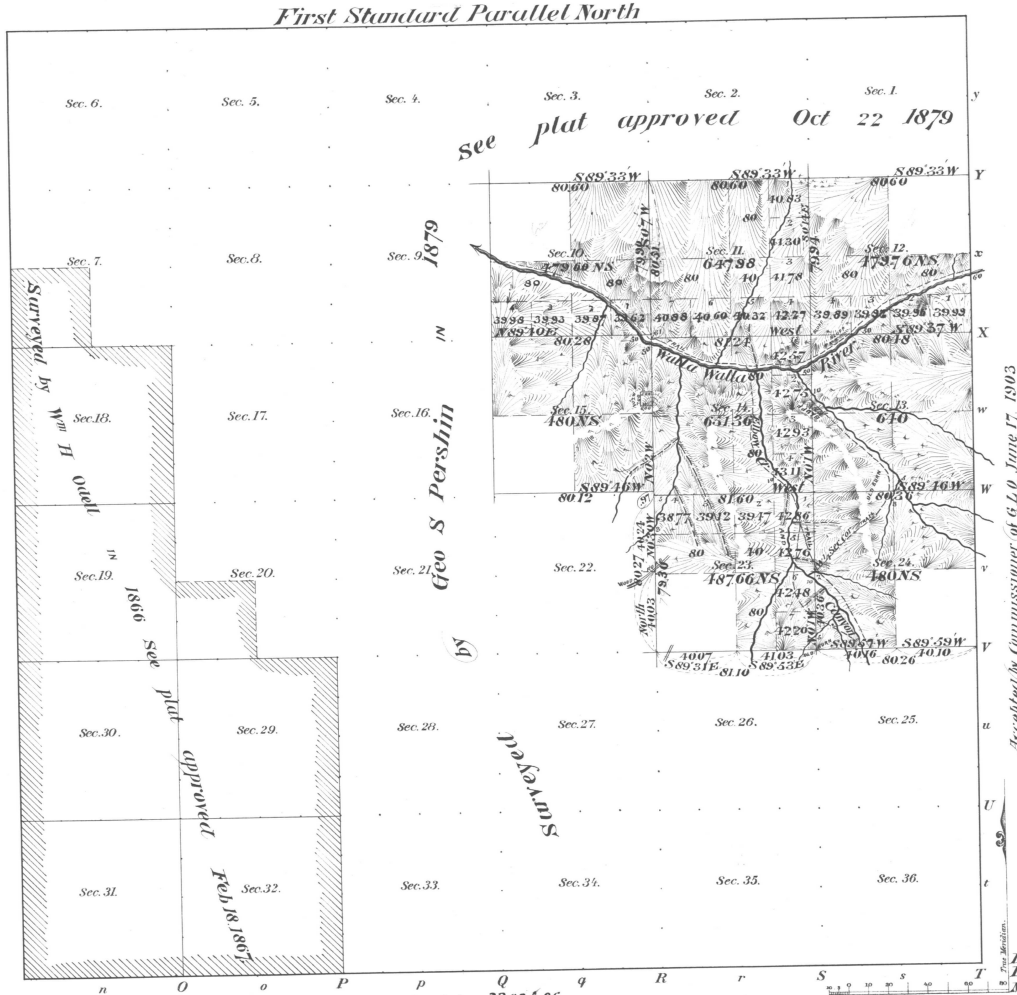
See plat approved Oct 22 1879
Sec. 6.
Sec. 5.
Sec. 4.
Sec. 3.
Sec. 2.
Sec. 1.
Sec. 7.
Sec. 8.
Sec. 9.
Sec. 10.
Sec. 11.
Sec. 12.
Sec. 18.
Sec. 17.
Sec. 16.
Sec. 13
Sec. 19.
Sec. 20.
Sec. 21
Sec. 22.
Sec. 23.
Sec. 24.
Sec. 30.
Sec. 29.
Sec. 28.
Sec. 27.
Sec. 26.
Sec. 25.
Sec. 31.
Sec. 32.
Sec. 33.
Sec. 34.
Sec. 35.
Sec. 36.
Surveyed by Wm H Odell
Surveyed by Geo S Pershin
See plat approved Feb 18 1867
See plat approved 1879
Walla Walla River
Walla Walla River
S89°33'W
80.60
S89°46'W
80.12
S89°31'E
80.10
S89°53'E
80.26
S89°37'W
80.30
S89°39'W
80.10
N89°40'E
80.28
S89°37'W
80.18
64788
64130
