4519

Township No. 4 North Range No. 38 East of the Willamette Meridian Oregon.

R.37E. R.38E. R.38E. R.39E.

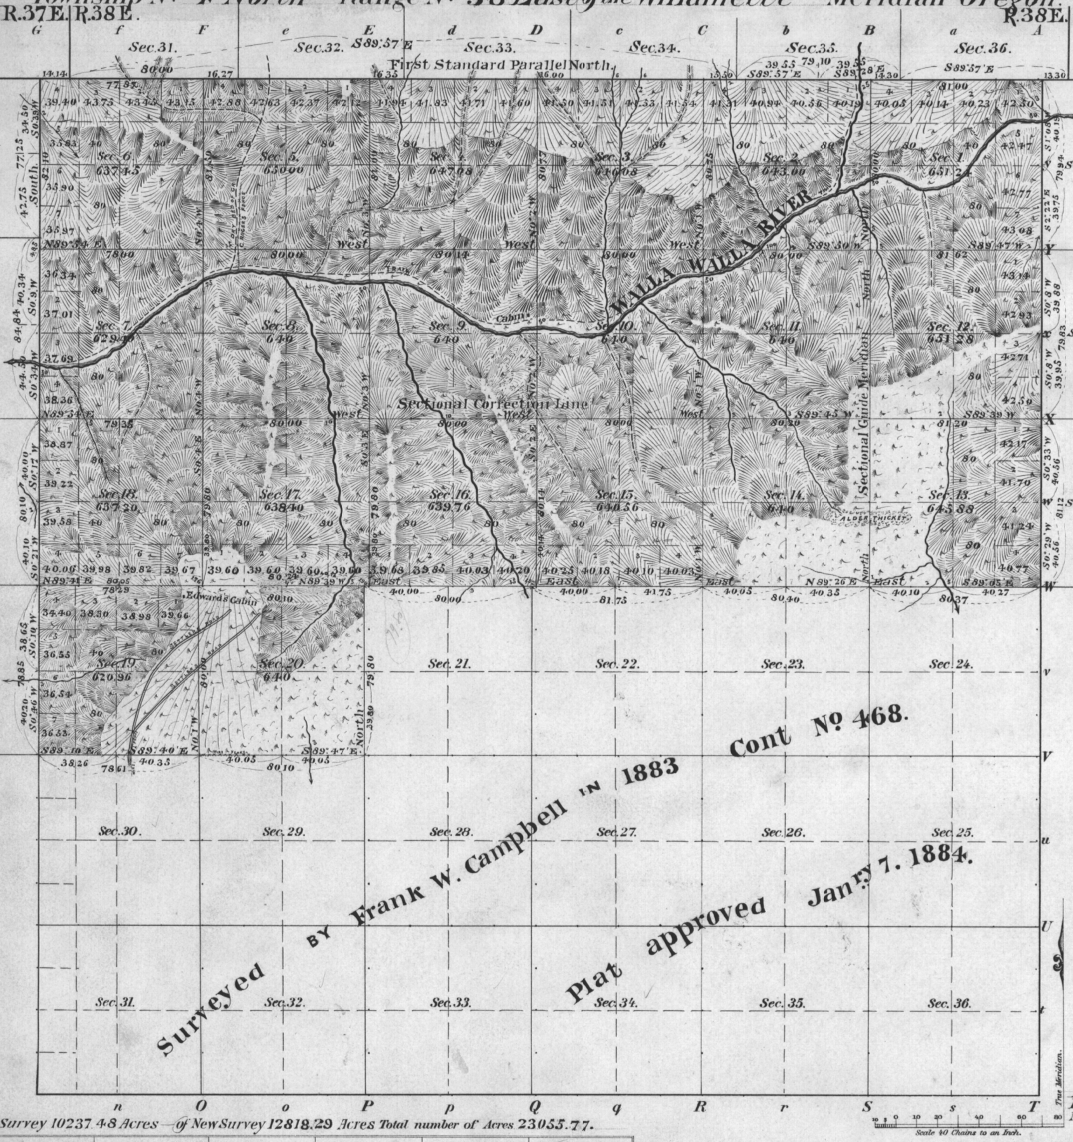

Meanders of

Posts	Courses	Ch. Lk.	Posts	Courses	Ch. Lk.	Posts	Courses	Ch. Lk.

The above Map of Township No. 4 North, Range No. 38 East of the Will Mer. Oregon, has been amended to conform to the supplemental field notes of the resurveys and retracements, made by R. F. Omeg D.S. on file in this office, which have been examined and approved, made by order of Hon. Commissioners Letter 'E' dated April 14. 1907.
Surveyor-General's office.
Portland Oregon June 29. 1907.
Jno D Daly
Sur. Gen'l for Oregon

ACCEPTED BY THE HON. COMMISSIONER G. L. O. Oct 24. 1907

Latitude 45° 49' N
Longitude 118° 2' W.
Mean Mag Dec'l 23° 30' E.
At cor of Secs 13. 18. 19. and 24. on E. Bd'y of Tp.

Area of Former Survey 10237.48 Acres — of New Survey 12818.29 Acres Total number of Acres 23055.77.

Surveys Designated	By Whom Surveyed	Date of Contract	Amount of Surveys M.	Ch.	Lk.	When Surveyed	No. of Contract
Township lines N. & E. ⅝ W. Bd'ries	Geo. S. Pershin	Sept. 19. 1878				1879	304.
Subdivisions Resurvey of Subdivisions ⅝ W. Bd'y of	Robert F. Omeg	June 16. 1905	30	02	66	July 21 1905 to May 6 1907	761.
Sec.s 6. 7. 18 & 19 on E. Bd'y of Sec.s 1 & 12 & 13.			7	01	03	17.	
Resurvey of part of 1st. St. Par'l N.			7	01	93	19.	
Connections			79	10		28.	
			1	08	85		

The above Map of Township No. 4 North, of Range No. 38 East of the Willamette Meridian, Oregon, is strictly conformable to the field notes of the survey thereof on file in this Office, which have been examined and approved.
Surveyor Generals Office,
Portland, Oregon. Jan'y 3. 1906
Jno D Daly
Sur. Gen'l for Oregon.

The above Map of Township No. 4 North, Range No. 38 East of the Will Mer. Oregon, has been amended to conform to the supplemental field notes of the retracements and resurveys made by R. F. Omeg D.S. on file in this office, which have been examined and approved, made by order of Hon. Commissioners Letter 'E' dated March 15. 1906.
Surveyor Generals Office.
Portland Oregon June 11. 1906
Jno D Daly
Sur. Gen'l for Oregon.