


S² SECTION 9

Tp 3N., R 29E.W.M.

Scale 1 inch = 400 feet.

East and West Center Line Section 9
3102

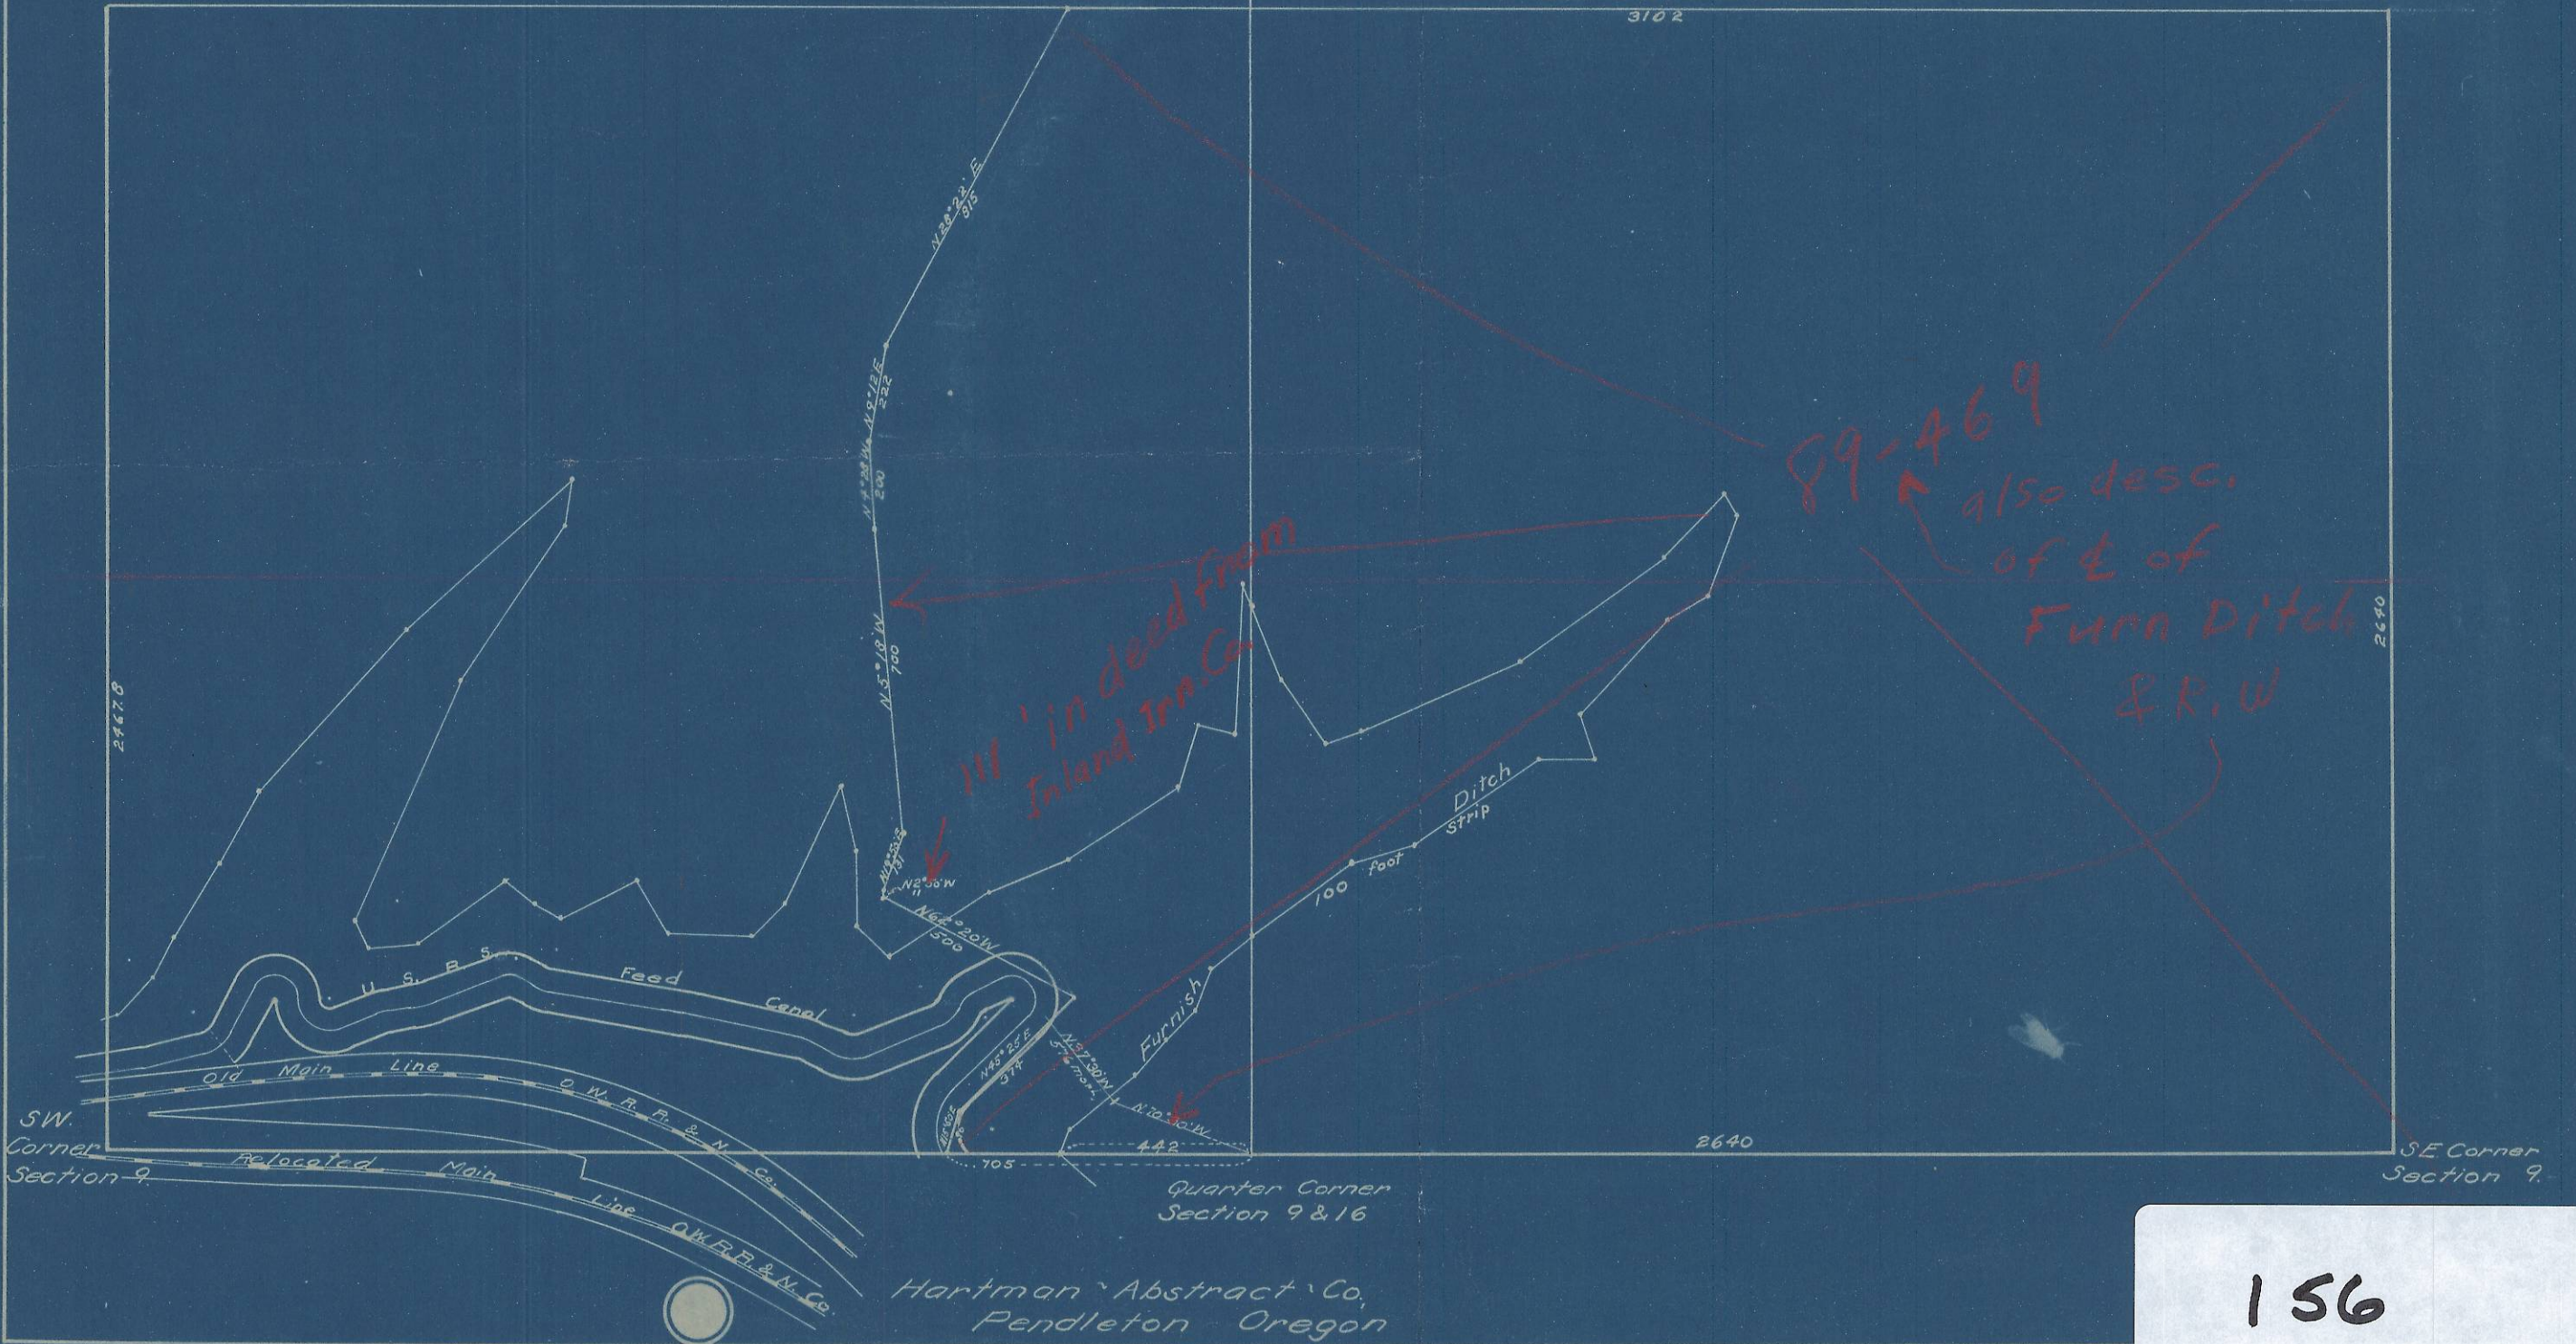

Hartman Abstract Co,
Pendleton Oregon

156