Surveyed for Miles Bowman Emile & Dean April 12 1888

by J.W. Kimbrell Dep.t Co. Surveyor

Plat No. 27

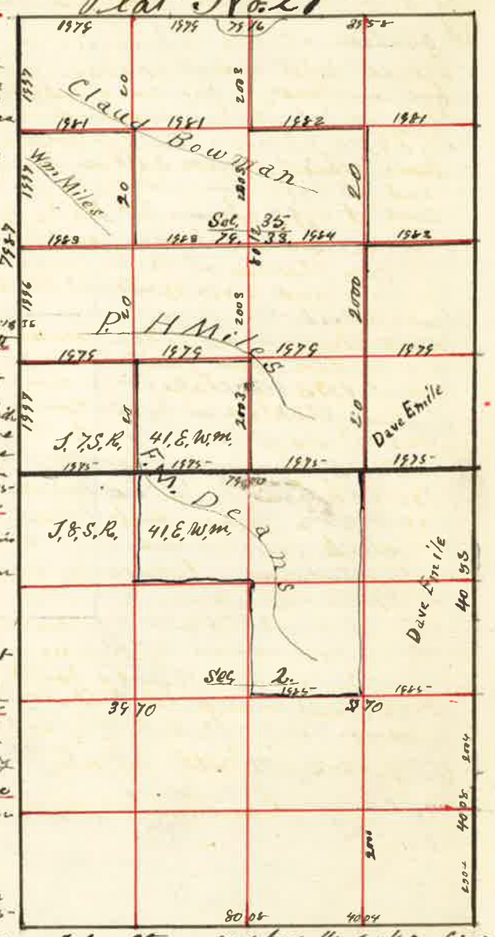

I Started at Sec. Corner to Sec 1=2=35&36 thence west at 20 chains set temporary stake for 1/8 corne at 40 chains set temporary stake for 1/4 sec corne at 4125 chains Powder River 166 links across at 60 chains set temporary stake for 1/8 corne at 80 chains corne gone and set temporary stake, and extended the line west and at 3850 chains the 1/4 sec. corne between Sec 35&36, at this point I had an deficiency of 150 links compared to the original field notes, I therefore run East on true line, var 19°30' E. and at 3850 chains established the sec corner to Sec 2=3=34&35 which is a stone marked, and at 1975 chains East from this corne I planted a stone for 1/8 corne and at 3850 chains planted a stone marked 1/4 for 1/4 sec corne between sec 2&35 and at 5925 set stone for 1/4 corner and at 7900 chains the corner to Sec 2=35=36
I then started at S.W. corner of Sec 35 thence North var 20° E at 20 chains set temporary stake at 3150 chains Powder river 186 links across at 40 chains set temporary stake at 60 chains set temporary stake for 1/4 sec corne at 7987 chains the sec corne to 26=27=34&35 from which I then south and at 1957 chains planted stone for 1/4 corne at 3957 chains planted stone marked 1/4 for 1/4 sec corne between sec 34&35 and at 5980 chains set stone for 1/8 corne and at 7987 chains the sec corne to Sec 2=3=34&35
I then started at the N.W. corne of Sec 35 thence East and at 20 chains set stake for temporary 1/4 corne and 40 chains set stake for temporary 1/4 sec corne and at 60 chains set stake for temporary 1/8 corne and at 80 chains I found no sec corner, and extended my line on East and at 3875 chains further on I found the 1/4 sec corne between sec 25&36, making the whole distance 1 1/2 miles 85 links short of the original field notes I therefore run west and at 3960 chains set stake for sec. corne temporary.
I then started at S.E. corne of Sec 35 thence North var 20° E at 20 chains set temporary stake at 40 chains set temporary stake at 60 chains set temporary stake and at 80 chains set stake for temporary sec. corner I deflected out of first stake, thence North and at 40 chains the 1/4 sec corne between sec 25&36 and at 40 chains planted stone marked for sec corne to sec 25=26=35&36, and thence South at 40 chains planted stone for 1/4 sec corne between sec 35&36 and at 60 chains set stone for 1/8 corne. I then started at the N.E. corne sec 35 and run west on true line and at 1975 chains set a stone marked 1/4 for 1/4 sec corne and at 3958 chains set a stake for 1/8 corne and at 5937 chains set stake for 1/8 corne. and afterwards planted a stone. I then started at the 1/4 sec corne on North side of sec 35 and run South. Letting random stakes at every 20=40=60 chains and 8012 chains the 1/4 sec corne on South side of sec 35. I then started at 1/4 sec corne on East side of sec 35 and run west through the center of sec 35 letting random stakes at every 20=40&60 chains and at 7933 chains the 1/4 sec corne on west side of sec 35. from which I run East and at 1983 chains set stone for 1/16 corne. From this corne I run North 20 chains being the proportionate distance and set a stone for center N.W. 1/4 sec 35 and also I run South from same corne 20 chains and set stone for center of S.W. 1/4 sec 35
I also started at the same corne and run on East to center of sec 35, 3966 chains and set stone for center thence South 2003 chains and set stone for 1/16 corne, thence East 1983 chains and set stone for 1/16 corne in center of S.E. 1/4 sec 35 thence North 20 chains and set stake for 1/16 corne thence North 20 chains and set stone for 1/16 corne in center of N.W. 1/4 sec 35 thence West 1982 chains and set stone for 1/16 corne
Some of these subdivisional lines I did not chain through as the opposite corner, being corne was in sight.
I started at 1/4 sec corne on west side of sec 2 thence East at 3970 chains center at 7940 chains the 1/4 sec corne from which I run west and at 1985 chains planted 1/16 corner. I started N.E. corne sec 2 and run South and at 4053 the 1/4 sec corne between sec 1&2 thence South at 4008 chains the S.E. corne of sec 2 from which I run North 2004 chains and set 1/8 corne a stone

J.W. Kimbrell Dep.t Co Surveyor

Surveyed for A.E. Eaton April the 13th 1888

by J.W. Kimbrell Dep.t Co. Surveyor

Plat No. 28

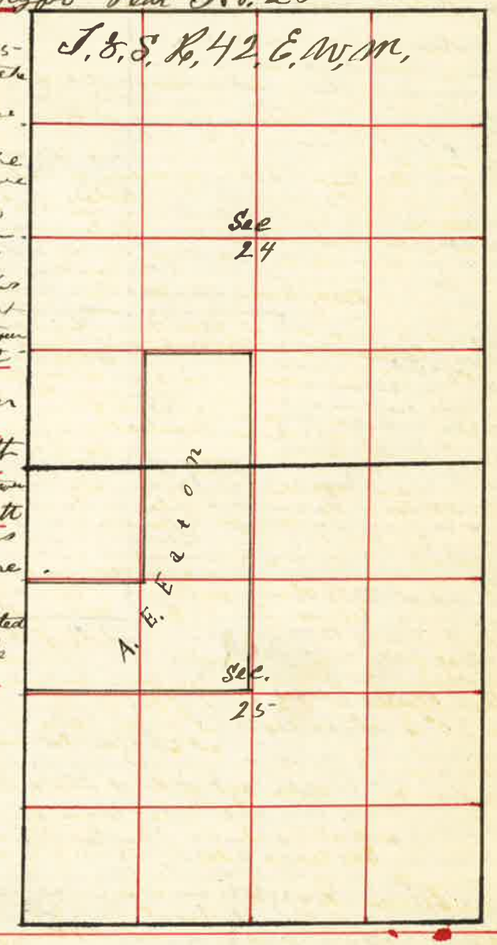

I Started at the N.E. corne of Sec 25 thence west and at 40 chains set stake for temporary 1/4 sec corne and at 60 chains set stake for temporary 1/8 corne at 7986 chains the sec corner, from which I run East on true line and at 1996 chains set stake for 1/8 corne and at 3993 chains set stake for 1/4 sec corne between sec 24&25.
I then started at N.W. corne of Sec 25 and run South at 20 chains set stake for temporary 1/8 corne and at 3985 chains the 1/4 sec corner between sec 25&26 from which I run North and at 1993 set stake for 1/8 corne
I then started at 1/4 sec corne on west side of sec 25 and run East 40 chains. thence North 3964 chains to 1/4 sec corner between sec 24&25 from which I run North through sec 24 and at 20 chains set temporary stake for 1/16 corne at 7944 chains the 1/4 sec corne between sec. 13&24 I then started at 1/8 corner on North side of the N.W. 1/4 sec 25 thence South 1992 chains and set stake for 1/16 corner in center of N.W. 1/4 sec 25

J.W. Kimbrell Deputy County Surveyor

Surveyed for Miles & Wilson April 14 1888 by J.W. Kimbrell Dep.t Co Surveyor

I Started at 1/4 sec corner between sec 35&36 from which I run South 4003 chains to sec corner to sec 1=2=35&36 thence North and at 2001 chains set stake for 1/8 corner
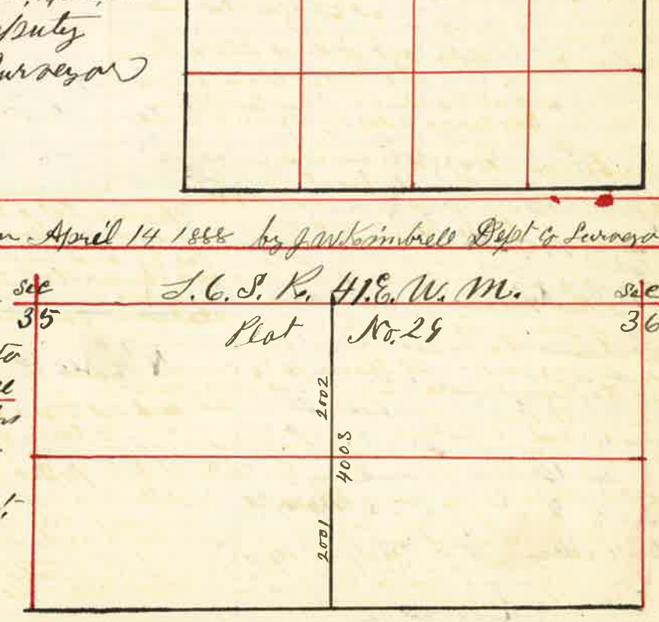
J.W. Kimbrell Dep.t Co Surveyor