Surveyed for C.E. Robbins Aug. 15 1888

By J.W. Kimbrell County Surveyor Plat No. 43.

T.5.S. R.40. E. W.M.

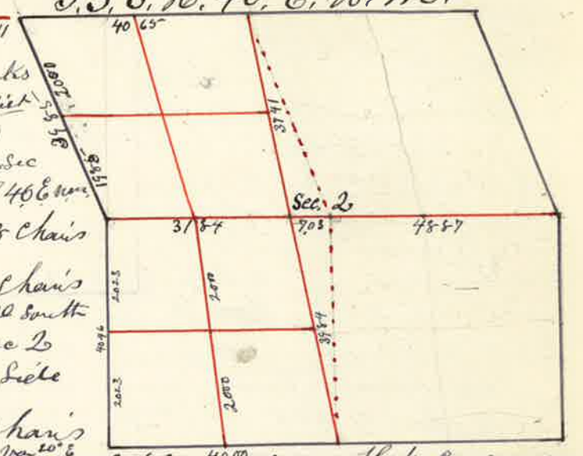

I Re-Established the Corners to Sec 2-3-18&11 from Which a Pine Tree 16 inch dia. Bears N 60½ W 32 lks dist
a " " 16 " Bears N 50° 30' E 135 lks dist
a " " 20 " " South 53° 45 W 275 " "
Thence East var 20° E 40 Chains ¼ Sec Corner on South Side Sec 2 T.5.S. R.40 E. W.M.
Thence North 12° W. 15 Chains Road 18 Chains Catherine Creek 100 lks Wide 20 Chains Set Stake at N.W. Corner of Sawmill South of Track 39.84 Chains Center of Sec 2 77.25 the ¼ Sec Corne on North Side Sec 2
Thence West var 20° E 40.65 chains the N.W. Corner Sec 2, Thence S 22° 30' E var 20° E 39.85 40.00 Chains the ¼ Sec Corner on West Side Sec. 2 Thence South var 20° E 40.46 Chains the S.W. Cor Sec 2 from Which I run North 20.23 Chains Set Post in Mound of Stone for ⅛ Corner 40.46 Chains the ¼ Sec Corner between Sec 2&3
Thence N 22° 30' E var 20° E 19.85 Chains Built Mound of Stone ⅛ Corner 39.85 Chains the Corner to 2-3-34&35 a Stone in Mound of Stone
the ¼ Sec Corner on West Side Sec 2 Thence East var 20° E. 31.84 Chains Intersect first line run North. 80.71 Chains the ¼ Sec Corner on East Side Sec 2 from Which I run West and at 40.35 Chains Built Mound of Stone. Equidistant between ¼ Sec Corners on the East and West Sides of Sec 2 and at 48.87 Chains Established the Center Sec 2 at the Intersection of the True lines Running East and West and North and South from ¼ Sec to ¼ Sec Corners, as Per. Instructions for Subdividing Sections, but this Section should be Divided More Exactly than the present Law will admit of.

J.W. Kimbrell County Surveyor

Surveyed for John Ervin Sept 1st 1888

By J.W. Kimbrell County Surveyor Plat No 44

T.8.S. R. 42. E. W.M.

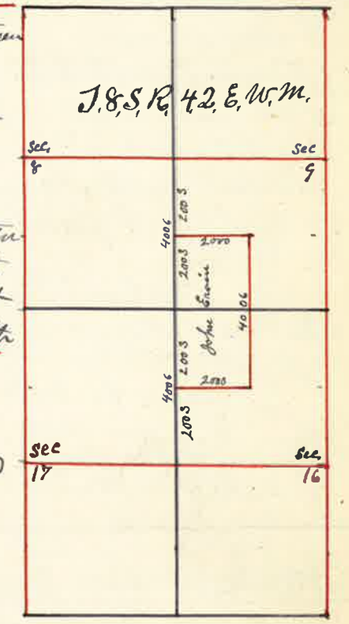

I Commenced at the ¼ Sec corner between Sec 16 and 17
Thence North var 20° E. at 20 Chains Set Stake for Temporary ⅛ Corner 60 Chains Set Stake for Temporary ⅛ Corner and at 80.12 Chains the ¼ Sec Corner between Sec 8&9 from which I run South on Same Variation at 20.03 Chains Set Post in Mound of Earth for ⅛ Corner and at 60.09 Chains Set Post for ⅛ Corner. Thence East 20 Chains North 40.00 Chains West 20 Chains to ⅛ Corner

J.W. Kimbrell
County Surveyor

Surveyed for John A. Tucker Sept. the 1st 1888

By J.W. Kimbrell County Surveyor Plat No. 45

T.8.S. R. 42. E. W.M.

I Commenced at the ¼ Sec. on the South Side of Sec. 16
Thence East at 20 Chains Set Stake for Temporary ⅛ Corner at 40.08 Chains found ¼ Sec Corner but at 80.18 Chains the ¼ Sec Corner between 10&15 making an Excess of 20 links over U.S. Field Notes Therefore run West and at 60.05 Chains Drove Post for ⅛ Corner

J.W. Kimbrell County Surveyor