Surveyed for Wm F. Haines June the 1st 1887

by J.W. Kimbrell Dep.t Co Surveyor Plat No. 7

I Started by Re-establishing the ¼ Sec. Corner between Sec 27 & 28 from which a Pine 12 inches Diameter Bears S 75° E 283 links Dist. and old Pine Stump Bears S 72° W 134 links in Place of which I marked a Pine 10 inches Diameter Bearing S 64° W 94 links Dist. From this Corner I run North and at 4430 Chains the Sec. Corner to Sec 21-22-27 & 28 thence West 4029 To ¼ Sec Cor on North Side of Sec 28. thence West between Sec 21 & 28 and at 20 chains Set Stake for Temporary ¼ corner at 3852 chains the Corner to Sec 20-21-28-29 Be Built Mound Ditches &c from which I run East Var 20° E and at 1926 chains Planted a Stone 7×10×14 inches for ¼ Corner thence South Var 20° E at 20 Chains I Planted a Granite Boulder 9×12×21 inches from which a Pine 6 inches Diam Bears N 58° E 19 links Distant a Pine 22 inches Diameter Bears N 77° W 67 links a Pine Tree 8 inches Diameter Bears S 48° E 88 links Distant thence N 44° E 2505 chains to ¼ Sec. Corner on North Side of Sec 28

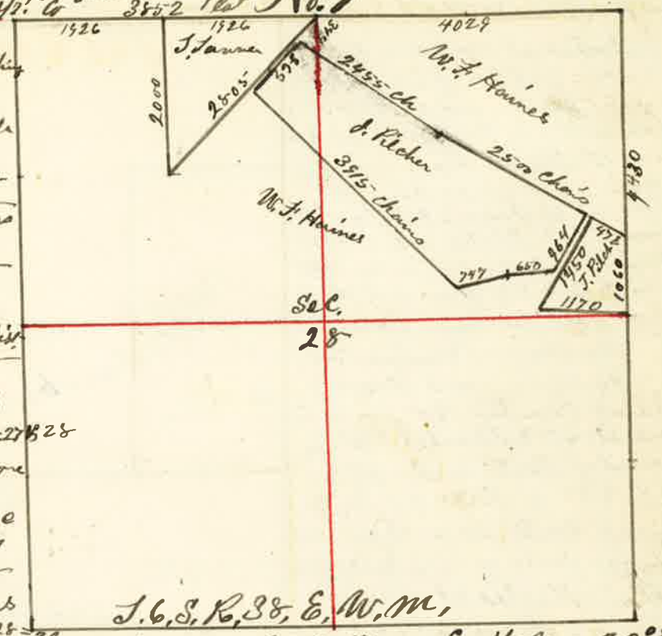

Thence S 38° West 3¼ chains a Stone 4×5×9 inches Thence S 44° W 868 chains a Stone 6×8×17 inches Thence S 43° E 3815 chains a Stone 6×10×16 inches Thence N 76° E 747 chains a Stone 4×4×12 inches Thence N 83° E 650 chains a Stone 8×8×16 inches Thence N 30° E 964 Chains a Stone 3×8×14 inches Thence N 54° W 2455 Chains to Place of Beginning a Stone 4×5×9 inches I then started at ¼ Sec. Corner on East Side of Sec 28 from which I run N 88° W 1170 chains to a Pine Tree 26 inches Diameter, Thence N 30° E 1450 Chains to Stone 6×6×14 inches Thence S 61° E 472 chains a Stone 6×10×16 inches Thence South 10 chs to Place of Beginning which is the ¼ Sec Corner between Sec 27 & 28. from which a Pine Tree 24 inches Diameter Bears S 75° E 283 links Diameter a Pine Tree 10 " " " S 64° W 94 " "

J.W. Kimbrell Dep.t Co Surveyor

Surveyed for P. M. Coffin July the 6th 1887

by J.W. Kimbrell Dep.t Co Surveyor Plat No. 8

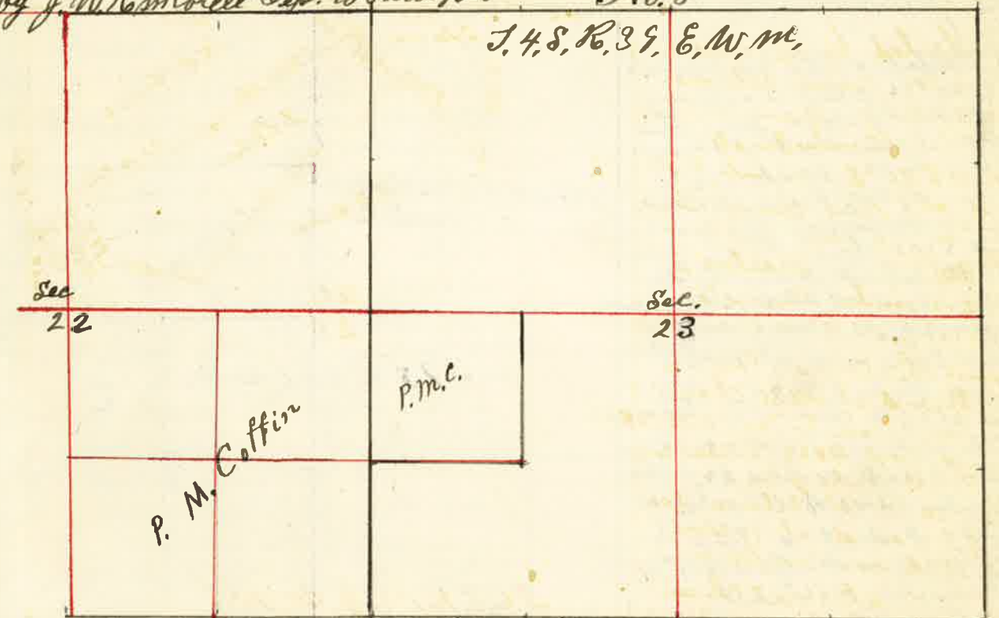

I Started at the ¼ Sec corner from which I run West Var 20° 15' E at 20 Chains Set Post for Temporary ⅛ corner at 40 Chains Set Stake for Temporary Center at 8350 Chains the ¼ Sec. corner on the West Side of Sec 22. I Then Started at ¼ Sec corner on North Side of Sec 22 from which I run South Var 20° E at 4185 Chains I intersect the random line East ⅛ West 100 links West of first Stake in Center and at 8185 Chains the ¼ Sec corner on South Side of Sec 22 from which I run North on line line and at 40 Chains Planted a Stone and Built Mound of Stone for center of Sec 22 from which I run East and at 2060 chains Planted a Stake in Mound of Stone for ⅛ corner. I Started at the ¼ Sec Corner on South Side of Sec 22 Thence East at 20 Chains Set Stake for Temporary ⅛ Corner and at 4136 Chains the Sec corner to Sec 22-23-26 & 27 from which I run West and at 2060 Chains Drove Stake and built Mound of Stone for ⅛ Corner from which I run North at 1987 Chains Drove Stake and built mound of Stone for ⅛ Corner in Center of S.E. ¼ Sec. 22. I Then Started at S West Corner of Sec 23 thence North at 20 Chains Set Stake for Temporary ⅛ Corner and at 3950 Chains the ¼ Sec Corner on West Side of Sec 23 from which I run South Var 15° E and at 1975 built Mound of Stone for ⅛ Corner Thence East 20 Chains Built Mound of Stone for ⅛ Corner for Center of S W ¼ Sec 23 thence North 20 Chains and built mound of Stone for ⅛ Corner thence West 20 Chains to ¼ Sec. Corner on West Side of Sec 23

J.W. Kimbrell Dep.t Co Surveyor