

LANDS OF ALTON WHITE



GREEN MEADOWS

INITIAL POINT
R. 7.63344
T. 42°43'55" S. 172°32'01" W. 1728.32
D. 0.045' A. 19°53'07"
PCS 20
315.00 SPIRAL S. 172°32'01" W. 1728.32
RT. 20
+50.30

NORTH LINE OF SECTION 34
GATEWAY AVE
DUE EAST 1299.32

Portion of BRIDLE DRIVE to be VACATED

LANDS OF MORTON ELDER

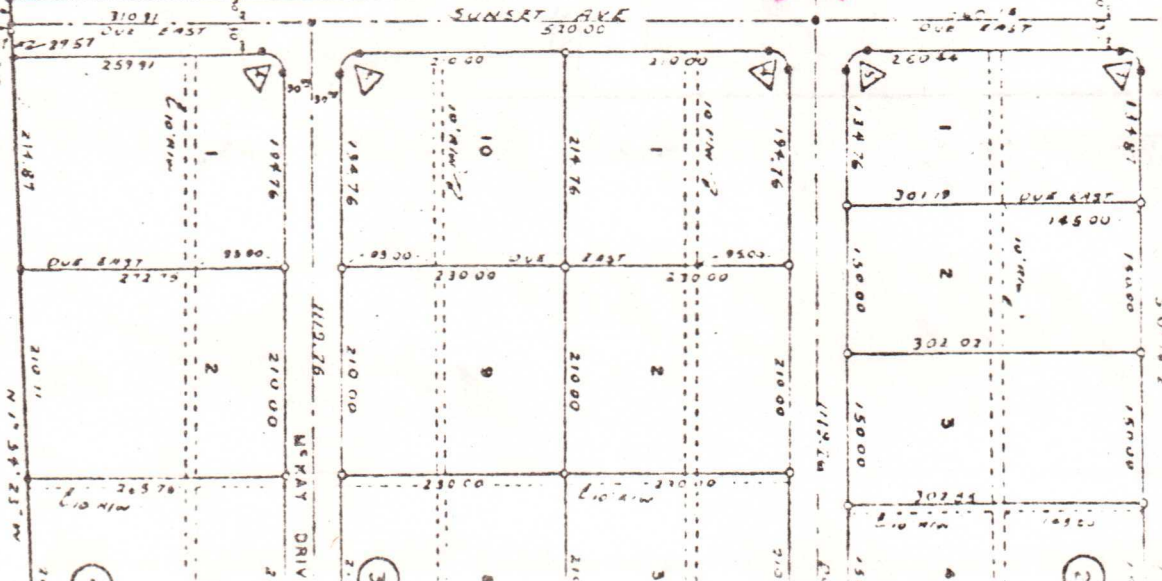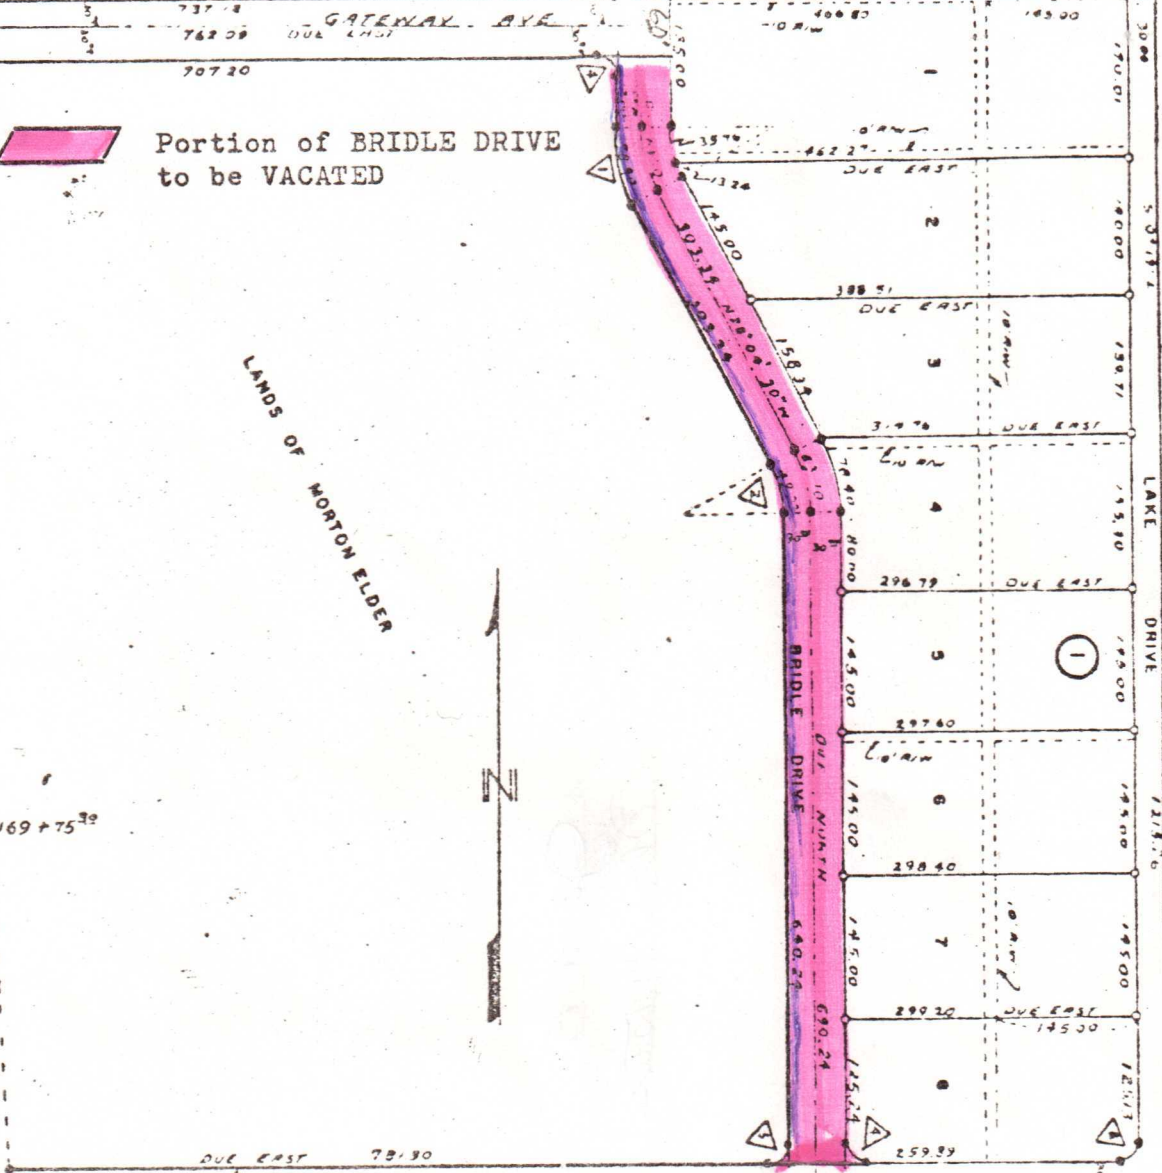

CENTER OF EXISTING AVE

U.S. HIGHWAY