Form 2085

B-19-2

13

Scale 400 ft. 1 Inch

N. P. Ry.

Wallula to Pendleton *Right of Way Plat*

State of Washington Oregon *County of* Walla Walla Umatilla

Section 14 *Township* 6 North *Range* 32 East *of* Willamette *Meridian*

NOV 1 1960

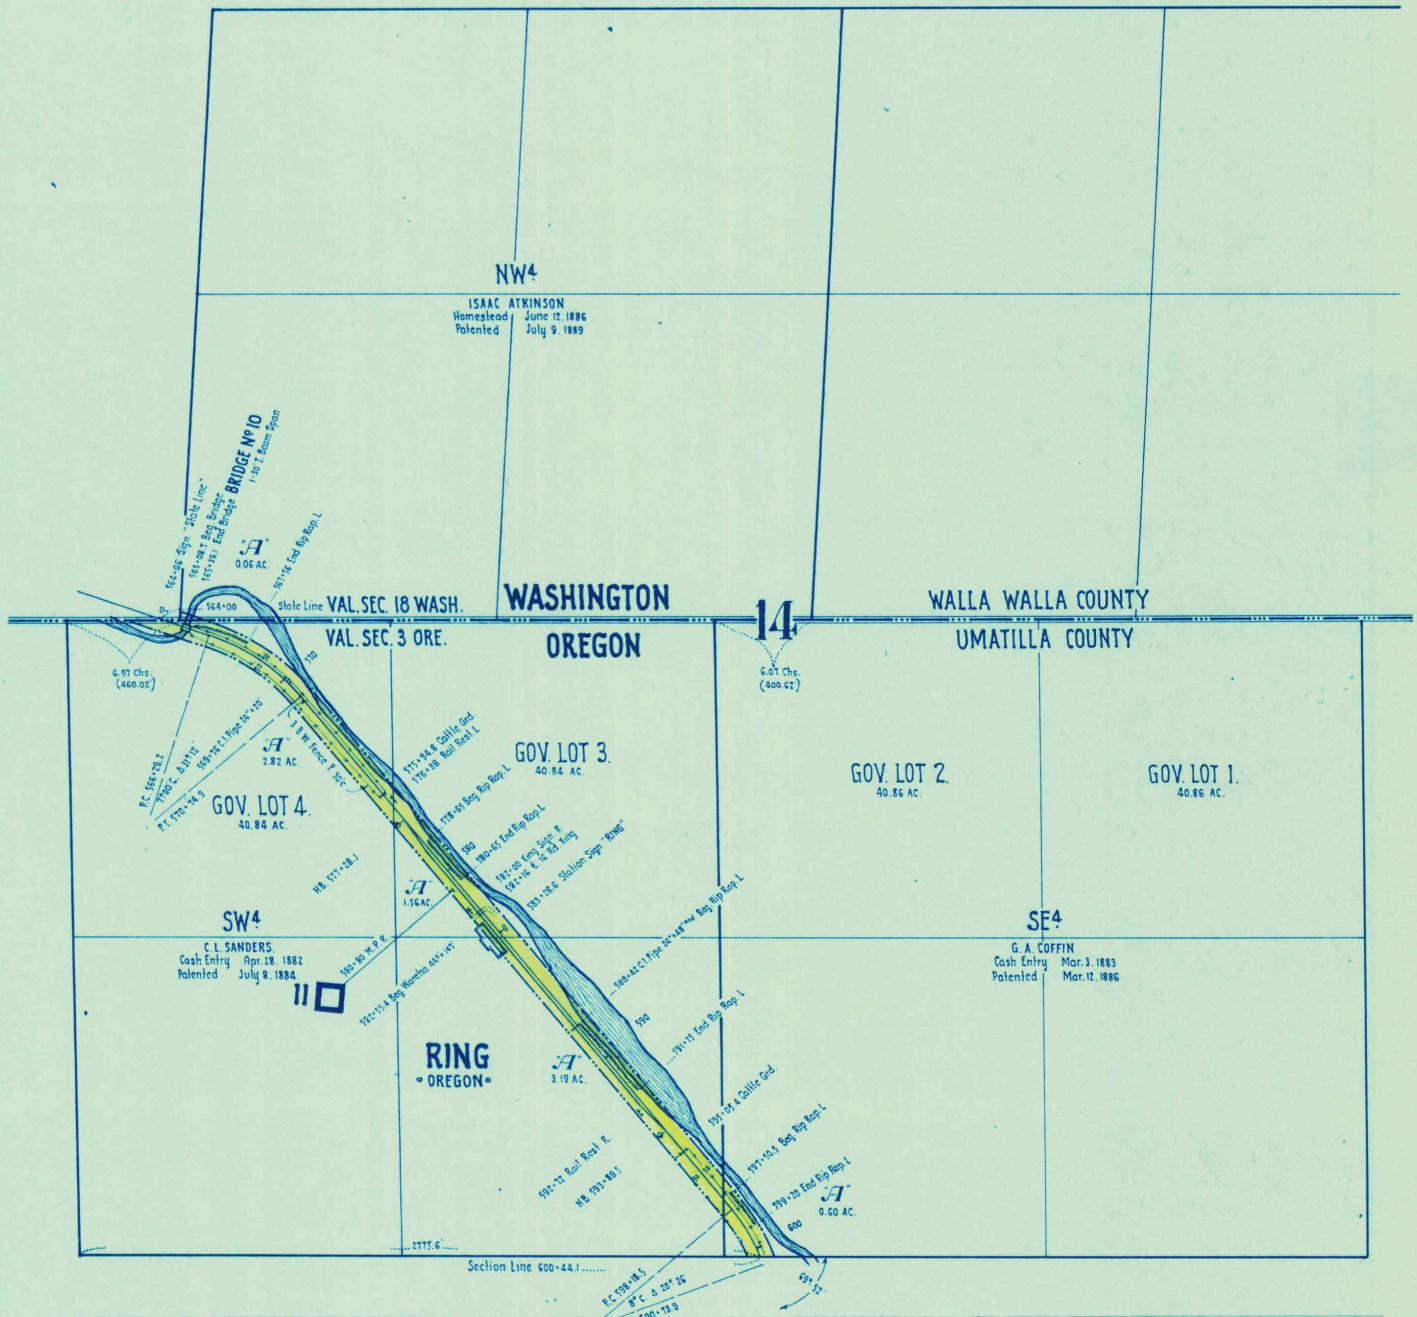

	W. No.	Deed No.	Grantor	Grantee	Title	Acres	Date	Recorded	Brief Description	Cor. File	R/W Memo.
A									100 ft. Right of Way across Section 14 is claimed and has been acquired by Adverse Possession except portions occupied by elevators Ench. Files No 926 & 927		199/08
B											
C											
D											
E											
F											
G											
H											
I											
J											
K											
L											
M											