


SCHEDULE OF PROPERTY									
NUMBERS	GRANTED	GRANTEE	INSTRUMENT	DATE OF	RECORD	AREA	REMARKS		
TRACED	BY			RECORD	DATE				
101									
102									
SCHEDULE OF PROPERTY									
NUMBERS	GRANTED	GRANTEE	INSTRUMENT	DATE OF	RECORD	AREA	REMARKS		
TRACED	BY			RECORD	DATE				
101									
102									
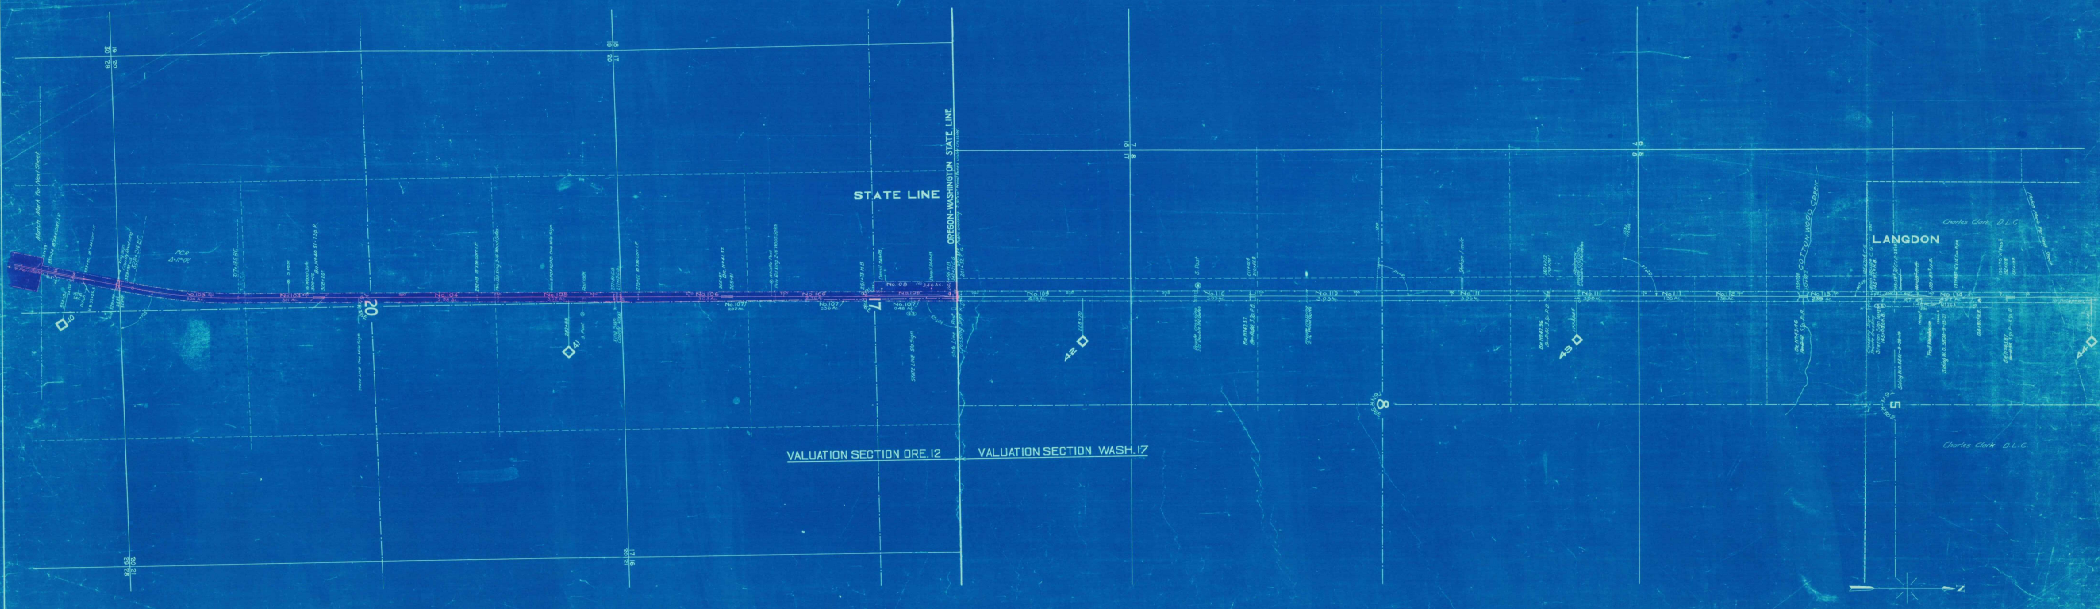

RIGHT-OF-WAY AND TRACK MAP
 OREGON-WASHINGTON RAILROAD & NAVIGATION COMPANY
 BRANCH LINE TUCACONN
 PENDLETON TO GRANGE CITY JCT.

SCALE: 1" = 800 FT.
 DATE: 10-19-14
 OFFICE OF LAND ENGINEER

