




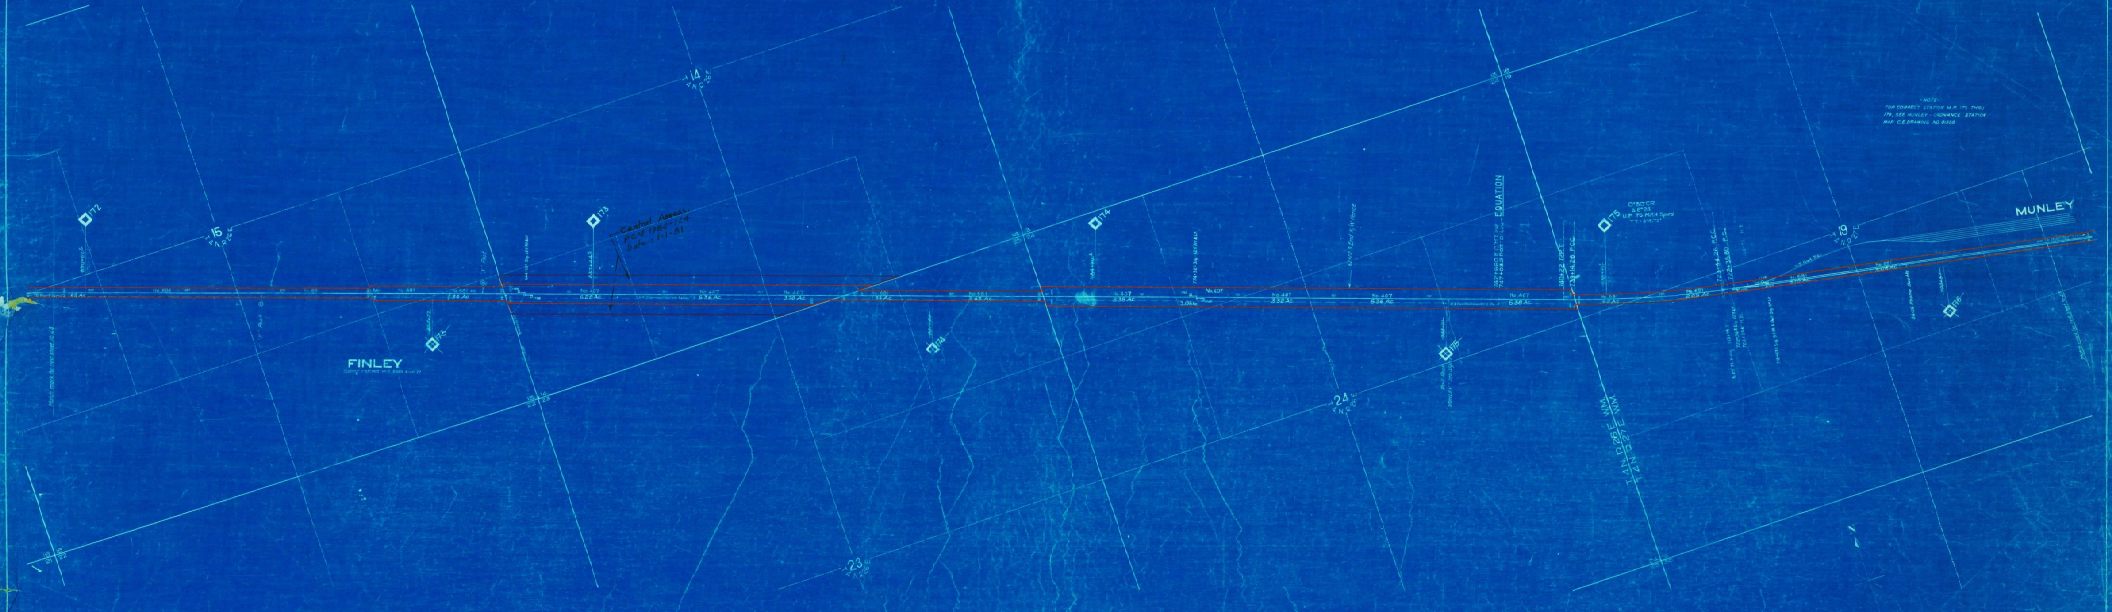


RIGHT-OF-WAY AND TRACK MAP
 OREGON-WASHINGTON RAILROAD & NAVIGATION COMPANY

MAIN LINE - MESSNER TO HINKLE

