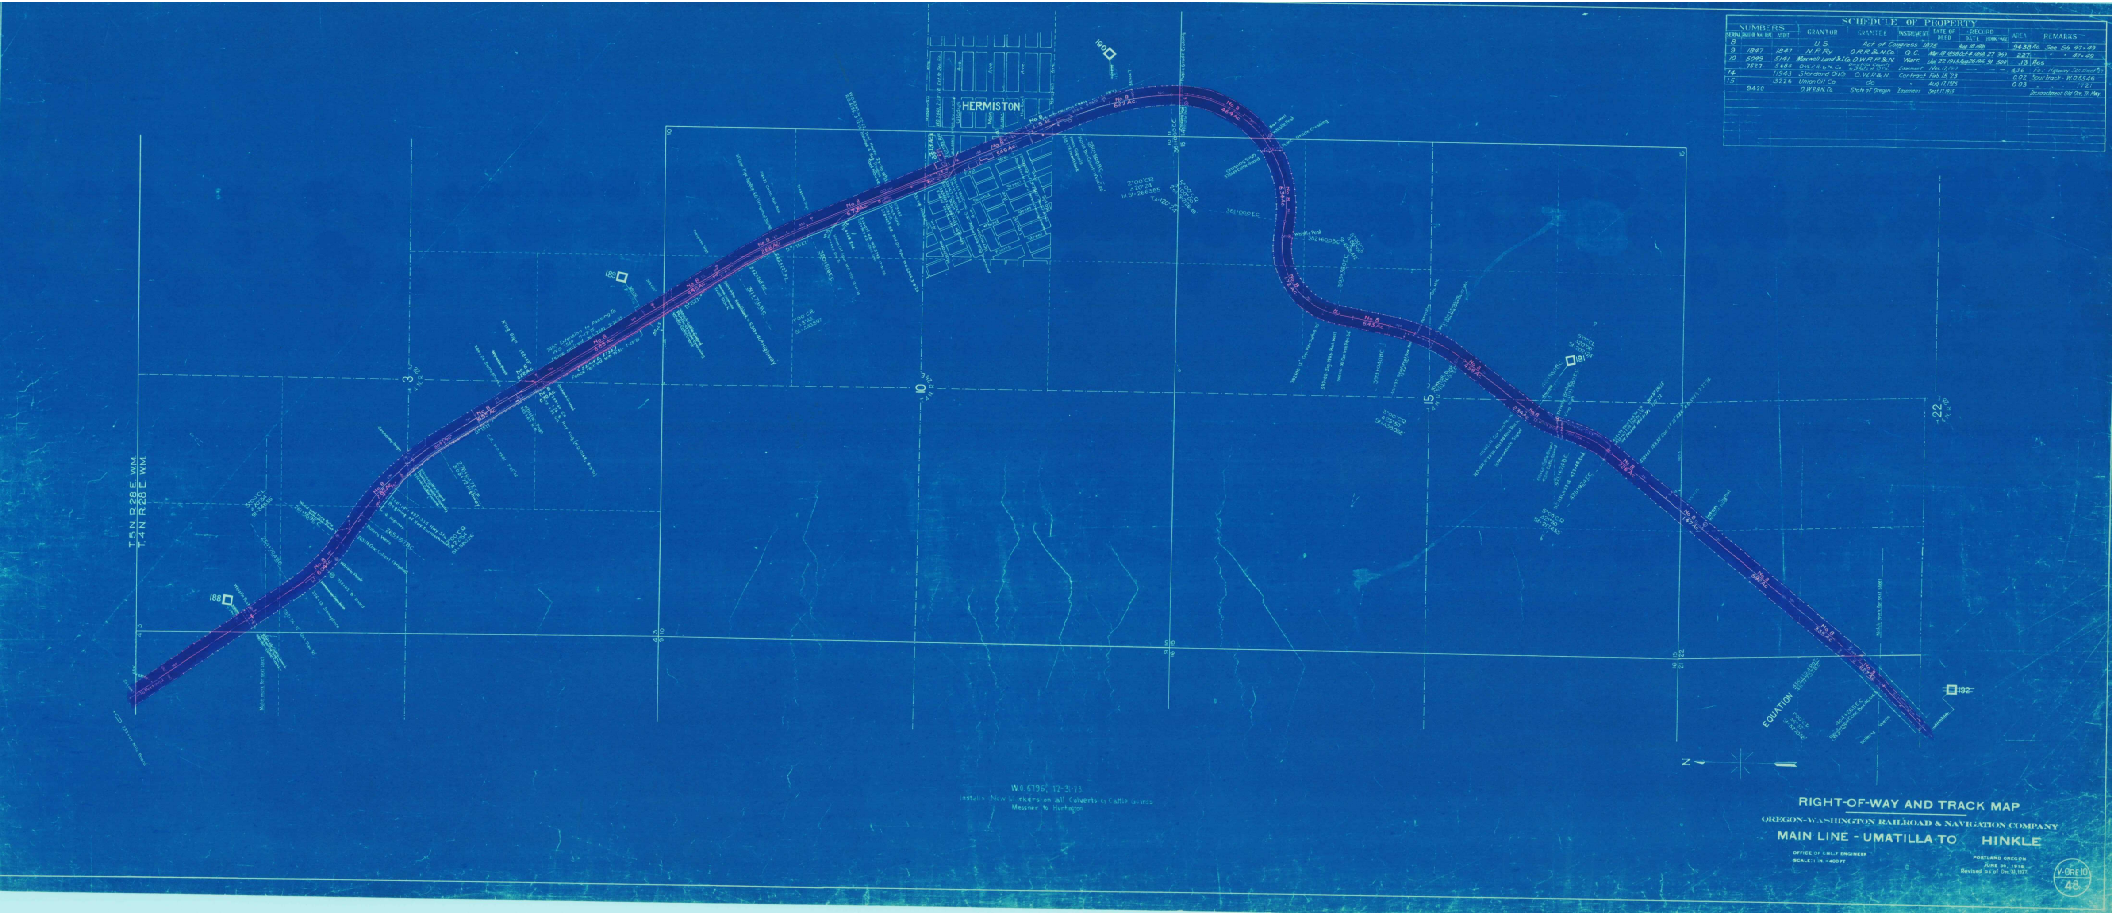
HERMITON
T5N R28E WM
T4N R28E WM
SCHEDULE OF PROPERTY
RIGHT-OF-WAY AND TRACK MAP
OREGON-WASHINGTON RAILROAD & NAVIGATION COMPANY
MAIN LINE - UMATILLA TO HINKLE
OFFICE OF CHIEF ENGINEER
PORTLAND OREGON
JUNE 14, 1918
Revised to 1st Dec 31 1921
V-OR&N 10
42