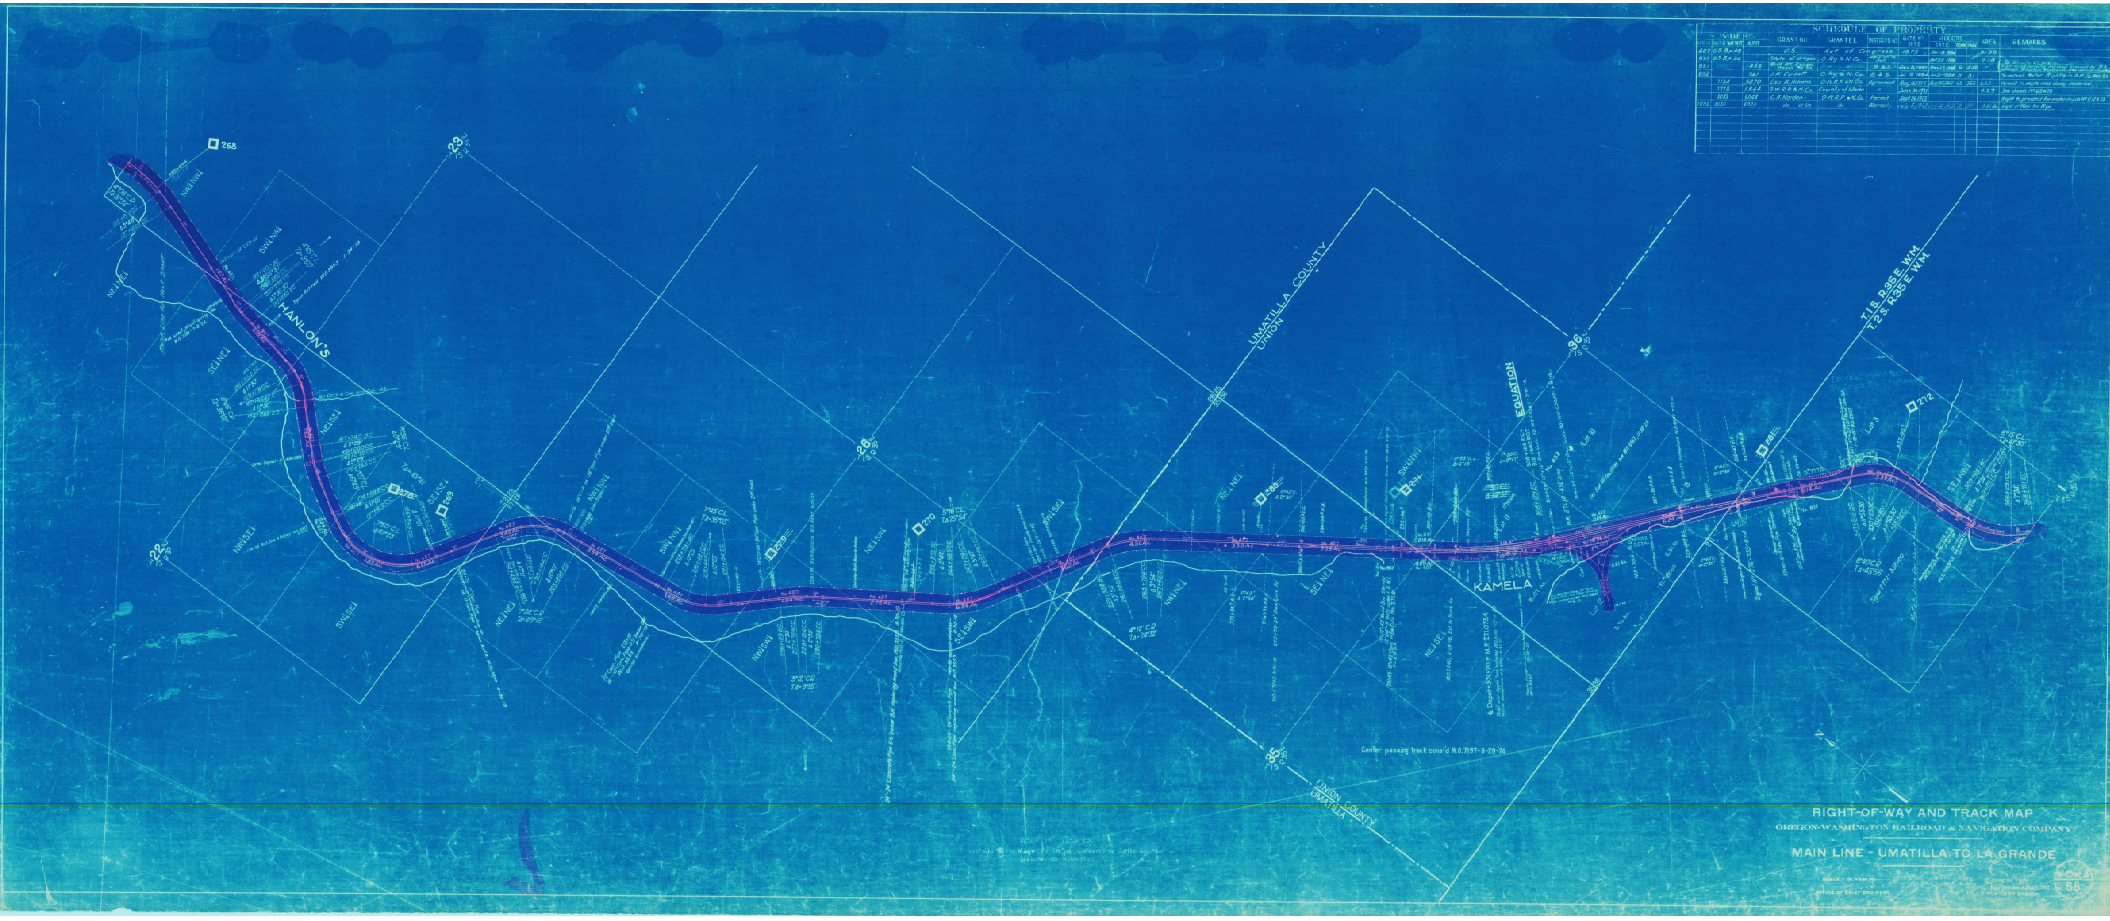
SCHEDULE OF PROPERTY
HANLON'S
UMATILLA COUNTY
UNION
KAMELA
T.1S. R.35E W.M.
T.2S. R.35E W.M.
Center passing track const'd W.O. 7191-3-29-26
RIGHT-OF-WAY AND TRACK MAP
OREGON-WASHINGTON RAILROAD & NAVIGATION COMPANY
MAIN LINE - UMATILLA TO LA GRANDE