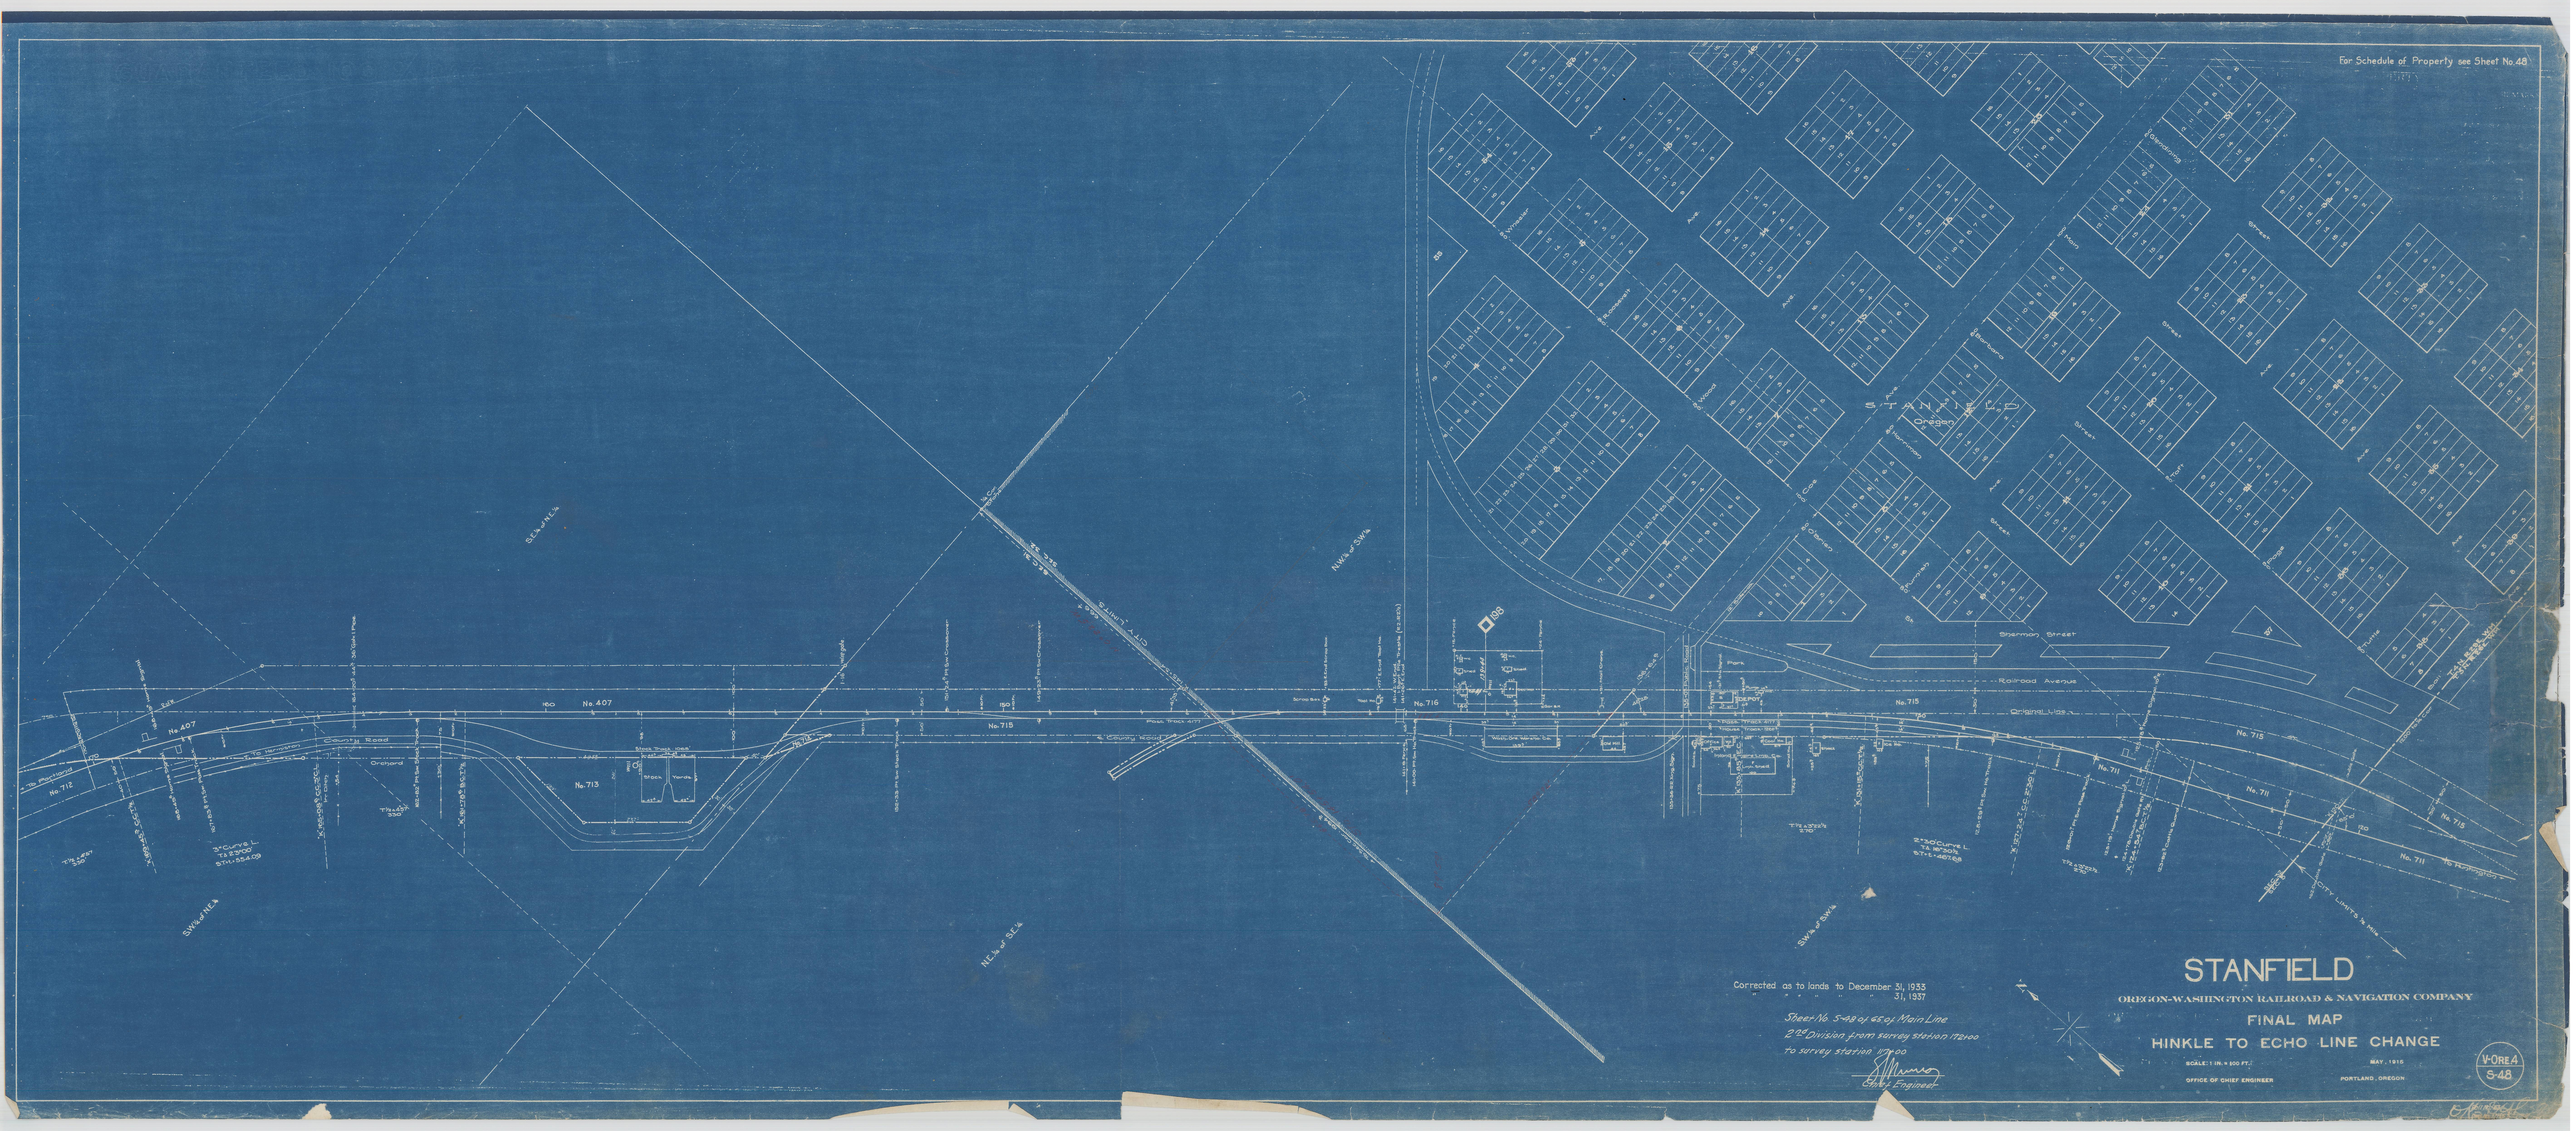
For Schedule of Property see Sheet No.48
STANFIELD
Oregon
Railroad Avenue
Original Line
Sherman Street
No. 407
No. 712
No. 713
No. 715
No. 716
No. 711
No. 698
S.E.¼ of N.E.¼
N.W.¼ of S.W.¼
S.W.¼ of N.E.¼
N.E.¼ of S.E.¼
S.W.¼ of S.W.¼
3° Curve L
T.A. 1°30'
Ext. 330
3° Curve L
T.A. 30°00'
Ext. 554.09
2°30' Curve L
T.A. 30°00'
Ext. 467.65
Corrected as to lands to December 31, 1933
" " " " " 31, 1937
Sheet No. S-48 of 65 of Main Line
2nd Division from survey station 1700
to survey station 17+00
Chief Engineer
STANFIELD
OREGON-WASHINGTON RAILROAD & NAVIGATION COMPANY
FINAL MAP
HINKLE TO ECHO LINE CHANGE
SCALE: 1 IN. = 200 FT.
MAY, 1915
OFFICE OF CHIEF ENGINEER
PORTLAND, OREGON
V-ORE A
S-48