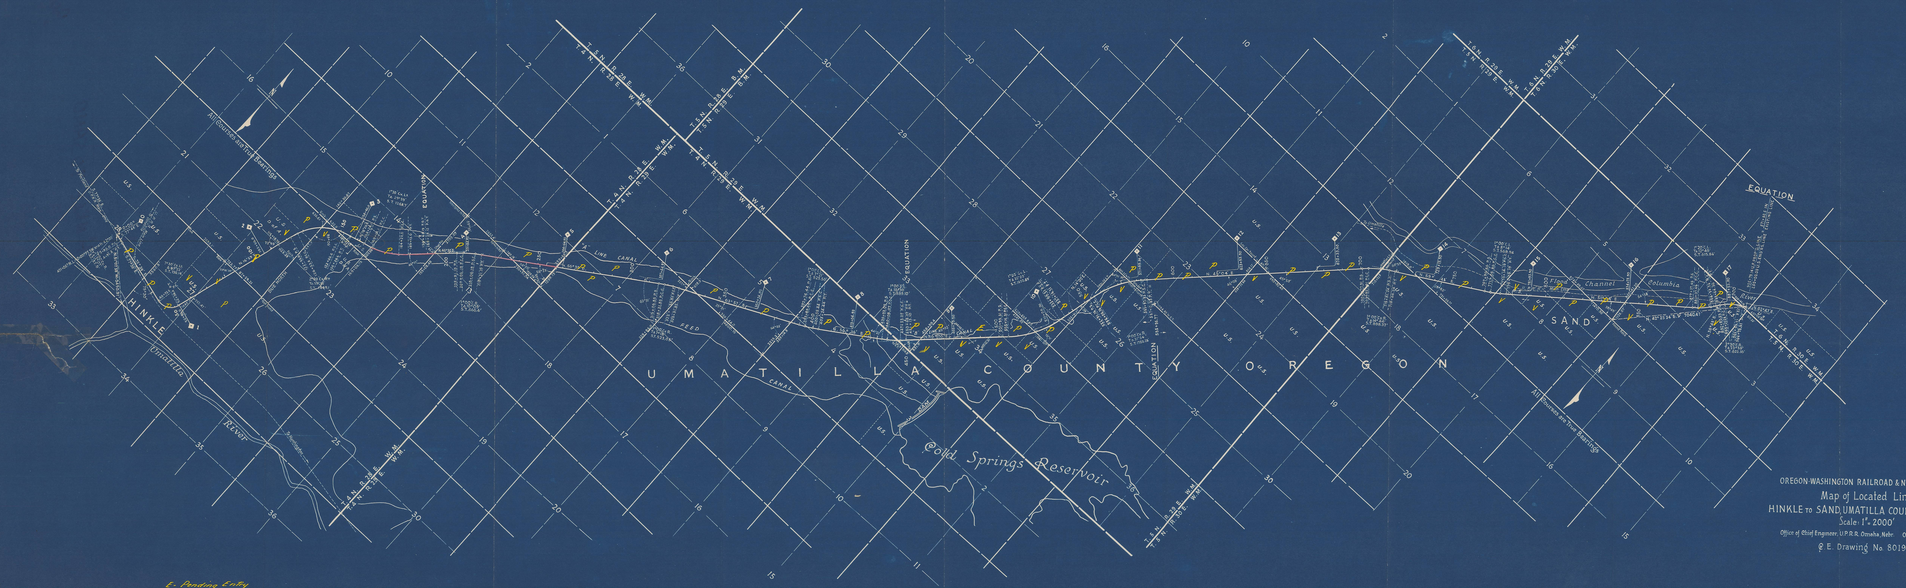
HINKLE
SAND
UMATILLA COUNTY OREGON
Old Springs Reservoir
Umatilla River
Columbia River
Columbia River Channel
EQUATION
Oregon-Washington Railroad
T 4 N R 26 E W.M.
