


Box "BB"

Sec. 18

Sec. 19

NW 1/4 NE 1/4 NW 1/4
Sec. 19 T.4N. R.35E



COUNTY ROAD

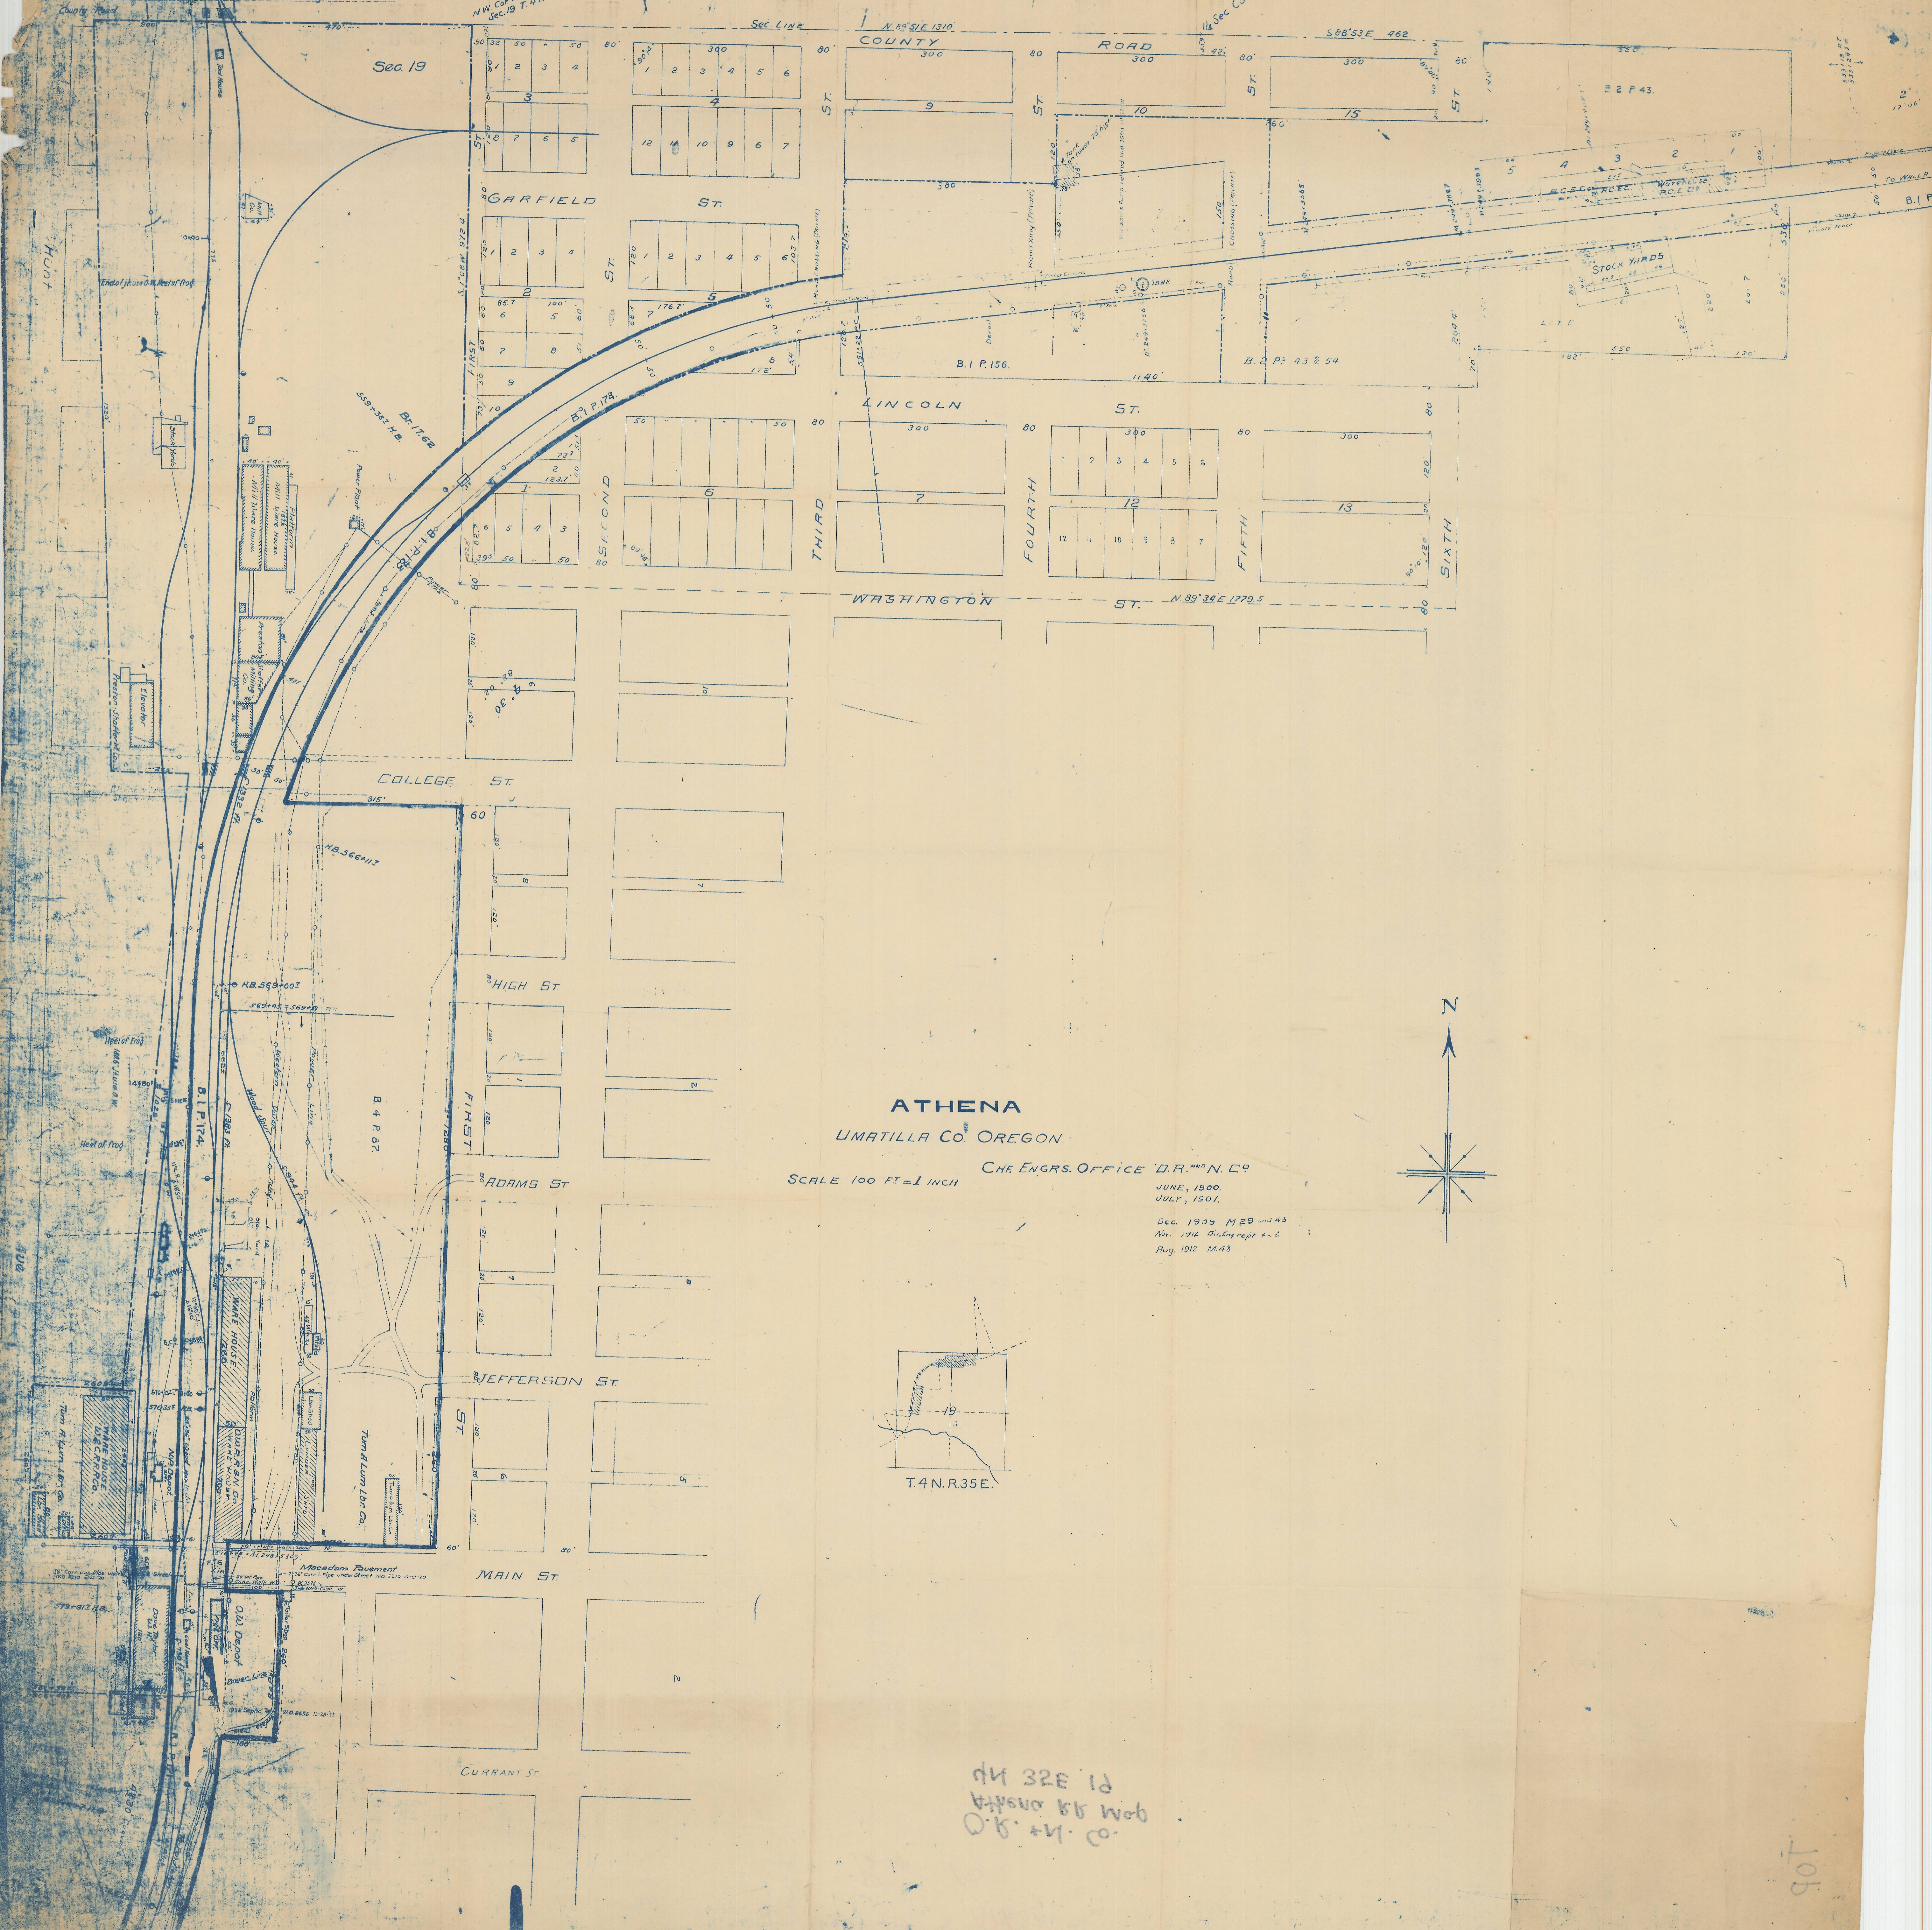

ATHENA
UMATILLA CO. OREGON

SCALE 100 FT = 1 INCH

JUNE, 1900.
JULY, 1901.
Dec. 1909 M 29
Nov. 1911 Dickings # 2
Aug. 1912 M 48

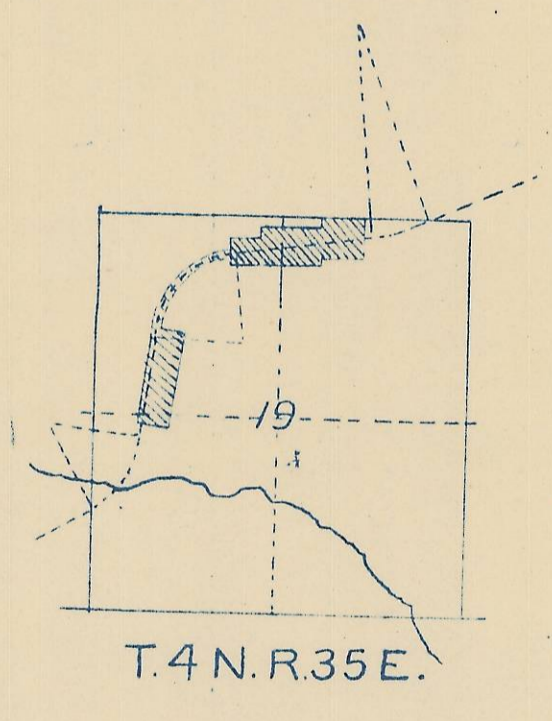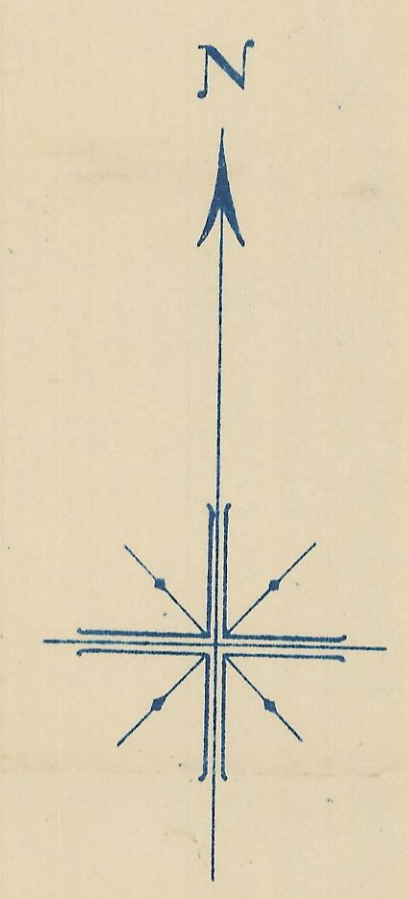


106