


Township No. 2^d N.

Range No. 36 E

Meridian in

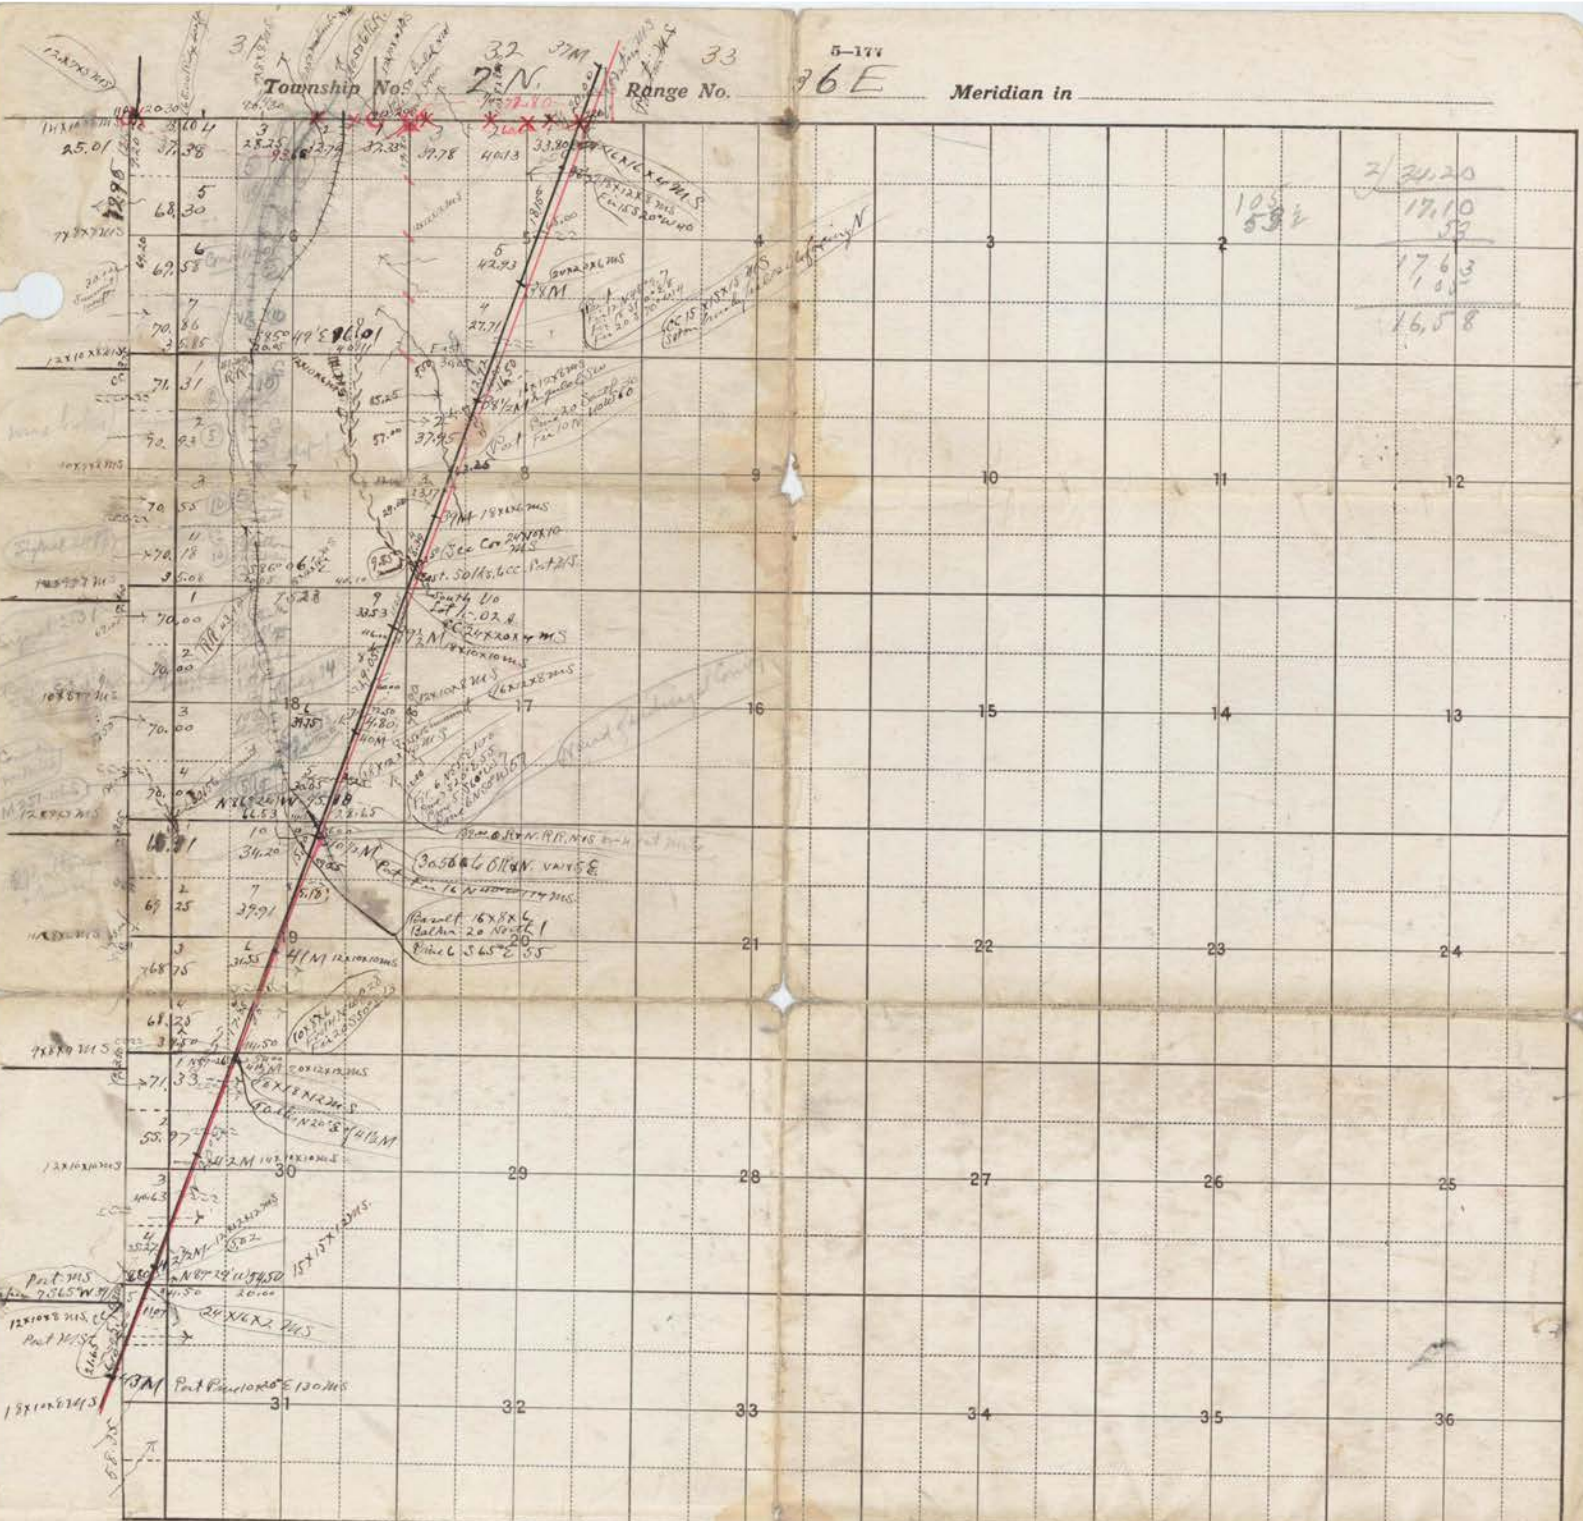

2/20.20
17.10
59
17.63
16.58

N 85° 26' W 1/4 Sec 18 + 18
 28.65 Run by Sub. Sta. 10 x 12 x 20 x 14 S
 30.56 O.P.N. P.P. N.W. 1/4 Sec
 40.07 Sta. 12 x 8 x 6 Poin. 6.565 S.S.
 43.05 Meacham Crk. N.
 80.15 Summit + 800 ft.
 95.18 Crk. 180 ft.
 North of 17 + 18
 78.96 Run by 1000 ch. N 20° E of 39 1/2 M
 East of 8 + 17
 050 Run by 1125 N 20° E of 39 1/2 M

S 85° 06' E of 7 + 18
 30.06 Crk. bottom
 41.60 Meacham Cr.
 43.10 O.P.N. P.P. N.S. sec.
 55.13 Set at 1125 x 12 x 10 ft. N.S.
 95.28 Crk. 2.8 x 170 ft.
 Part of 5 + 8
 550 Camp N 60-100 ft. arc
 7800 Ridge N.W. + 15 ft.
 30.05 Run by 1100 N 20° E of 39 1/2 M