


11

$$\begin{array}{r} 40.32 \\ 39.34 \\ \hline 79.76 \end{array}$$

$$\begin{array}{r} 39.92 \\ 39.34 \\ \hline .58 \\ .20 \end{array}$$

41  
1.3

Sec. 26 T. 1 N R. 33 E

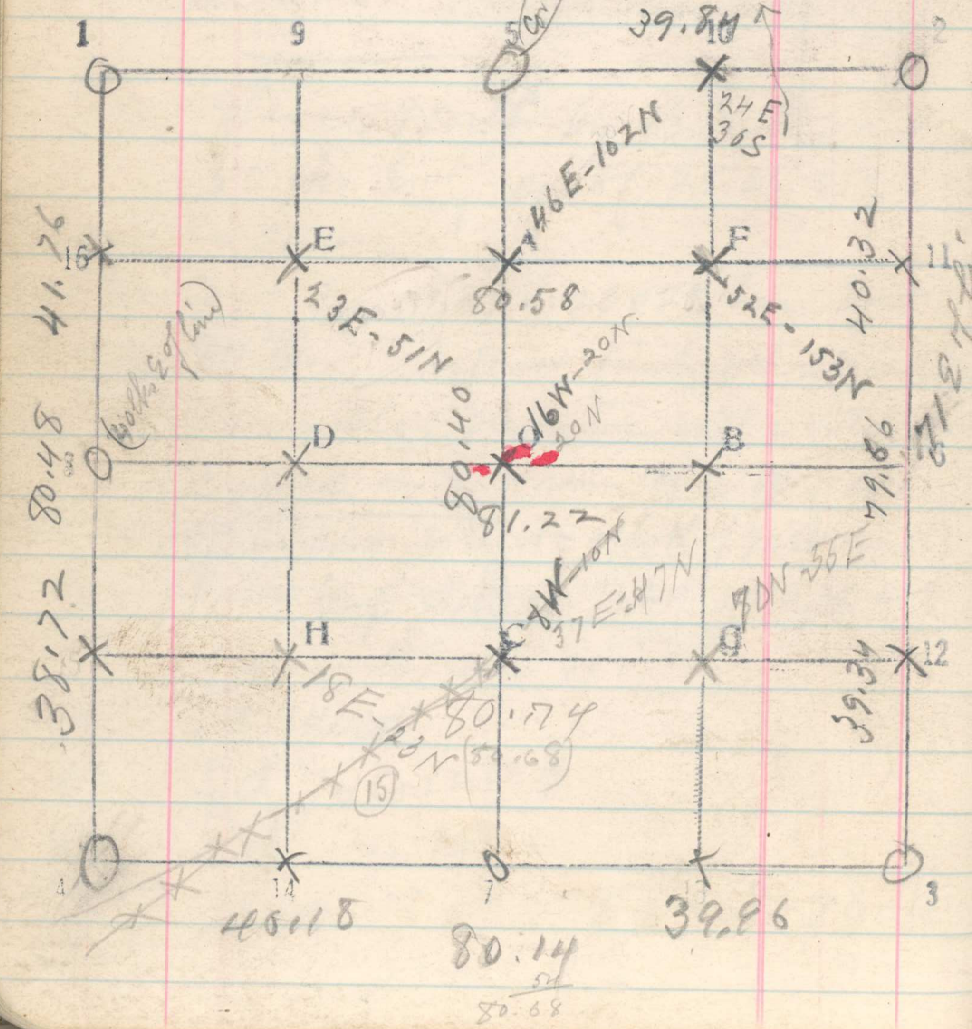

From pt. 16 lbs N + 16 lbs W of 107

From ~~top~~ cor of 25 26, 35 & 36 run West

20 Set  $\frac{1}{16}$  cor.  
 39.68  $\frac{1}{4}$  cor bet 26 & 35, a stone ~~MS~~  
 $+ .18$   
 39.84 well marked in remains of MS  
 bears S. 44 lbs.  
 Raise MS N of cor  
 12-20-17

Line 16-17

Set 20.40 & 60

4047 Motomies fence NRS  
 80.58 Cor. 11-S. 26 bears N. 204 lbs.

Line 6-8

Set 20.40 & 60

4056 Set O, under Motomies fence  
 81.22  $\frac{1}{4}$  cor bears S. lb  
 April 2, 1919

Line 16-12

Set 20.40 & 60

40.54 Set C on line with Motomies fence N.  
 80.74 12-S. 26 bears N. 94 lbs  
 April 14, 1919