


27

SSI

Sec. 11 T. 1N R. 33E

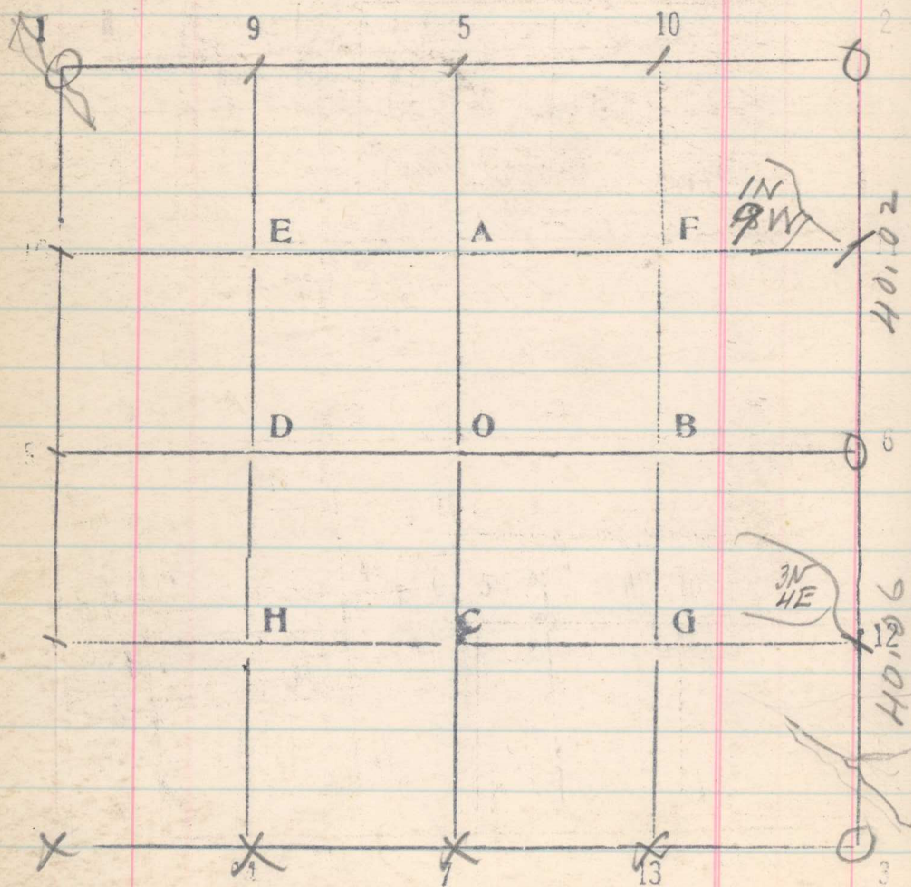

123

N. bet 11+12

20 Set $\frac{1}{16}$ cor40.06 $\frac{1}{4}$ cor bears E. 8 lks. stone in M.S., but lying on ground.

Set stone in ground in M.S. & raise M.S. W. of cor

Presence North by B S, on sec cor

20 Set $\frac{1}{16}$ cor.40.02 Cor of 2, 3, 10+11 bears W. 18 lks.
1-5-18