


Sec. 11 T. 2 N R. 34 E

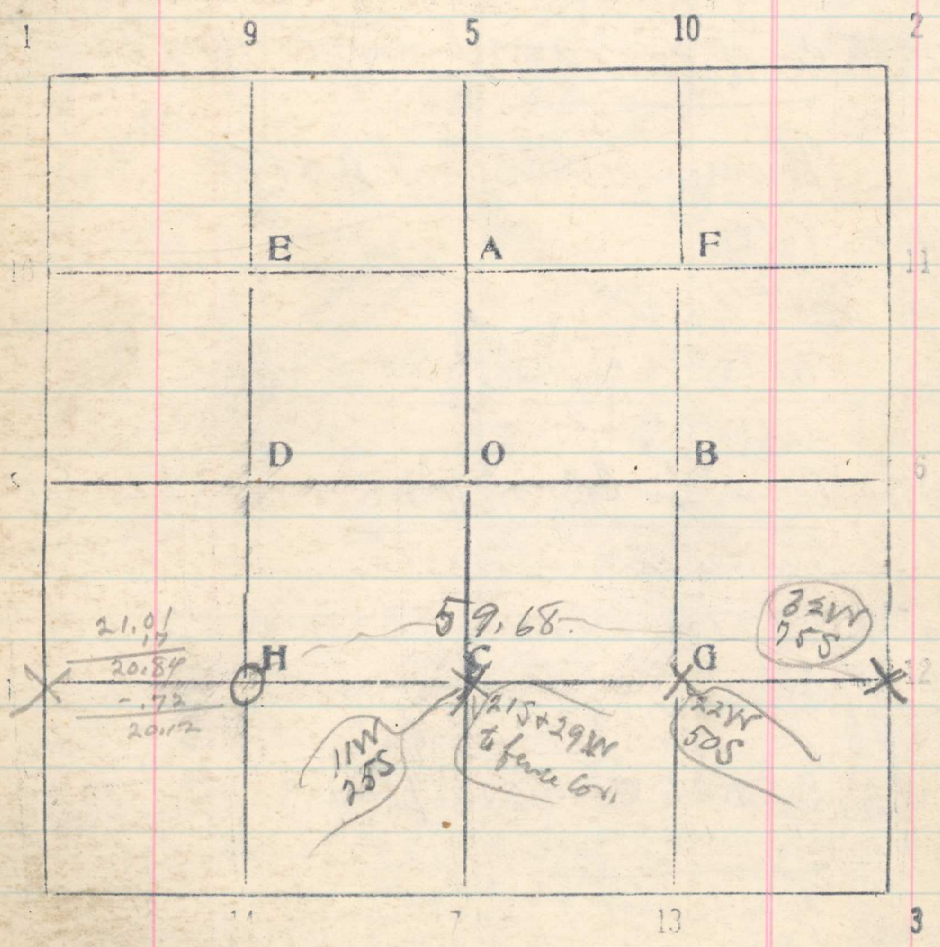

From H - Sec 11 run East
 20 Set 1/16 cor at C - S. 11 Fence corner 29 W + 21 S
 40 Set 1/16 cor at G - S. 11
 40.30 MS beam N 97 lbs No mark 187