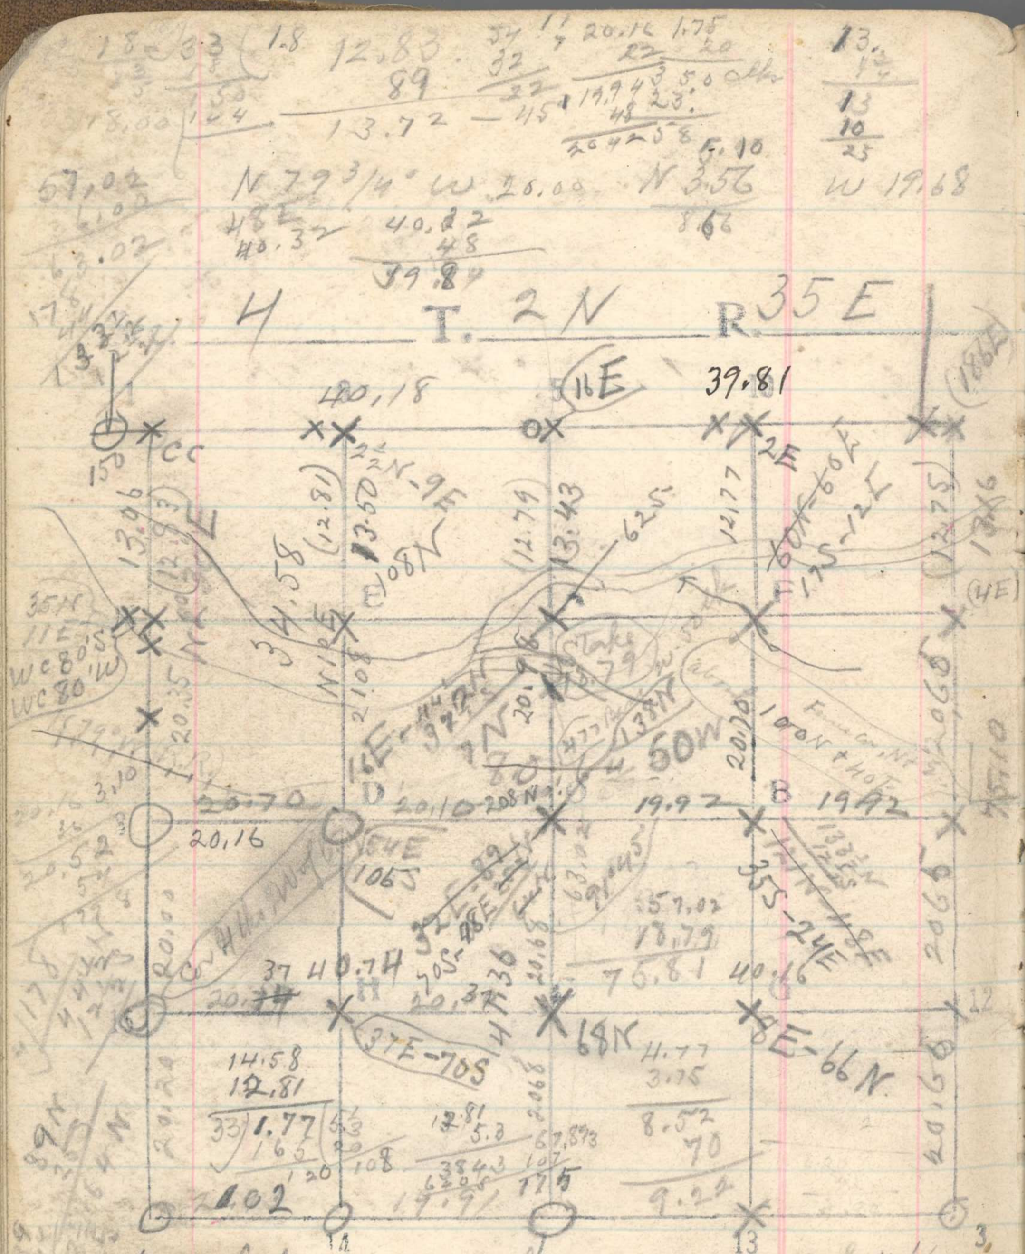

1/4 corbet 4 & 5 is a stone 18 x 12 x 7 mkd 1/4 in Md Stone

Cottonwood 10 S 10° E 28 mkd 1/4 S 15

Cottonwood 14 S 41° W 107 mkd 1/4

From 1/4 corbet 4 & 5 run N

3.10. RR N 79° W

10. Set 1/64 cor

20.35 Set 1/16 cor on bar in Umatilla River

Set. 1 W.C. 1/16 cor. 80 ft. S. & 80 ft. W.

(32.83)

33.41 C C of secs. 4 & 5 bears East. 18 lks.

Error .58

.20

.78

From 50 lks N of 8-S-4 run East

(S 27° E 118 lks) 104 S 54 E

20.1 ~~Set D-S-4~~ Point for old 1/16 cor

20.70 ~~Thence~~ remains of M.S. bears S 104

20.42 Set D-S-4 from corrected D-S-4

Thence E. 70 lks. Fence N & S

~~60~~ Set B-S-4

~~60.48~~ Fence. E & W.

39.84 ~~80.64~~ 1/4 corbet 3 & 4 bears N 178 lks.

From B-S-4 run N.

20.70 Set F-S-4

~~33.73~~ 1/16 cor at 10-S-4 bears E. 97 1/2 lks

7.35

34.08

(12.77) From D-S-4 run N.

20.70

20.42

39.84

80.96

26.08 Set 1/16 cor at E-S-4

(32.81)

34.58 Intersect 9-S-4

From 15-S-4 run East

20.92 Bradley's 1/16 cor bears S. 94 lks.

40.74 C-S-4 bears S. 140 lks.

From C-S-4 run East

20 Set 12-S-4 bears N. 132 lks

40.16