


Sec. 5 T. 2 N R. 35 E

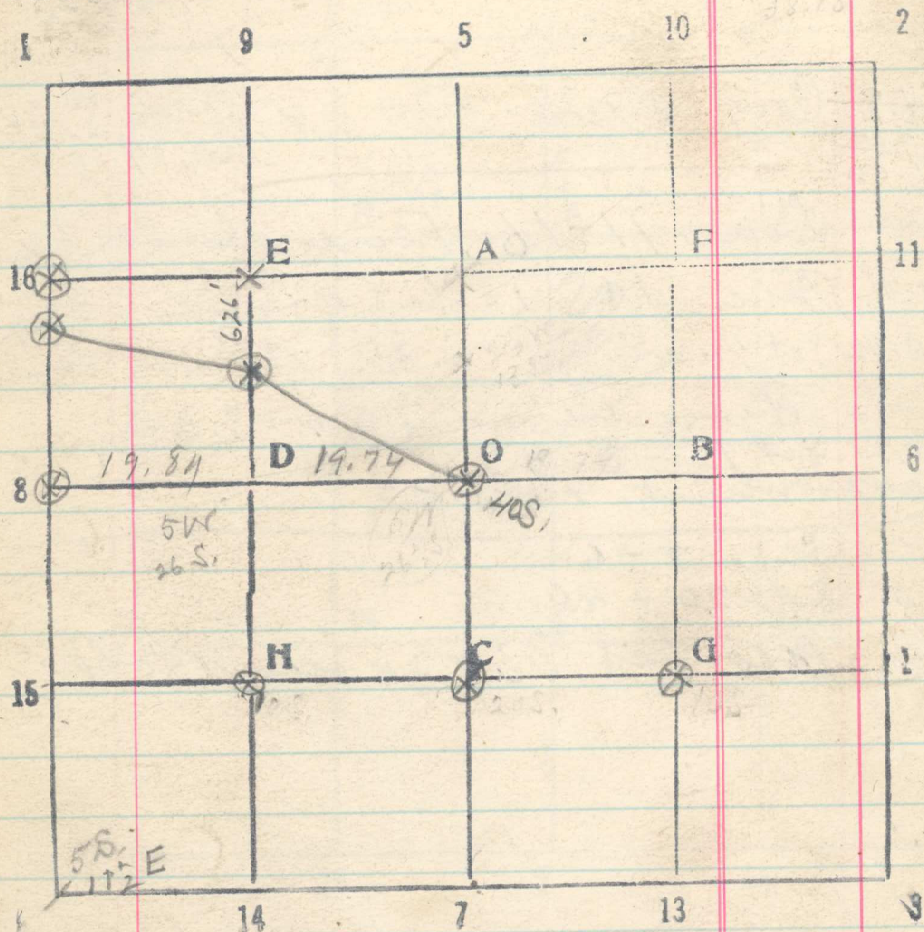

From A - S. 5 run South,
Set cor bet.


20 Set temp stake.
Thence East

19.74 O - S. 5 bears N. 13 lks

Sec. 27 - 3 - 35

277.28
38.64
64
39.18
11.04
40.12

S - 3.72
E - 32.95
1.65

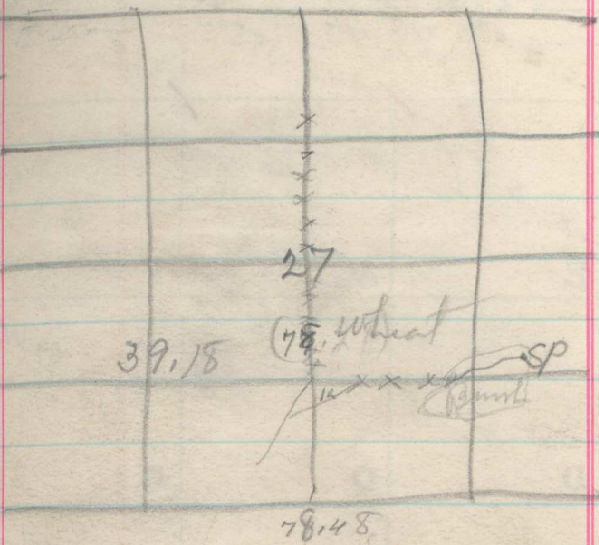

Line 15 - 12, through wheat field
39.18 On line with fence to N. and
ridge indicating Bd fence line
to E. Set C - S. 27.
Thence East on same line

17.80 Creek, S 60° W

19.59 Set G - S. 27

Intersect 12 - S. 27 June 12, 1919