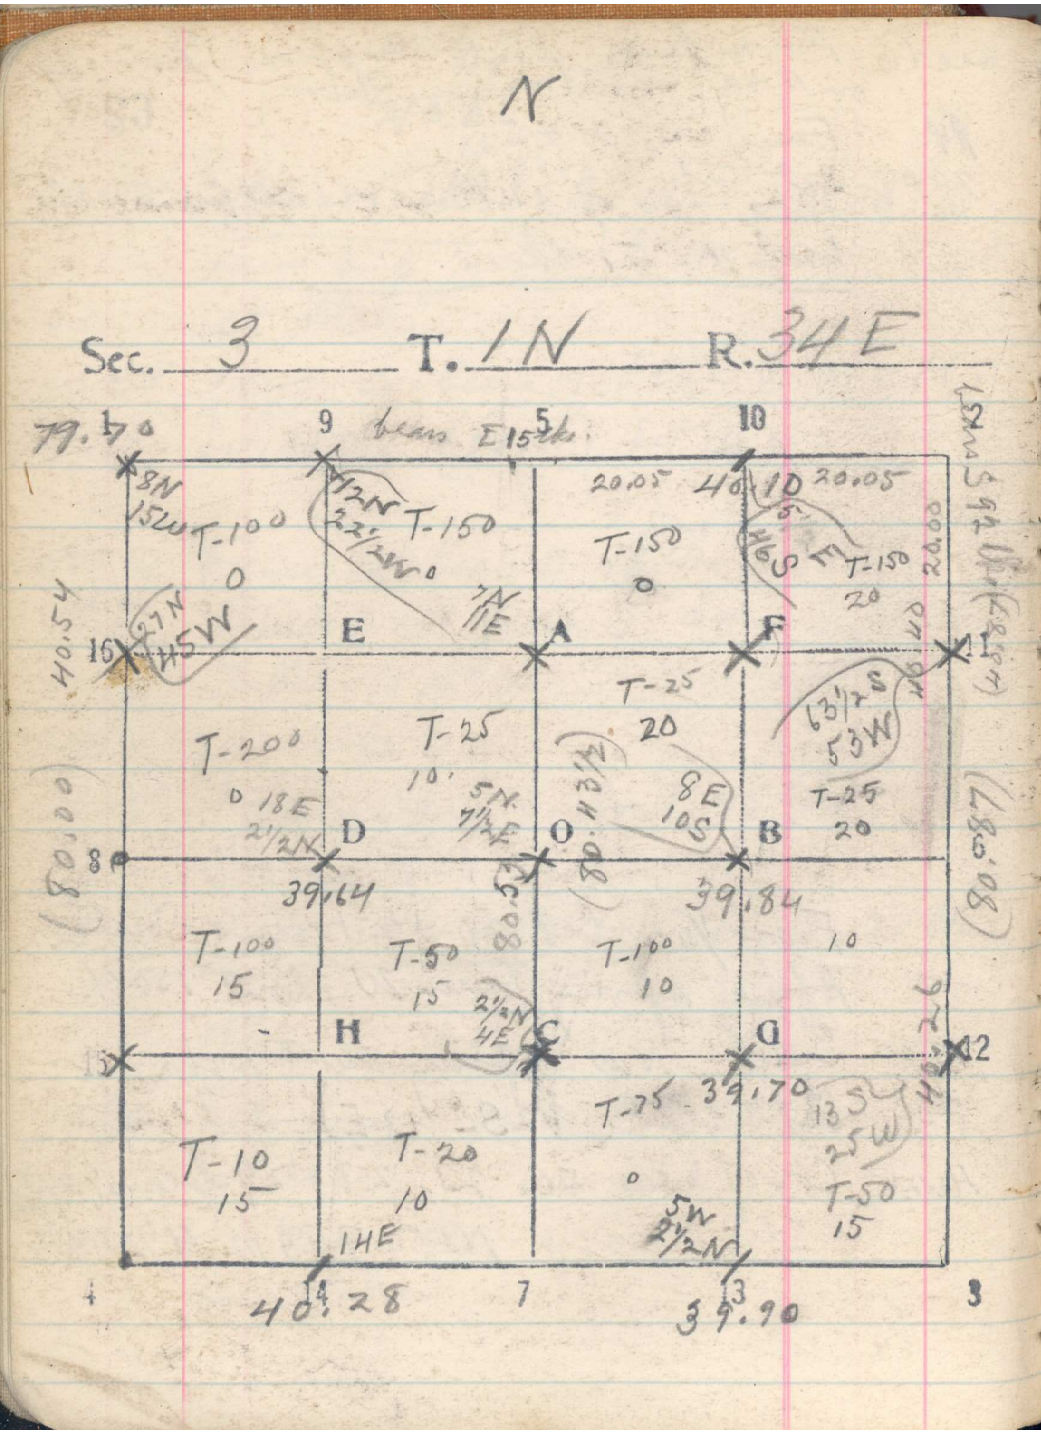

87 S
23½ N
63½ S

63 8

From 1/4 cor bet secs 30 & 31 run N

20 Set stake

1

40 Set stake

60 Set stake

88.10 1/4 cor on N bdy Sec 3 bears E 15 lks

From 1/4 cor on N bdy Sec 3 run East

20 Set stake

40.12 Cor of 2.3.34 & 35 bears S. 92 lks

From Cor of 2.3.34 & 35 on N bdy run S

~~80.00~~ (20.87) ~~Set stake~~

40.40 (40.87) 1/4 cor bet secs 34 & 3 bears W. 106 lks.

Thence West

20 Set stake

39.84 O-S-3 bears S. 20 lks

Nov 9, 1917