


See Page 37

Cor of 317.32 falls in road  
46 ch. East of NWS fence, and  
20 lbs W + 3 lbs S of fence cor. NNE.

188  
273  
85

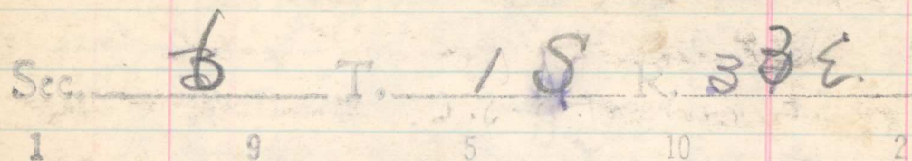

Jan. 3, 1917 From point 272 ch N. of 12-S. 6

run west 203

20.00 Set W.C. 1/16 188 lbs S. of offset line  
on 80 ft N. of true pt. Polye cottonwood

20 min. diam. on N side, McKay Cr.

Also set W.C. 120 ft S. of true pt. on  
115 lbs S. of true pt.

Side of creek.

40. Set 1/16

60. Set 1/16

80. Set 1/16

100. Set 1/16

120. Set 1/16

151.34.00 Set 1/16 cor on W by Sec 6, bears N. 36 lbs.

Anderson  
Shipfentower

85  
Jan 5  
Shipfentower

Sec. 10

11.43 27.53 in 135.00  
5.23  
5.53 95 47

Dec 13

1917 From cor of secs 5, 6, 7 & 8 run West  
bet secs 6 & 7

20 Set 1/16 cor (10W-)

40.20 Intersect 1/4 cor. a fence post with  
an iron post mkd WC. 2 lbs N.

Thence <sup>continuing</sup> West on same line

20 Set 1/16 cor 6N-6W

40 Set 1/16 cor 12N-12W

60 Set 1/16 cor 18N-18W

80 Set 1/16 cor 24N-24W

95.02 C.C. of secs 6 & 7 bears N. 28 lbs.  
(94.76) This is an iron post.

Thence North

5.93 Intersect cor of secs. 10 & 12, an iron post

20 Set 1/16 cor (6 S 10 W) Base East 2.60 ch.  
+ 4.00 ch. + from 4.00 ch. flag on  
top of bluff bears N 150/35 W  
Dist 14.34 ch.

20.00  
(25.90)  
45.77

(then measure 11.43 ch.) 1/16 cor, an iron post  
bears West 22 lbs.