6

Sec. 22 T. 3 N R. 35 E

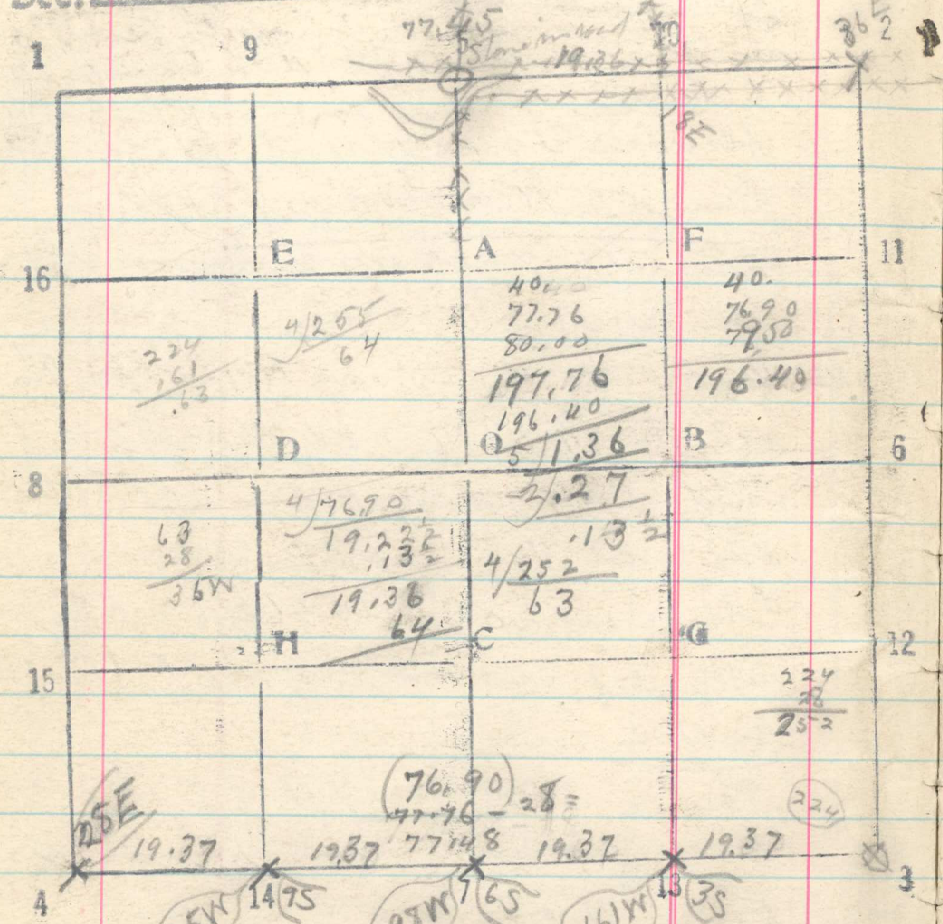

From 1/4 cor bet 15 + 22, a rock in middle of lance E + W + on line with fence to S and on line with division plowing to N run E

19.36 Agrees with old distance. On line with fence to N. No trace of old 1/16 cor

Thence East in lane on same line

19.36 No trace of cor of 14.15.22 + 23. Set stake 24 ft N + 24 ft S. under fence

Oct. 23, 1918

198

From temp cor of 21.22.27 + 28 run East

28 ~~36~~ On line with fence to N. + 56 lks. E of line with fence 1/4 mile S. running S.

19.37 ~~20.00~~ Set stake for 1/16

~~20.72 On line with fence to N on east side of lane~~

+19.37 ~~40.~~ Set 1/4 cor.

+19.37 Set 1/16 cor.

~~58.31 On line with fence to N~~

77.48 ~~76~~ Cor. of secs. 22.23.26 + 27