Sec. 31 T. 3N R. 36 E

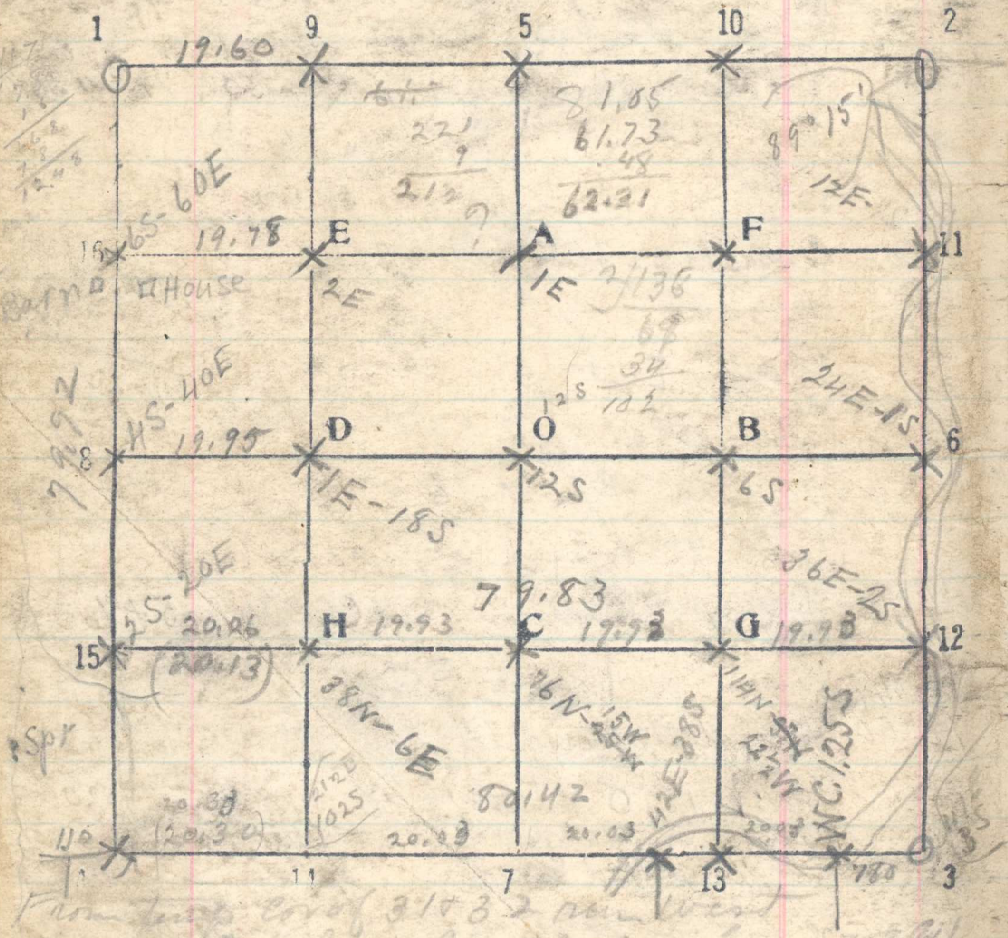

From temp. cor of 31 & 32 run west
Meacham Cr. R.E. comes from S 70° E
Set stake for W.C. 125 lks S. of cor. point
Cross creek S 70° E

19.90 RR. N 45° E 275 lks S. of bridge
20. Set stake for 13-S-31
27.80 Set stake for ¼ cor for sec. 6
28.30 ~~Set flag~~ Meacham Cr. N E.
28.08 Set flag. Base South 10 chs.
+33.65 Angle N 73° 27' W. Dist. cor. 16° 33' x 10 = 33.65
61.73 Flagon hill
79.95 + 48 = 80.43 - Cor of Tps 3N Rs 35 & 36 E. as reestab. by mgr
81.05 C.C. of Tps. 2N Rs. 35 & 36 E, bears S. 138 lks
+.47 This is a stone in M.S. marked with 6 notches S. E. & W.
81.52 Notice of cor of T. 3N Rs. 35 & 36. E. 110 lks
(81.40) E. of this cor. Therefore set stake 110 lks
E. for cor of T 3N Rs. 35 & 36 E,
Thence North bet 31 & 36
15. Gulch N 60° W
20 Set 1/16 cor. (39S 43E) Apr. 11 & 12 1918
40. Set 1/16 cor.
58.50 Barn on line
60.00 Set 1/16 cor.
68.40. RR S 68° E.
69.00 ▽ Base West 5 chs. Angle N 21° 02'
Dist 13.00 + 69.00 = 82.00 chs to flag.
79.92 Cor of 2S, 3D, 31 & 36 [illegible] E [illegible]
July 10 From 11-S-31 run west
20. Set 1/16 cor.
40. Set 1/16 cor.
60. Set 1/16 cor inside of OW R & N R/W
79.78 Intersect 1/16 cor at 16-S-31