


Sec. 11 T. 1 R. 33

Examiner Date 4/18 1918

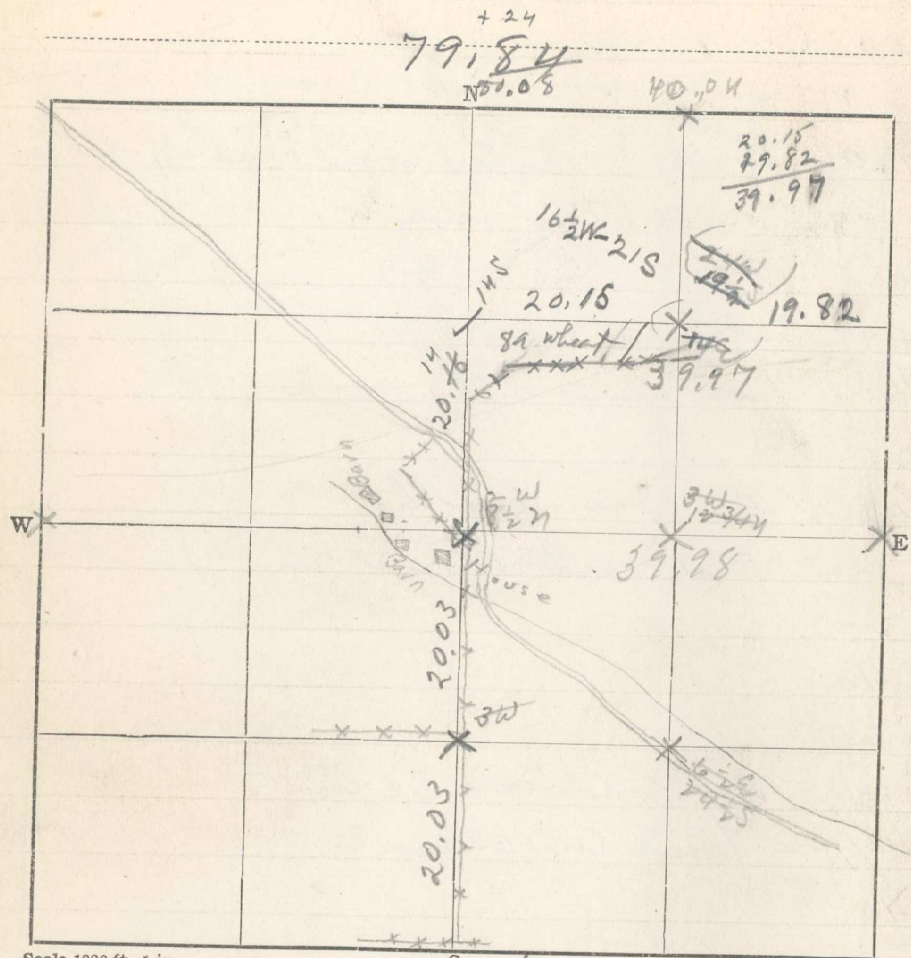

Scale 1320 ft. 1 in.

E from Cr 8 - bought on 8-510

4036 fence put on line - mark post

60

7996 Cr 6 bears N 17 lbs.

S from Cr 10

20

40 Cr 13 bears E 28 lbs.

4/19 - S from Cr 0

20

40 Cr 7 bears W 6 lbs.

W from Cr 12

20

3987 Cr B bears S 49 lbs.

342