


Sec. 14 T. 1 R. 33

Examiner _____ Date 4/29 1918

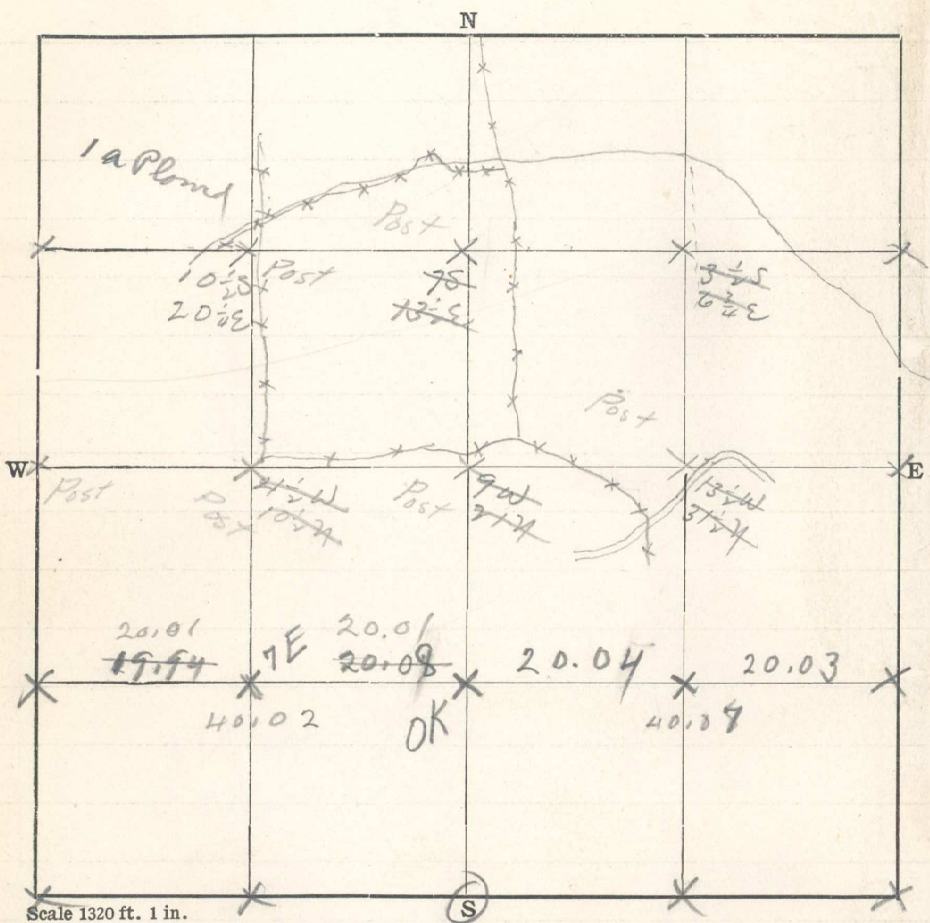

W from Cor 11

20

40

60

5944 fence N & S

7973 Cor 16 bears 5 1/4 lbs

E from Cor 8

20

2065 fence N about 5 lbs

40

60

7982 Cor 6 bears 4 2 lbs

349