10

Sec. 11 T. 1N R. 34E

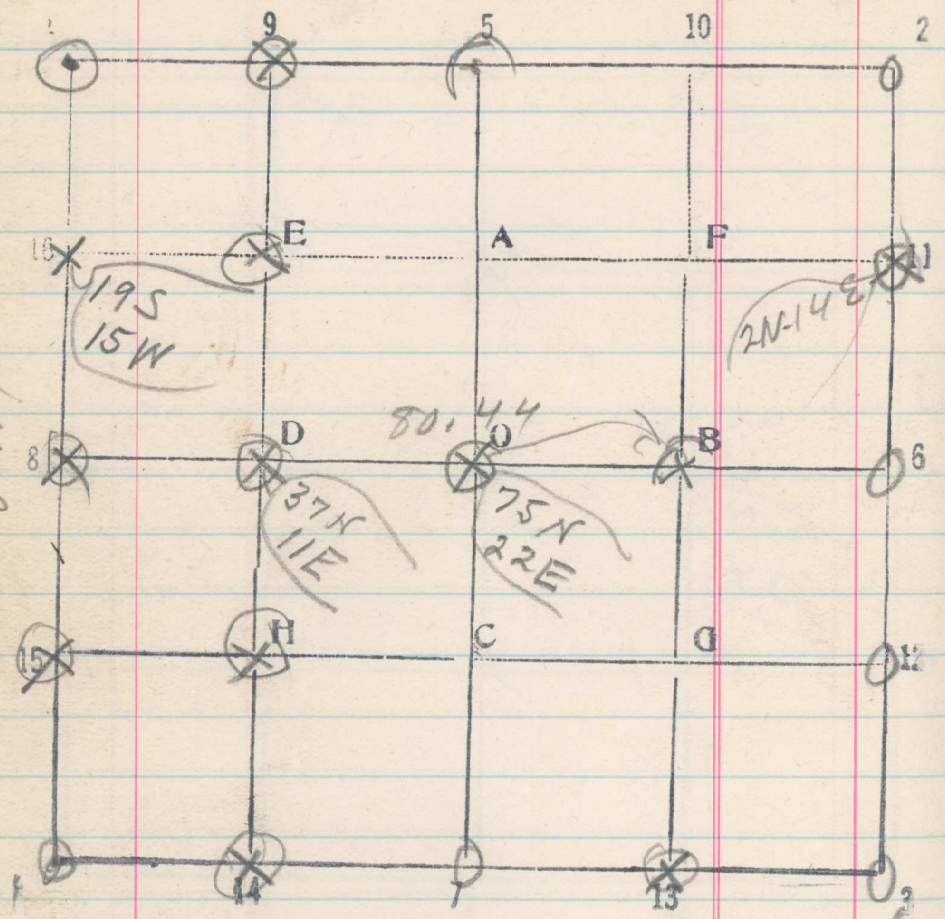

4,128

12 Pnts left at sec. 11

292