


Sec. 28 T. 2 N. R. 35

Examiner _____ Date _____ 19__

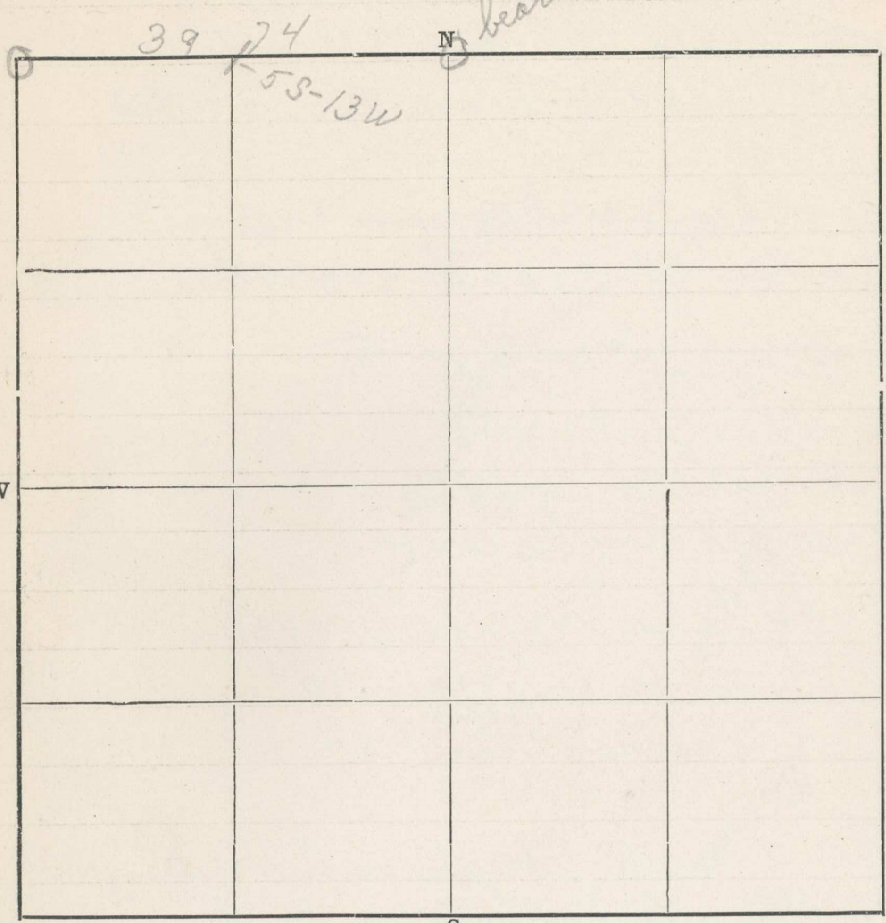

Scale 1320 ft. 1 in.

From cor to sec 20, 21, 28 & 29 Run East
 20.00 Sec 20 1/4 cor 10
 39.74 1/4 cor bet sec 21 & 28 bears S 10 W

379