


Sec. 16 30 T. 31N R. 36E 10

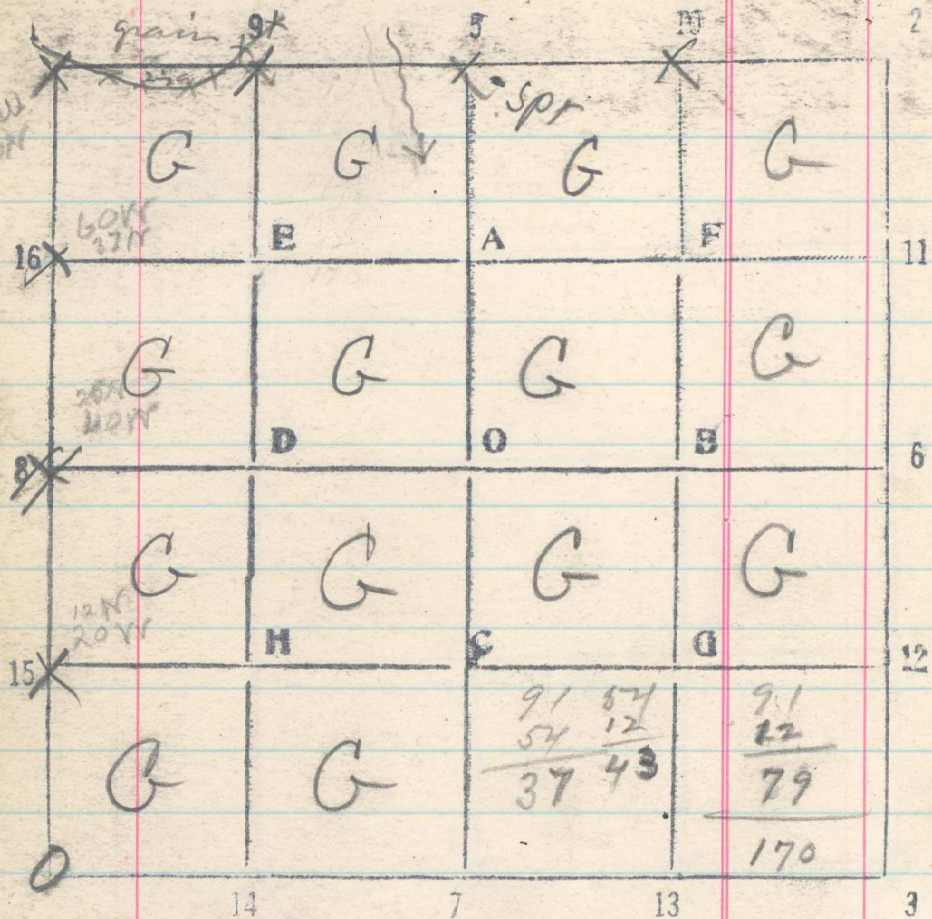

From Temp cov of 19, 24, 25 & 30
at 81.02. continue north
on same line

20 16-S. 30 bears W 54 lbs

39-70 Temp 1/4 cov bet 25 & 30 bears W 91 lbs

East bet recs 19 & 30
20 Set 1/16
40. Set 1/4 cov. Small spring about 250
60 Set 1/6 cov

245