Sec. 34 19 I. 3N 36 E

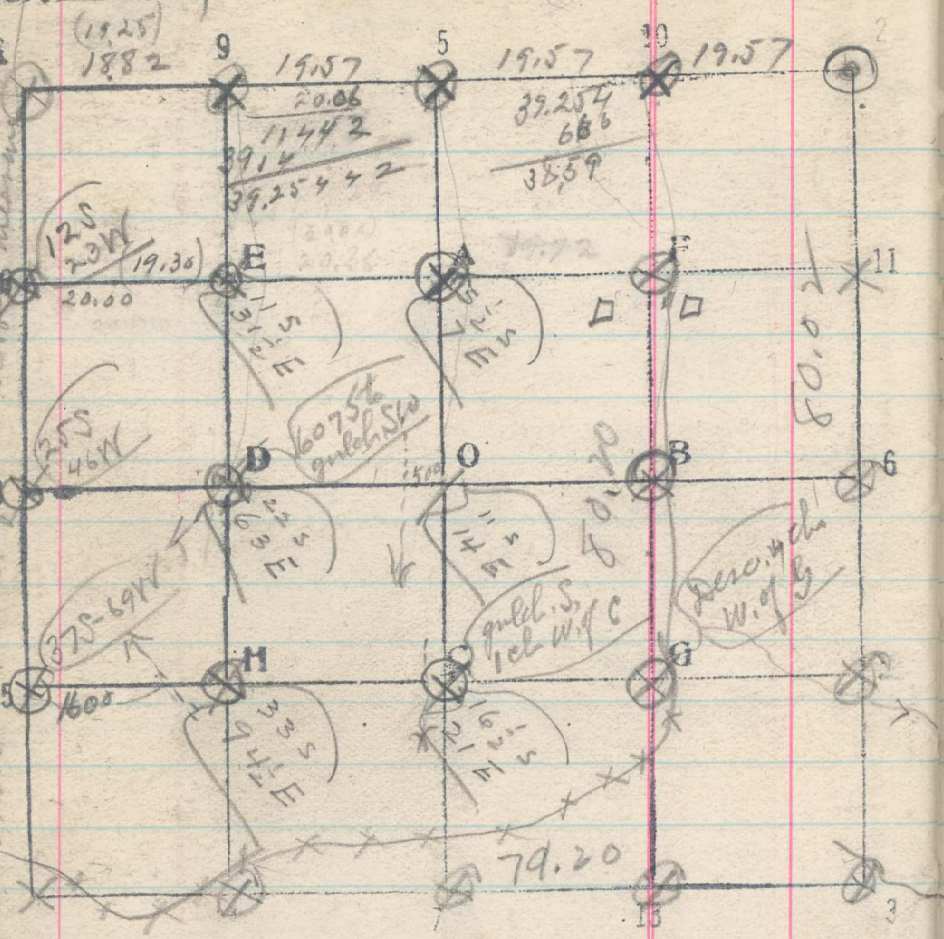

From 16 - S. 19 run East
20.00 Intersect stone marked 1/32, identified by L. L. Rogers as original corner set in ground, with pit West of it, when he first came on ground in 1898.

Tucker says that O.A. Sump [illegible] to Kerr [illegible] acres tillable land on Fine Cross allotment [illegible] measured by [illegible] 50 acres, but [illegible] 20 acres [illegible]

Bill Boyer, works for Rogers, known while E - S.19, was set.

250 125 40 5000 40.36 19.72 60.08 37.57 23 269.80 28 52

40.36 Point for 1/16 cor. A - S.19, located by stumps of two trees, no marks bears S. 8 lks. might be old bearing trees, but nothing certain

60.08 Point for cor F, identified by Lum Pambrun, bears N. 24 lks.

77.52 (79.30) Cor 11 - S. 19, bears S. 180 lks. 1.78 lks short

Sept. 19. From H. old N+S fence bear E. 155 lks
From D old N + S fence bears E. 129 lks.