Sec. 10 T. 1 N 34

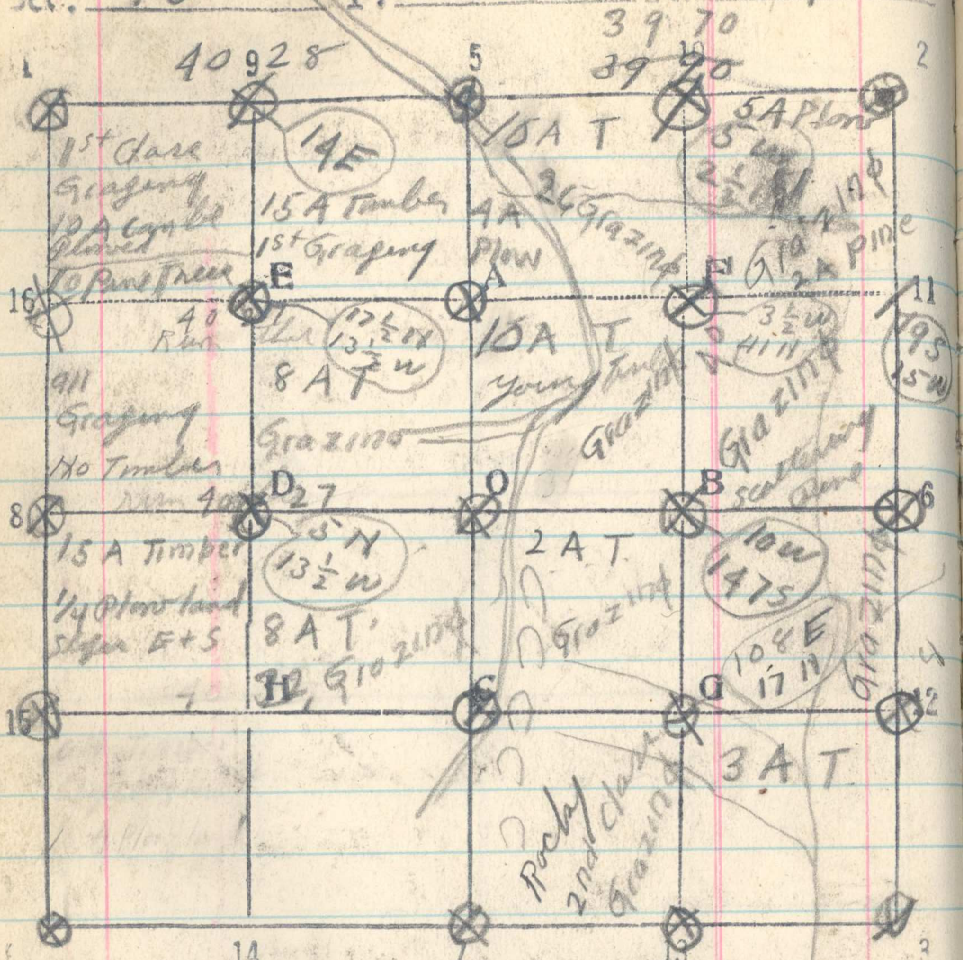

West Through W ¼ from Center

Line 0-8-S-10

20.00 Chs set stake

40.27 Chs ¼ Cor bet 9+10 bears 10 lks N

Friday Nov 22 445

Sec 10

Line 13-B North Through East ¼ bears 216 E

4034 Chs Cor B Sec 10

North from B through NE ¼ sec 10

1500 Chs a Trail follows of ridge old road N 70 E + S 70 W

2000 Chs

3000 Chs Ravine sheds S 70 E

4000

4083 Chs Cor 10 bears 7 lks West

Saturday Nov 23

Line A-16-Sec 10

A Row of Fence Posts Runs N 83° E for 23 chs

Land slopes South good Grazing

2000 set stake

4027 Chs Cor 16-S10 bears 35 lks N

Line 5-2-S-10 East from ¼ Cor

2000 set stake

39.70 Chs Sec Cor bears 14 N